

STATE OF LOUISIANA
DEPARTMENT OF TRANSPORTATION & DEVELOPMENT

SHEET No.

DESCRIPTION	TITLE SHEET	AND LAYOUT MAP
(NOT USED)		
GENERAL NOTES AND SUMMARY OF ESTIMATED QUANTITIES		
MINIMUM CONSTRUCTION SIGNING		
KEY GENERAL PLAN AND ELEVATION		
LULUNG BRIDGE PROFILE		
SPAN 1M AND PLAN LAYOUT		
SPAN 3M AND PLAN LAYOUT		
SPAN 4M & 5M 2004 SOUTHBOUND CONCRETE TEST SECTION S-108 LAYOUT (SOUTH END @ ONRAMP)		
EXISTING 1999 CONCRETE TEST SECTION DETAILS		
EXISTING 1999 CONCRETE TEST SECTION REINFORCED STEEL FABRIC LAYOUT AND SFC FORMING ALLOWANCE		
LAYOUT DIMENSIONS SOUTHBOUND CONCRETE TEST SECTION EXPANSION JOINT SIGNAGE		
EXPANSION JOINT REPAIRS/DETAILS		
E2 UNIT		
MEDIAN BARRIER TEMPORARY COVER PLATE		
NEW E1 CROSS SECTIONS & PLAN VIEWS		
SUPPORT ASSEMBLY SECTIONS AND DETAILS		
TRAFFIC CONTROL SHEETS		

REFERENCE PLANS

ALL INFORMATION CONTAINED HEREIN IS UNCLASSIFIED			
DATE 05-10-2011 BY 60322 UCBAW/BJ			
REASON: 1.5(2)			
AUTHORITY: 25XCFR1.5(2)			
FOUO			
ALL INFORMATION CONTAINED HEREIN IS UNCLASSIFIED			
DATE 05-10-2011 BY 60322 UCBAW/BJ			
REASON: 1.5(2)			
AUTHORITY: 25XCFR1.5(2)			
FOUO			
101-106	S.P. No. 450-37-02	EXPANSION JOINT E1	ORIGINAL PROJECT DRAWINGS
107-109	S.P. No. 450-37-02	EXPANSION JOINT E2	ORIGINAL PROJECT DRAWINGS
110-116	VENDOR SUPPLIED E2	SHOP DRAWINGS E2	SOUTHBOUND
117-126	VENDOR SUPPLIED E2	SHOP DRAWINGS E2	NORTHBOUND

STA. 241+81.50
BEGIN BRIDGE
STRUCTURE #4503700001

C.S. LOG MILE 00.00
STA. 241+80.00
BEGIN S.P. 450-37-0020
BEGIN F.A.P. 450375091

TRAFFIC DATA: 2002 ADT = 35,594

DESIGN SPEED = 70 MPH

SCHEDULE OF REVISIONS

NOTE:

TYPE OF CONSTRUCTION:




F.A.P. No. 4503(509)

E A D NIO 4503(509)

MISSISSIPPI RIVER BRIDGE (LULING)

ST CHARLES PARISH

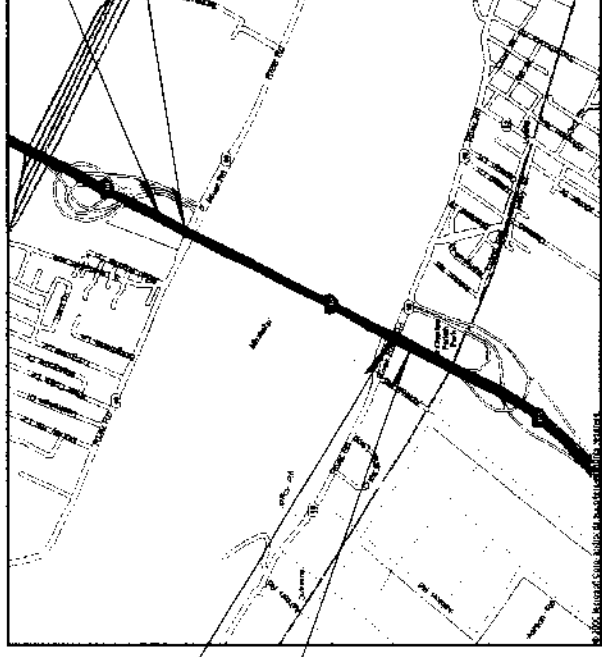

1. AYOIT MAB

LENGTH OF PROJECT

[illegible]

2

[illegible]

MISSISSIPPI RIVER BRIDGE (LULUNG)
DECK TEST SECTION
AND JOINT REPAIRS
TITLE SHEET
AND LAYOUT MAP



HUVAL
ASSOCIATES, INC.
Consulting Engineers

SUMMARY OF ESTIMATED QUANTITIES

SUMMARY OF ESTIMATED QUANTITIES

PAY ITEM	713-01	727-01	731-02	732-02-A	732-03-A	S-101	S-102	S-103	S-104	S-105	S-106	S-107	S-108	S-109	S-110	S-111	S-112	S-113
LOCATION OR DESCRIPTION	TEMPORARY SIGNS AND BARRICADES	MOBILIZATION	REFLECTORIZED RASPED	PLASTIC PAVEMENT STRIPS (SOLID LINE 4" WIDE)	PLASTIC PAVEMENT STRIPS (BROKEN LINE 4" WIDE)	CONSTRUCTION LAYOUT	ASPHALT PAVEMENT REMOVAL (STA 265+53 TO 269+25 SOUTHBOUND)	PMAC DENSE GRADED HOT MIX ASPHALT (STA 265+53 TO 269+25 SOUTHBOUND)	EPoxy UNDERLAYMENT SYSTEM (TYPE "A")	EPoxy UNDERLAYMENT SYSTEM (TYPE "B")	STEEL FIBER REINFORCED CONCRETE	(ITEM NOT USED BY THIS PROJECT)	SAW CUT & SEAL PMAC	ASPHALT PAVEMENT REMOVAL (GENERAL OPEN ROADWAYS)	PMAC DENSE GRADED HOT MIX ASPHALT (GENERAL OPEN ROADWAYS)	REPAIR E2 EXPANSION JOINT (STA 269+25)	REPLACE E1 S.B. EXPANSION JOINT (STA 241+80)	REPLACE E1 N.B. EXPANSION JOINT (STA 241+80)
UNIT OF PAY	LUMP	LUMP	EACH	WIDE	WIDE	LUMP	SO. YD.	TON	SO. FT.	SO. FT.	CU. YD.		LIN. FT.	SO. YD.	SO. YD.	LUMP	LUMP	LUMP
TOTAL QUANTITY	LUMP	LUMP	160	1.110	0.070	LUMP	1.581	131.8	7.986	4.330	82.22		4,846	60	60	LUMP	LUMP	LUMP

** THE SPECIAL PROVISIONS WILL SPECIFY THE FINAL MIX/FORMULATION/SPECIFICATIONS TO BE USED.

GENERAL NOTES

(SEE SPECIAL PROVISIONS FOR ADDITIONAL DETAILS & INFORMATION)

PROJECT SCOPE
THIS PROJECT CONSISTS OF WORK TO BE PERFORMED ON THE I-310 LULING BRIDGE OVER THE MISSISSIPPI RIVER NORTH OF NEW ORLEANS, LOUISIANA. THE FOLLOWING ARE THE MAJOR WORK EFFORTS OF THE PROJECT:

- 1- REMOVE EXISTING ASPHALTIC PAVEMENT AND CLEAN THE STEEL DECK PLATE AREA.
- 2- SURFACE PREPARE AND INSTALL EPOXY UNDERLAYMENT SYSTEMS.
- 3- INSTALL POLYMER MODIFIED ASPHALTIC CONCRETE (PMAC) PAVEMENT.
- 4- PROVIDE SAW CUT AND SEAL IN PMAC SECTIONS.
- 5- REPAIR EXISTING BRIDGE END EXPANSION JOINTS (EAST BANK).
- 6- REMOVE & REPLACE EXISTING EXPANSION JOINTS (EAST BANK).
- 7- REMOVE & REPLACE EXISTING EXPANSION JOINTS (WEST BANK).

ITEM S-102 ASPHALT PAVEMENT REMOVAL (STA 265+53 TO 269+25 SOUTHBOUND)
EXISTING ASPHALT PAVEMENT IN THE SOUTHBOUND ROADWAY FROM NORTH BRIDGE END AT STA. 265+53 TO STA. 269+25 IS TO BE COMPLETELY REMOVED FULL ROADWAY DECK WIDTH (38'-3"). FINAL DECK CLEANING WILL BE BY ULTRA HIGH PRESSURE (>20,000PSI) PORTABLE WATER WASHING & RECOVERY TO REMOVE THE FINAL TRACES OF ASPHALTIC TACK COAT AND PAVEMENT MATERIAL. EXISTING BOLT HEADS DAMAGED BY THE ASPHALT REMOVAL OPERATION OR BOLTS FOUND MISSING OR DAMAGED WILL BE REPLACED UNDER THIS PAY ITEM.

ITEM S-103 PMAC DENSE GRADED HOT MIX ASPHALT
POLYMER MODIFIED ASPHALTIC CONCRETE (PMAC) DENSE GRADED HOT MIX ASPHALT WILL BE SUPPLIED AND INSTALLED PER THE LOCATIONS AND DIMENSIONS IN THE PLANS AND ACCORDING TO THE SPECIFICATIONS. PMAC INSTALLED UNDER PAY ITEM S-103 IN THE FULL ROADWAY WIDTH TRAFFIC LANES FROM STA. 265+53 TO STA. 269+25 WILL BE INSTALLED IN A MINIMUM OF TWO EQUAL LIFTS. PMAC INSTALLED UNDER PAY ITEM S-103 IN THE INSIDE AND OUTSIDE SHOULDER AREAS MAY BE INSTALLED AS ONE TOTAL REQUIRED THICKNESS LIFT AT CONTRACTOR'S OPTION. MINIMUM ACCEPTABLE FINAL INSTALLED PMAC DENSITY WILL BE 92% OF THE AVERAGE THEORETICAL MAXIMUM DENSITY FOR EITHER INSTALLATION METHOD USED/ALLOWED.

ITEM S-104 EPOXY UNDERLAYMENT SYSTEM (TYPE "A")
TYPE "A" EPOXY UNDERLAYMENT SYSTEM IS DEFINED AS A FIVE LAYER COMPLETE EPOXY UNDERLAYMENT SYSTEM CONSISTING OF A SHOT BLASTED STEEL DECK PLATE SURFACE PREPARATION FOLLOWED BY AN EPOXY COATING FOLLOWED BY A LAYER OF GLASS FABRIC FOLLOWED BY AN EPOXY LAYER FOLLOWED BY A SPRINKLING OF GRANITE CHIPS FOLLOWED BY A FINAL COATING OF EPOXY. THIS SYSTEM IS PLANNED TO BE INSTALLED UNDER THE SFRIC TEST SECTIONS LIMITED TO BETWEEN THE EXISTING LONGITUDINAL DECK SPLICE PLATES WHERE THE NEW SFRIC TEST SECTION WILL BE PLACED AND ONLY FROM STA. 266+03 TO STA. 269+25.

ITEM S-105 EPOXY UNDERLAYMENT SYSTEM (TYPE "B")
TYPE "B" EPOXY UNDERLAYMENT SYSTEM IS DEFINED AS AN EPOXY UNDERLAYMENT SYSTEM CONSISTING OF A SHOT BLASTED STEEL DECK PLATE SURFACE PREPARATION FOLLOWED BY AN EPOXY COATING FOLLOWED BY A SPRINKLING OF GRANITE CHIPS FOLLOWED BY A FINAL COATING OF EPOXY. THIS SYSTEM IS PLANNED TO BE INSTALLED UNDER THE EXISTING LONGITUDINAL AND TRANSVERSE DECK SPLICE PLATES AND THE STEEL DECK AREAS OUTSIDE THE EXISTING LONGITUDINAL DECK SPLICE PLATES IN THE SHOULDER AREAS WHERE NEW PMAC WILL BE PLACED AND ONLY FROM STA. 266+03 TO STA. 269+25.

ITEM S-109 ASPHALT PAVEMENT REMOVAL (GENERAL OPEN ROADWAYS)
EXISTING ASPHALT PAVEMENT IN THE SOUTHBOUND AND NORTHBOUND ROADWAYS IS TO BE COMPLETELY REMOVED AND THE DECK STEEL PLATE CLEANED AT THE LOCATIONS AND PER THE MINIMUM DIMENSIONS SET OUT IN THE PLANS AND AS MAY BE DIRECTED BY ENGINEER. AT CONTRACTOR'S OPTION, FINAL DECK CLEANING OF THESE REPAIR AREAS WILL BE BY ALLOWED MECHANICAL MEANS OR BY ULTRA HIGH PRESSURE (>20,000PSI) PORTABLE WATER WASHING & RECOVERY TO REMOVE THE FINAL TRACES OF ASPHALTIC TACK COAT AND PAVEMENT MATERIAL. DEGREE OF CLEANLINESS OR ASPHALTIC REMOVAL - FOR THIS PAY ITEM ONLY (IF MECHANICAL CLEANING UTILIZED) - WILL BE COMPLETE REMOVAL OF ALL LOOSE AND/OR UNBOUND ASPHALTIC TACK COAT OR PAVEMENT MATERIAL, AND ANY SECURELY BONDED ASPHALTIC PAVEMENT OVER 1/2" THICK. EXISTING BOLT HEADS DAMAGED BY THE ASPHALT REMOVAL OPERATION OR BOLTS FOUND MISSING OR DAMAGED WILL BE REPLACED UNDER THIS PAY ITEM.

ITEM S-110 PMAC DENSE GRADED HOT MIX ASPHALT
POLYMER MODIFIED ASPHALTIC CONCRETE (PMAC) DENSE GRADED HOT MIX ASPHALT WILL BE SUPPLIED AND INSTALLED PER THE LOCATIONS AND DIMENSIONS IN THE PLANS AND ACCORDING TO THE SPECIFICATIONS. PMAC INSTALLED UNDER PAY ITEM S-110 WILL BE INSTALLED IN A MINIMUM OF TWO EQUAL LIFTS FOR PMAC INSTALLED IN REPAIR AREAS GREATER THAN TEN FEET IN WIDTH AND LONGER THAN TWENTY FEET IN LENGTH - 200 SQUARE FEET. AT CONTRACTOR'S OPTION, REPAIR AREAS LESS THAN TWENTY SQUARE YARDS MAY BE PLACED IN A SINGLE LIFT. ALL PLACED PMAC IN REPAIR AREAS WILL HAVE PLACEMENT THICKNESS THAT MATCH PERIMETER ADJACENT EDGES AND BE UNIFORM IN TOTAL PLACEMENT AND TIE-IN THICKNESS. MINIMUM ACCEPTABLE FINAL INSTALLED PMAC DENSITY WILL BE 92% OF THE AVERAGE THEORETICAL MAXIMUM DENSITY FOR EITHER INSTALLATION METHOD USED/ALLOWED.

ITEM S-111 REPAIR E2 EXPANSION JOINT (STA 269+25)
EXISTING EXPANSION JOINTS E2 IN THE SOUTHBOUND AND NORTHBOUND ROADWAYS ARE TO BE REFURBISHED PER THE PLANS AND SPECIFICATIONS WITH REPLACEMENT PIECES AND COMPONENTS SUPPLIED BY THE ORIGINAL MANUFACTURER WATSON-BOWMAN. WORK ON THIS PAY ITEM MAY BE SCHEDULED AT ANY TIME DURING THE ALLOWED CONTRACT TIME AND INDEPENDENT OR CONCURRENT TO PLANNED UNDERSIDE OR NORTHBOUND ROADWAY WORK. MOST REPAIR WORK CAN BE EXECUTED FROM THE DECK UNDERSIDE. HOWEVER, CONTRACTOR MAY MONOPOLIZE ON ALLOWED LANE AND/OR ROADWAY CLOSURES TO EXECUTE OR COMPLETE SOME OF THIS REPAIR WORK FROM ABOVE THE DECK PROVIDED THIS DECK PRESENCE IS WITHIN THE CLOSURE ALLOWANCES FOR THE SFRIC OR E1 WORK.

NO SPECIFIC, SPECIAL, OR EXTRA ROADWAY LANE OR TOTAL ROADWAY CLOSURES ARE PLANNED OR BEING ALLOWED FOR ANY E2 EXPANSION JOINT REPAIRS. ANY SUCH REPAIR EFFORT REQUIRING SUCH CLOSURES MUST BE SCHEDULED BY CONTRACTOR CONCURRENT WITH THE CLOSURE ALLOWANCES BEING ALLOWED FOR SOUTHBOUND SFRIC OR NORTHBOUND E1 WORK.

LUMP SUM WORK AND SUPPLY SCOPE IS DELINEATED IN THE PLANS FOR EACH JOINT - NORTHBOUND & SOUTHBOUND.

GENERAL REPAIR WORK ITEMS CONSIST OF:

- 1- REPLACING RAIL CONTROL SPRINGS & DOWELS.
- 2- RE-POSITIONING/ROTATING/REPLACING BEARINGS.
- 3- RE-POSITIONING/ROTATING/REPLACING BEARINGS.
- 4- RE-POSITIONING/ROTATING/REPLACING BEARINGS.
- 5- RE-POSITIONING/ROTATING/REPLACING JOINT SEALS.

GENERAL NOTE - EXPANSION JOINT WORK UNDER S-111, S-112, & S-113
PARTIAL PAYMENT FOR THESE LUMP SUM ITEMS ALLOCATED BETWEEN INSIDE AND OUTSIDE LANE COMPLETED REPLACEMENT WORK OR NORTHBOUND AND SOUTHBOUND REPAIR WORK WILL BE BASED ON PROPORTIONAL NOMINAL INSTALLED LENGTHS & SEALS FOR E1 WORK (SEE SPECIAL PROVISIONS) AND SPLT 50%/50% FOR E2 WORK.

ITEM S-112 REPLACE E1 S.B. EXPANSION JOINT (STA 241+80)
EXISTING JOINT IS TO BE REMOVED, THE RECEIVING AREA OF BRIDGE END AND APPROACH IS TO BE MODIFIED, AND A WATSON-BOWMAN MAURER TYPE EXPANSION JOINT SUPPLIED AND INSTALLED. SOUTHBOUND LANE AND ROADWAY CLOSURES REQUIRED BY THIS WORK ITEM WILL BE SCHEDULED CONCURRENT WITH THAT ALLOWED FOR THE SFRIC INSIDE LANE WORK WITH LANE CLOSURE TRAFFIC DELINEATORS EXTENDING FULL BRIDGE LENGTH INTO THE E1 WORK ZONE AS AN EXTENSION OF THE LANE CLOSURE TRAFFIC CONTROLS FOR THE SFRIC WORK. ADDITIONALLY, TEMPORARY CONCRETE BARRIERS WILL BE PLACED ON THE ROADWAY DECK TO PROVIDE THE NECESSARY SAFETY PROTECTION FOR WORKERS AND THE TRAVELING PUBLIC DUE TO THE TEMPORARY OPEN DECK AREA REQUIRED BY THE WORK. NO TRAFFIC LANE SHIFTS WILL BE ALLOWED ON THE BRIDGE.

REMOVAL AND REPLACEMENT OF SOUTHBOUND E1 WILL REQUIRE THE TEMPORARY REMOVAL OF THE MEDIAN BARRIER PLATE THAT WILL EXPOSE THE NORTHBOUND INSIDE LANE E1 WORK CONCURRENT TO THIS E1 CONTRACTOR ELECTS TO EXECUTE THE NORTHBOUND INSIDE LANE E1 WORK CONCURRENT TO THIS E1 SOUTHBOUND INSIDE LANE WORK. CONTRACTOR WILL HAVE TO SUBMIT FOR REVIEW AND APPROVAL AND PROVIDE FOR THE TEMPORARY COVERING/CLOSURE OF THE NORTHBOUND SIDE OF THE MEDIAN BARRIER COVER PLATE REMOVAL. NO TRAFFIC WILL BE ALLOWED IN A LANE ADJACENT TO A DISCONTINUOUS STEEL BARRIER - SEE SPECIAL PROVISIONS FOR ALLOWANCE DETAILS, TIMING, DURATION, ETC....

CONTRACTOR WILL BE ALLOWED TO INSTALL OPEN JOINT ASSEMBLIES (NO SEALS) AND ALLOWED TO PLACE TRAFFIC ON CURBED AND ACCEPTABLE OPEN JOINT INSTALLATIONS PENDING THE FINAL INSTALLATION OF THE CONTINUOUS NEOPRENE STRIP SEALS.

ITEM S-113 REPLACE E1 N.B. EXPANSION JOINT (STA 241+80)
EXISTING JOINT IS TO BE REMOVED, THE RECEIVING AREA OF BRIDGE END AND APPROACH IS TO BE MODIFIED, AND A WATSON-BOWMAN MAURER TYPE EXPANSION JOINT SUPPLIED AND INSTALLED. NORTHBOUND LANE CLOSURES REQUIRED BY THIS WORK ITEM CAN BE SCHEDULED AT ANY TIME WITHIN THE CONTRACT TIME. TEMPORARY CONCRETE BARRIERS WILL BE PLACED ON THE ROADWAY DECK IN THE E1 WORK ZONE TO PROVIDE THE NECESSARY SAFETY PROTECTION FOR WORKERS AND THE TRAVELING PUBLIC DUE TO THE TEMPORARY OPEN DECK AREA REQUIRED BY THE WORK. PMAC AREA REPAIR WORK AND ANY ABOVE DECK WORK REQUIRED FOR E2 REPAIRS WILL BE PLANNED AND SCHEDULED CONCURRENT WITH THAT ALLOWED FOR E1 WORK WITH LANE CLOSURE TRAFFIC DELINEATORS EXTENDING FULL BRIDGE LENGTH INTO THE PMAC OR E2 WORK ZONE AS AN EXTENSION OF THE LANE CLOSURE TRAFFIC CONTROLS INSTALLED FOR THE E1 WORK. NO TRAFFIC LANE SHIFTS OR DISCONTINUOUS TRAFFIC DELINEATORS WILL BE ALLOWED ON THE BRIDGE - SEE SPECIAL PROVISIONS FOR ALLOWANCE DETAILS, TIMING, DURATION, ETC....

CONTRACTOR WILL BE ALLOWED TO INSTALL OPEN JOINT ASSEMBLIES (NO SEALS) AND ALLOWED TO PLACE TRAFFIC ON CURBED AND ACCEPTABLE OPEN JOINT INSTALLATIONS PENDING THE FINAL INSTALLATION OF THE CONTINUOUS NEOPRENE STRIP SEALS.

2/25/04

WORK SEQUENCE AND LANE CLOSURE ALLOWANCES

SOUTHBOUND:
THE PROJECT WILL ALLOW LANE CLOSURES AND TRAFFIC FLOW ALTERATIONS FOR WORK IN/ON THE SOUTHBOUND ROADWAY ASSOCIATED ONLY WITH THE INSTALLATION OF THE SFRIC CONCRETE TEST SECTIONS. IT IS THE INTENT OF THESE PLANS AND SPECIFICATIONS THAT THE CONTRACTOR PLAN AND SCHEDULE ANY OTHER REQUIRED SOUTHBOUND ROADWAY WORK THAT WOULD NORMALLY ALSO REQUIRE TRAFFIC FLOW DISRUPTIONS TO COINCIDE WITH THE ALLOWED TRAFFIC DISRUPTIONS ASSOCIATED WITH THE INSTALLATION OF THE CONCRETE TEST SECTIONS. ADDITIONAL SOUTHBOUND ROADWAY WORK SUCH AS AREA PMAC REPAIRS, SAW CUTTING AND SEALING, PAVEMENT MARKINGS, WORK ASSOCIATED WITH THE REPAIRS TO THE E2 EXPANSION JOINT, WORK ASSOCIATED WITH THE REPLACEMENT OF THE E1 JOINT, AND ANY OTHER SOUTHBOUND ROADWAY WORK REQUIRED MUST BE PLANNED AND SCHEDULED ACCORDINGLY - NO OTHER SEPARATE LANE CLOSURES WILL BE ALLOWED.

TWENTY-EIGHT (28) CALENDAR DAYS OF SINGLE LANE CLOSURES WILL BE ALLOWED FOR THE CONCRETE TEST SECTION WORK IN THE SOUTHBOUND ROADWAY. THE FIRST PORTION OF THIS ALLOWED ONE LANE CLOSURE AND TRAFFIC DIVERSION PERIOD WILL BE FOR CONSTRUCTION IN THE SOUTHBOUND INSIDE LANE WITH THE LAST PORTION FOR CONSTRUCTION IN THE SOUTHBOUND OUTSIDE LANE.

THE PROJECT WILL ALSO ALLOW TWO FULL CLOSURES OF THE SOUTHBOUND ROADWAY INTENDED FOR THE ACTUAL PLACEMENT/INSTALLATION OF THE STEEL FIBER REINFORCED CONCRETE - ONE CLOSURE FOR EACH LANE WORK EFFORT. CONTRACTOR WILL BE ABLE TO SCHEDULE THESE FULL ROADWAY CLOSURES - SEE ALLOWANCES WITHIN THE PERIODS ALLOWED BY THE SPECIAL PROVISIONS FOR ROADWAY CLOSURES - SPECIAL PROVISIONS FOR ALLOWANCE DETAILS, TIMING, DURATION, ETC....


NORTHBOUND
TWENTY (20) CALENDAR DAYS OF SINGLE LANE CLOSURES WILL BE ALLOWED FOR E1 REPLACEMENT WORK IN THE NORTHBOUND ROADWAY AND MAY BE SCHEDULED CONCURRENT, INDEPENDENT, AND/OR SEPARATE FROM THE ALLOWED TRAFFIC CLOSURES IN THE SOUTHBOUND ROADWAY. ROADWAY PMAC REPAIR WORK AND ANY ABOVE DECK WORK REQUIREMENTS ASSOCIATED WITH THE NORTHBOUND E2 REPAIRS MUST BE SCHEDULED TO COINCIDE WITH THE ALLOWED E1 LANE CLOSURES - SEE SPECIAL PROVISIONS FOR ALLOWANCE DETAILS, TIMING, DURATION, ETC....


E2 EXPANSION JOINT REPAIRS
WORK ON THIS PAY ITEM MAY BE SCHEDULED AT ANY TIME DURING THE ALLOWED CONTRACT TIME AND INDEPENDENT OR CONCURRENT TO ANY PLANNED SOUTHBOUND OR NORTHBOUND ROADWAY WORK. NO SPECIFIC, SPECIAL, OR EXTRA ROADWAY LANE OR TOTAL ROADWAY CLOSURES ARE PLANNED OR BEING ALLOWED FOR ANY E2 EXPANSION JOINT REPAIRS. ANY SUCH REPAIR EFFORT REQUIRING SUCH CLOSURES MUST BE SCHEDULED BY CONTRACTOR CONCURRENT WITH THE CLOSURE ALLOWANCES BEING ALLOWED FOR SOUTHBOUND SFRIC AND/OR NORTHBOUND E1 WORK. CLOSURES OF THE NORTHBOUND OUTSIDE SHOULDER DURING THE DAYLIGHT ARE ALLOWED FOR WORKER ACCESS TO THE E2 DECK UNDERSIDE AREA. HOWEVER, SUCH SHOULDER CLOSURES ARE NOT ALLOWED AT NIGHT OR COINCIDENT WITH A NORTHBOUND INSIDE LANE CLOSURE PRECIPITATED BY E1 INSIDE LANE WORK.


TRAFFIC CONTROL & CLEAR ACCESS
DUE TO THE SMALL VOLUMES OF PMAC REQUIRED TO REPAIR THE NORTHBOUND OPEN ROADWAY AREAS, THAT WORK MIGHT BEST BE PLANNED TO COINCIDE WITH THE PRODUCTION AND DELIVERY OF PMAC REQUIRED FOR EITHER OF THE SOUTHBOUND LANES. CONSTRUCTION MATERIAL OR EQUIPMENT WILL NOT BE LEFT UNATTENDED OR ALLOWED TO REMAIN ON THE NORTHBOUND ROADWAY BEYOND THE E1 WORK ZONE WHEN WORKERS ARE NOT PRESENT IN THE NORTHBOUND ROADWAY WORK AREA. CERTAIN TEMPORARY TRAFFIC CONTROL DEVICES FOR THIS EXTENSION OF THE NORTHBOUND LANE CLOSURE FOR PMAC WORK, WITH PRIOR APPROVAL FROM THE ENGINEER, MAY BE ALLOWED TO REMAIN "STORED" ON THE OUTSIDE SHOULDER FOR A LIMITED PRE-APPROVED TIME.


THE PROJECT WILL ALSO ALLOW UP TO A MAXIMUM OF FOUR (4) FIFTEEN (15) MINUTE TEMPORARY FULL ROADWAY CLOSURES FOR REPOSITIONING/DEPLOYING TRAFFIC CONTROL DEVICES TO PROVIDE A SHIFT IN THE TRAFFIC FLOW PATTERN IN EACH OF THE SOUTHBOUND OR NORTHBOUND ROADWAYS WITH SUCH SHIFTS OCCURRING AHEAD OF E2 IN THE SOUTHBOUND ROADWAY AND E1 IN THE NORTHBOUND ROADWAY AND SUCH TEMPORARY CLOSURES EXECUTED UNDER POLICE PRESENCE AND CONTROL - SEE SPECIAL PROVISIONS FOR ALLOWANCE DETAILS, TIMING, DURATION, ETC....

ALL COSTS ASSOCIATED WITH POLICE PRESENCE OR REQUIREMENTS FOR THIS PROJECT EITHER AS SO NOTED IN THESE PLANS AND SPECIFICATIONS OR AS SO REQUIRED BY CONTRACTORS EXECUTION PLANS AND SCHEDULE WILL BE INCLUDED IN AND PROVIDED FOR UNDER ITEM 713-01 TEMPORARY SIGNS AND BARRICADES. THERE WILL BE NO ADDITIONAL COMPENSATION SPECIFICALLY FOR ANY POLICE PROJECT PRESENCE OR COVERAGE.

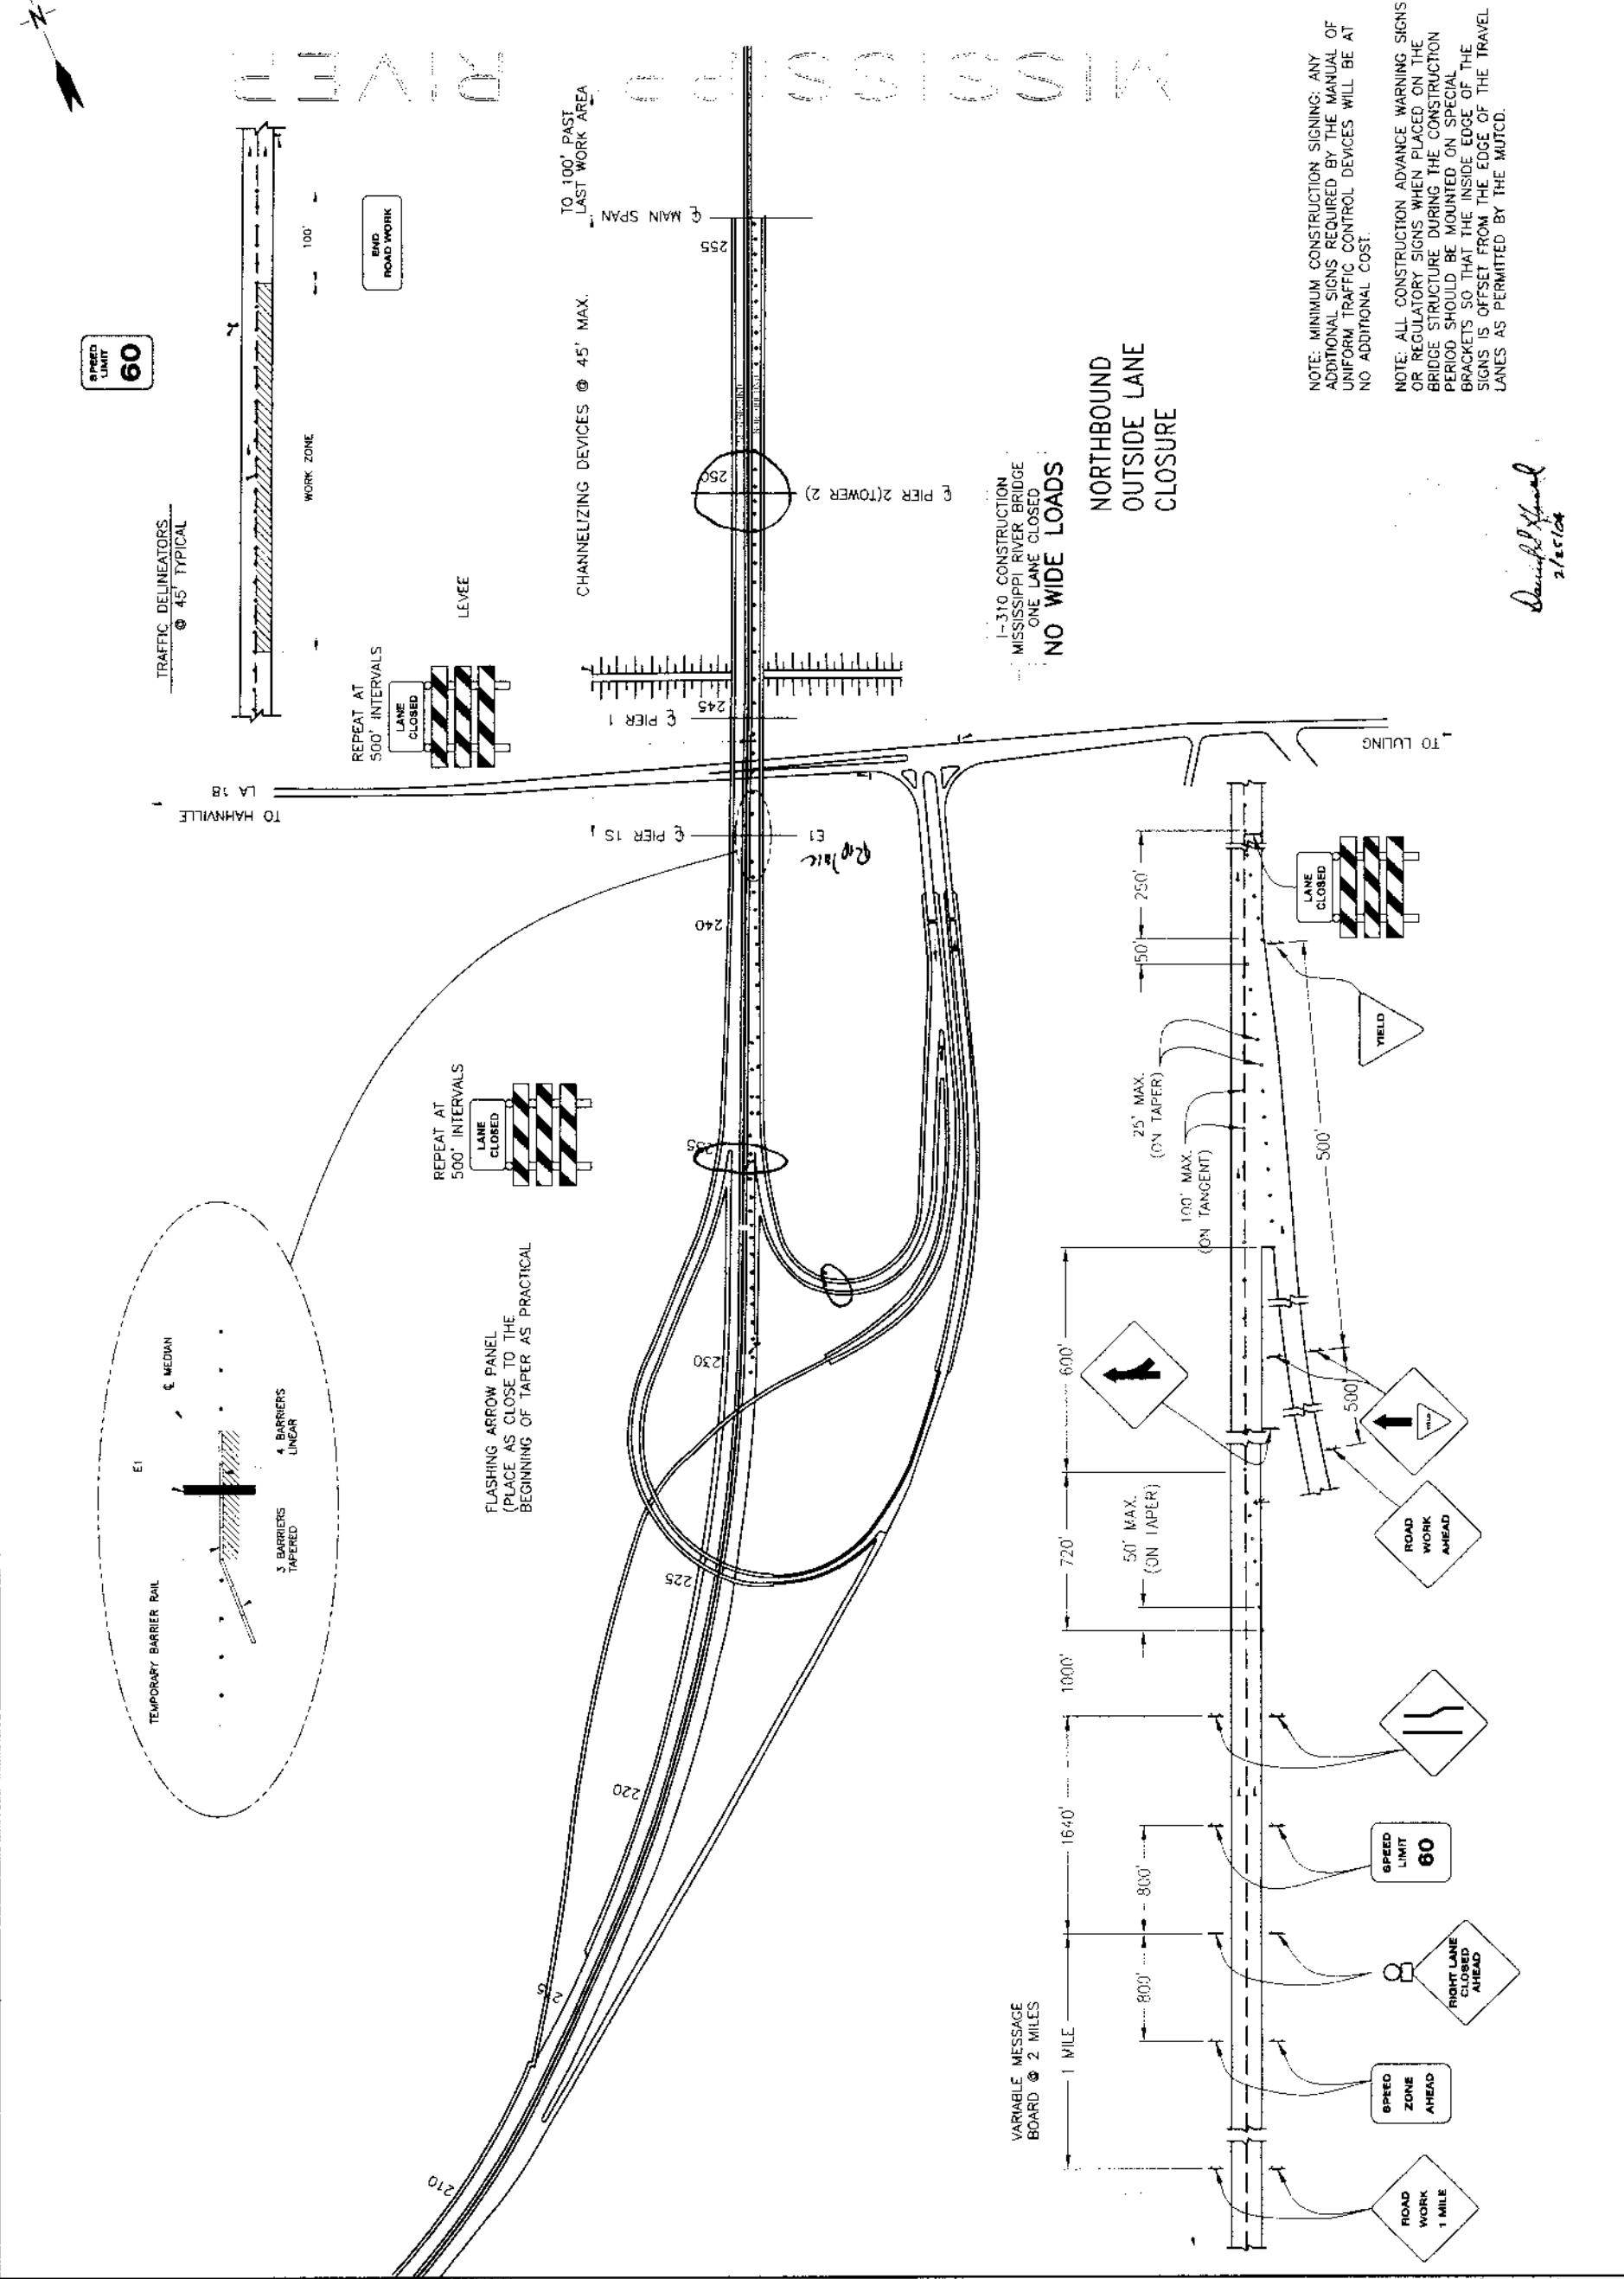[illegible]


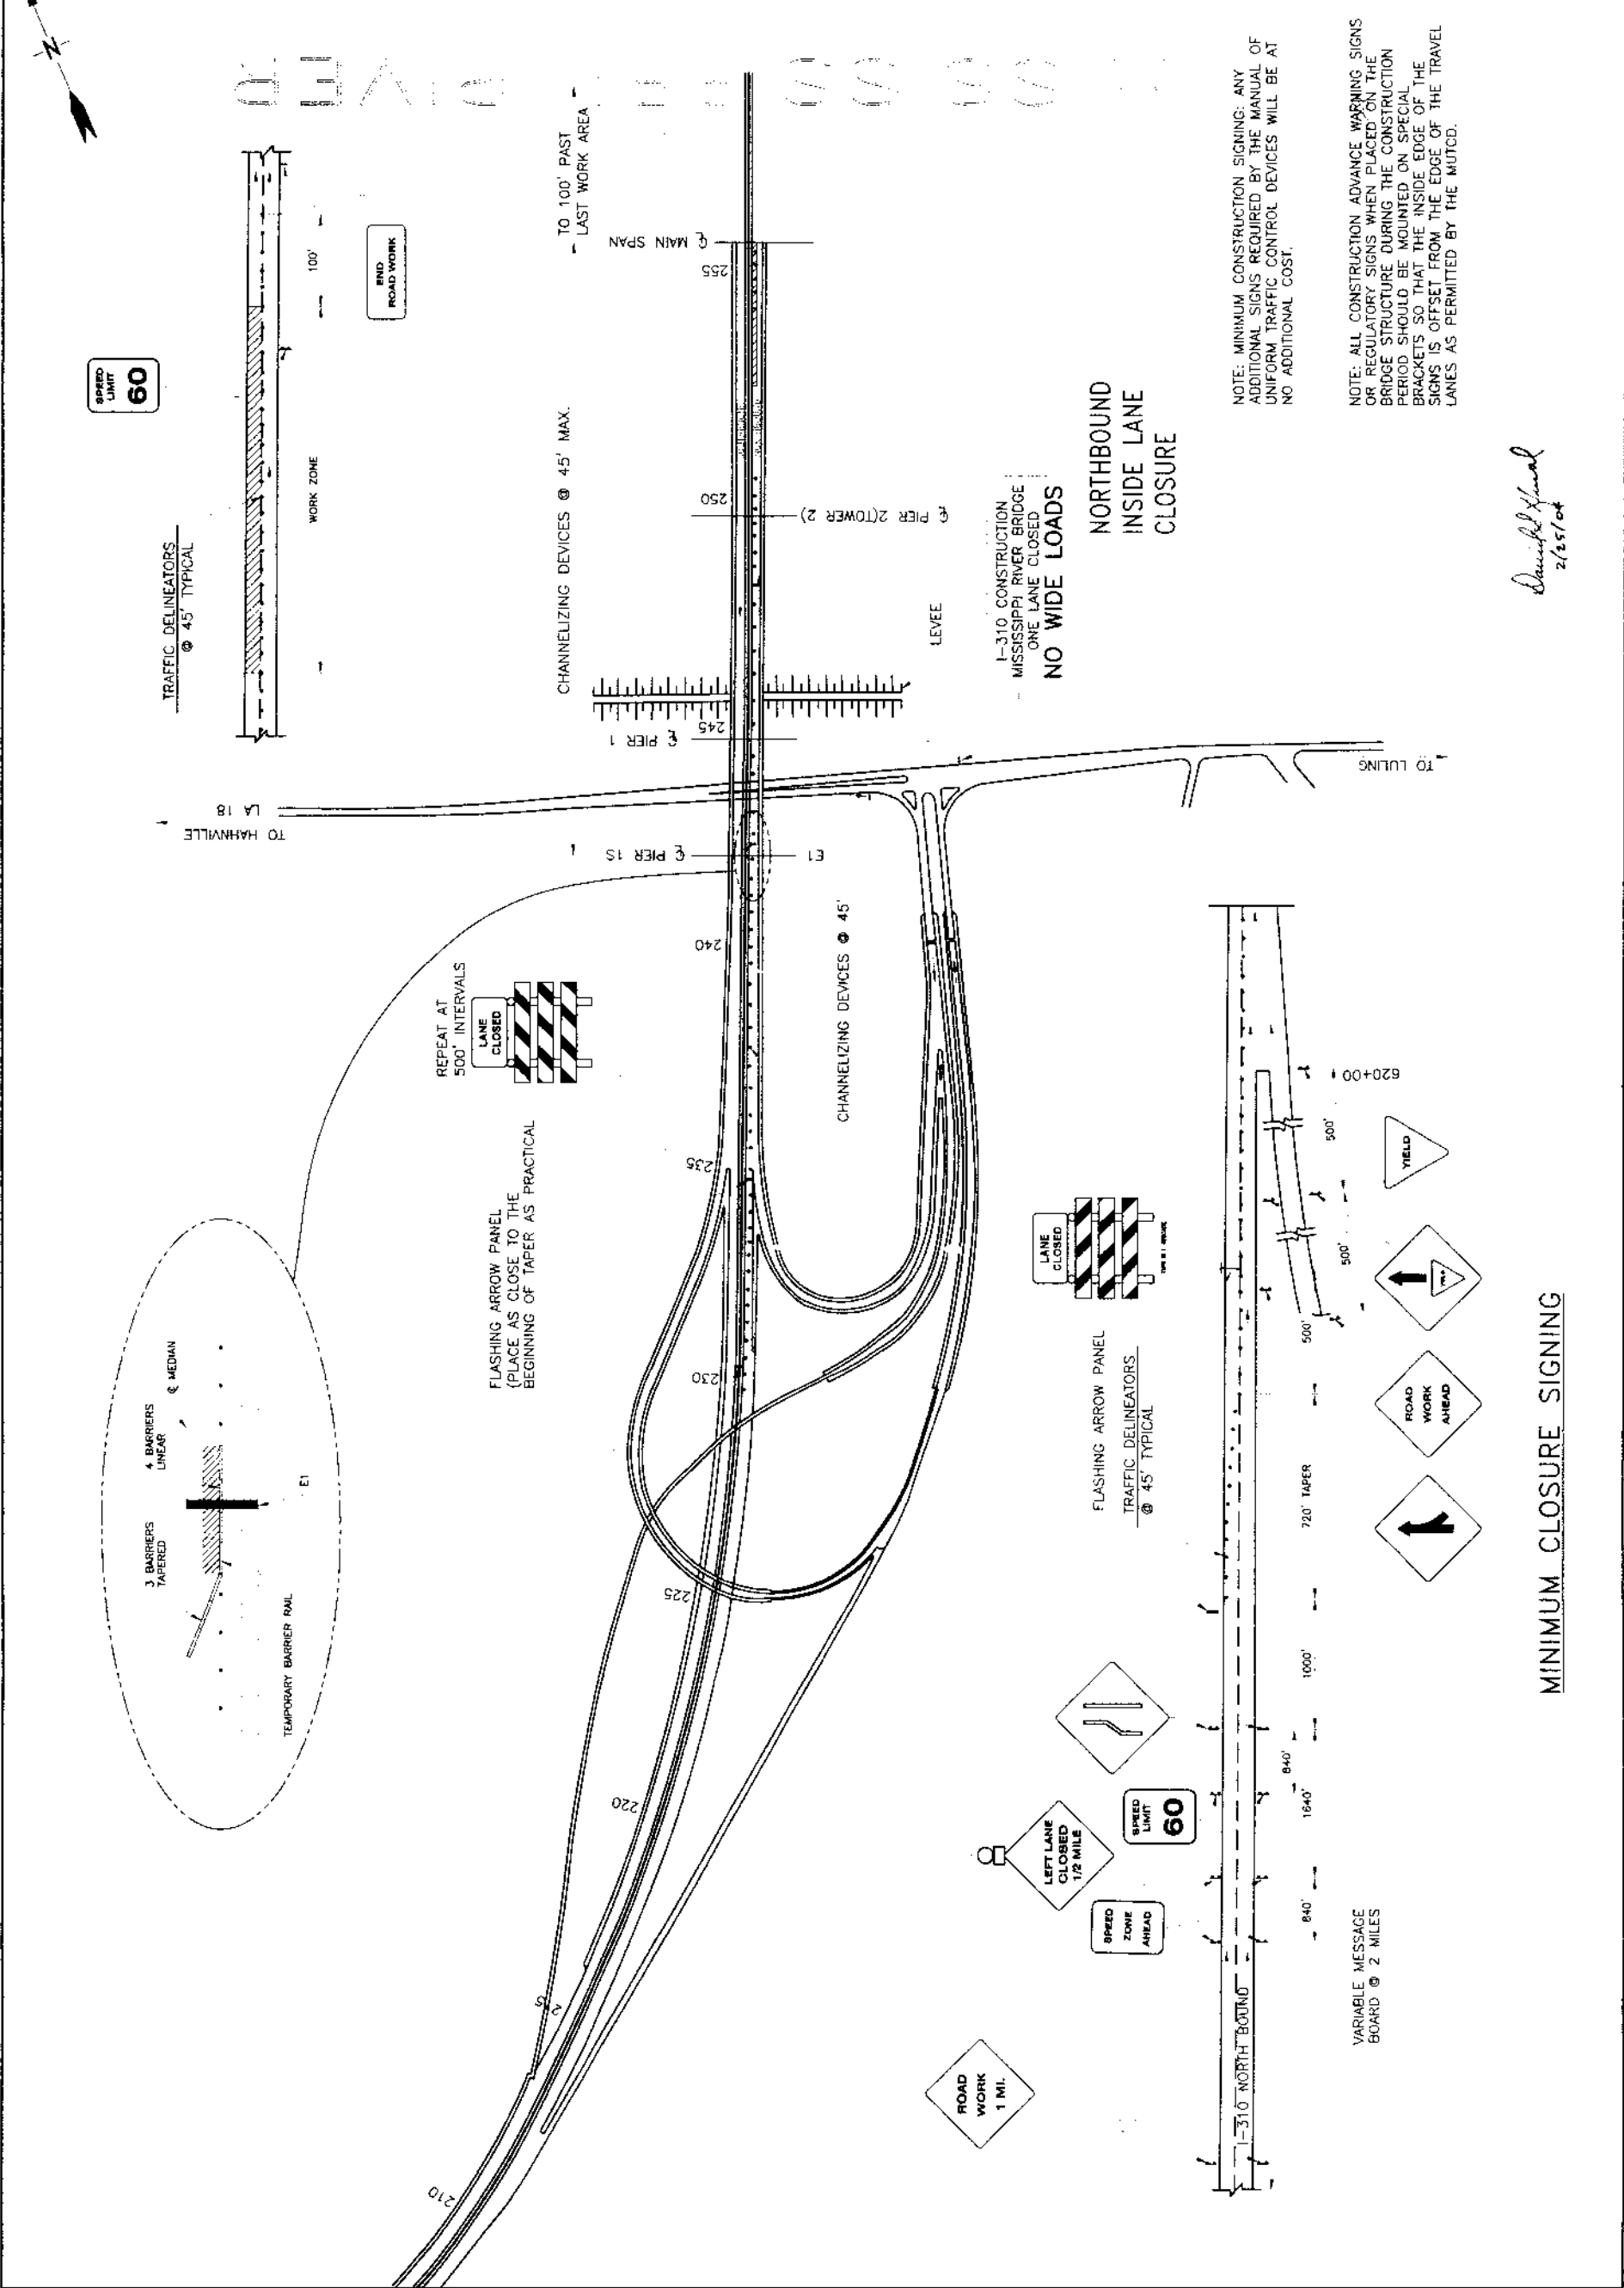


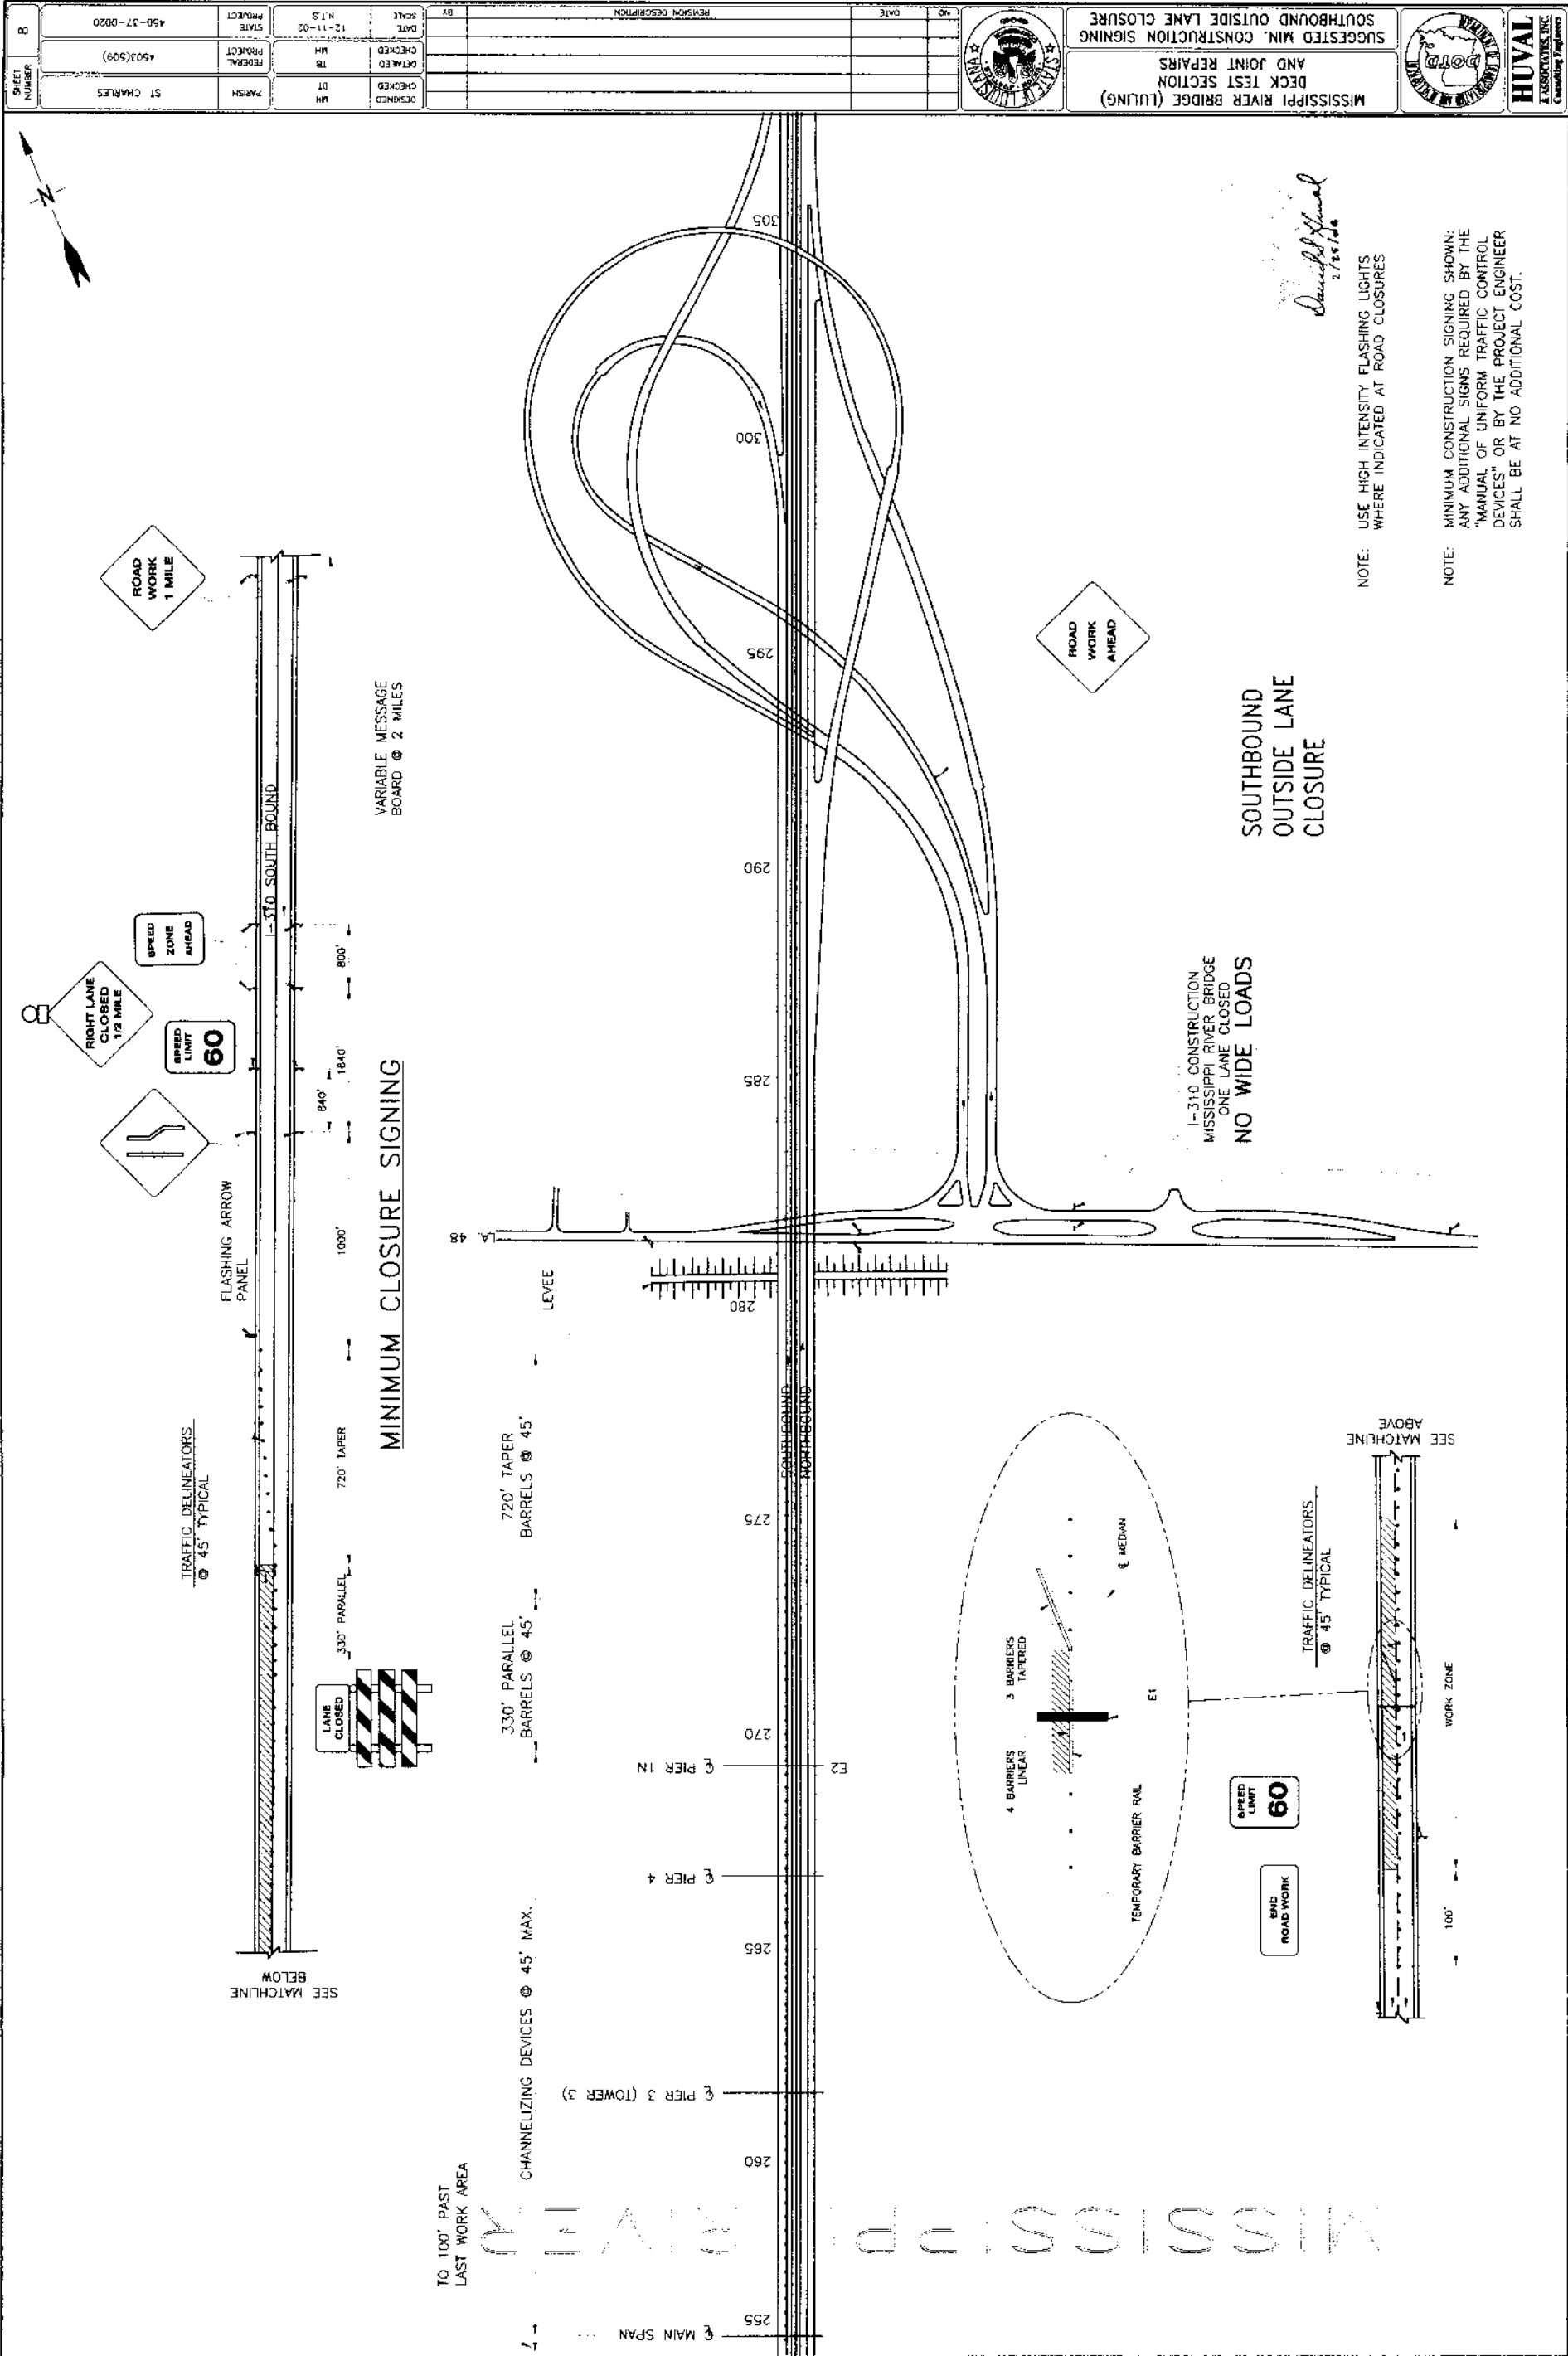

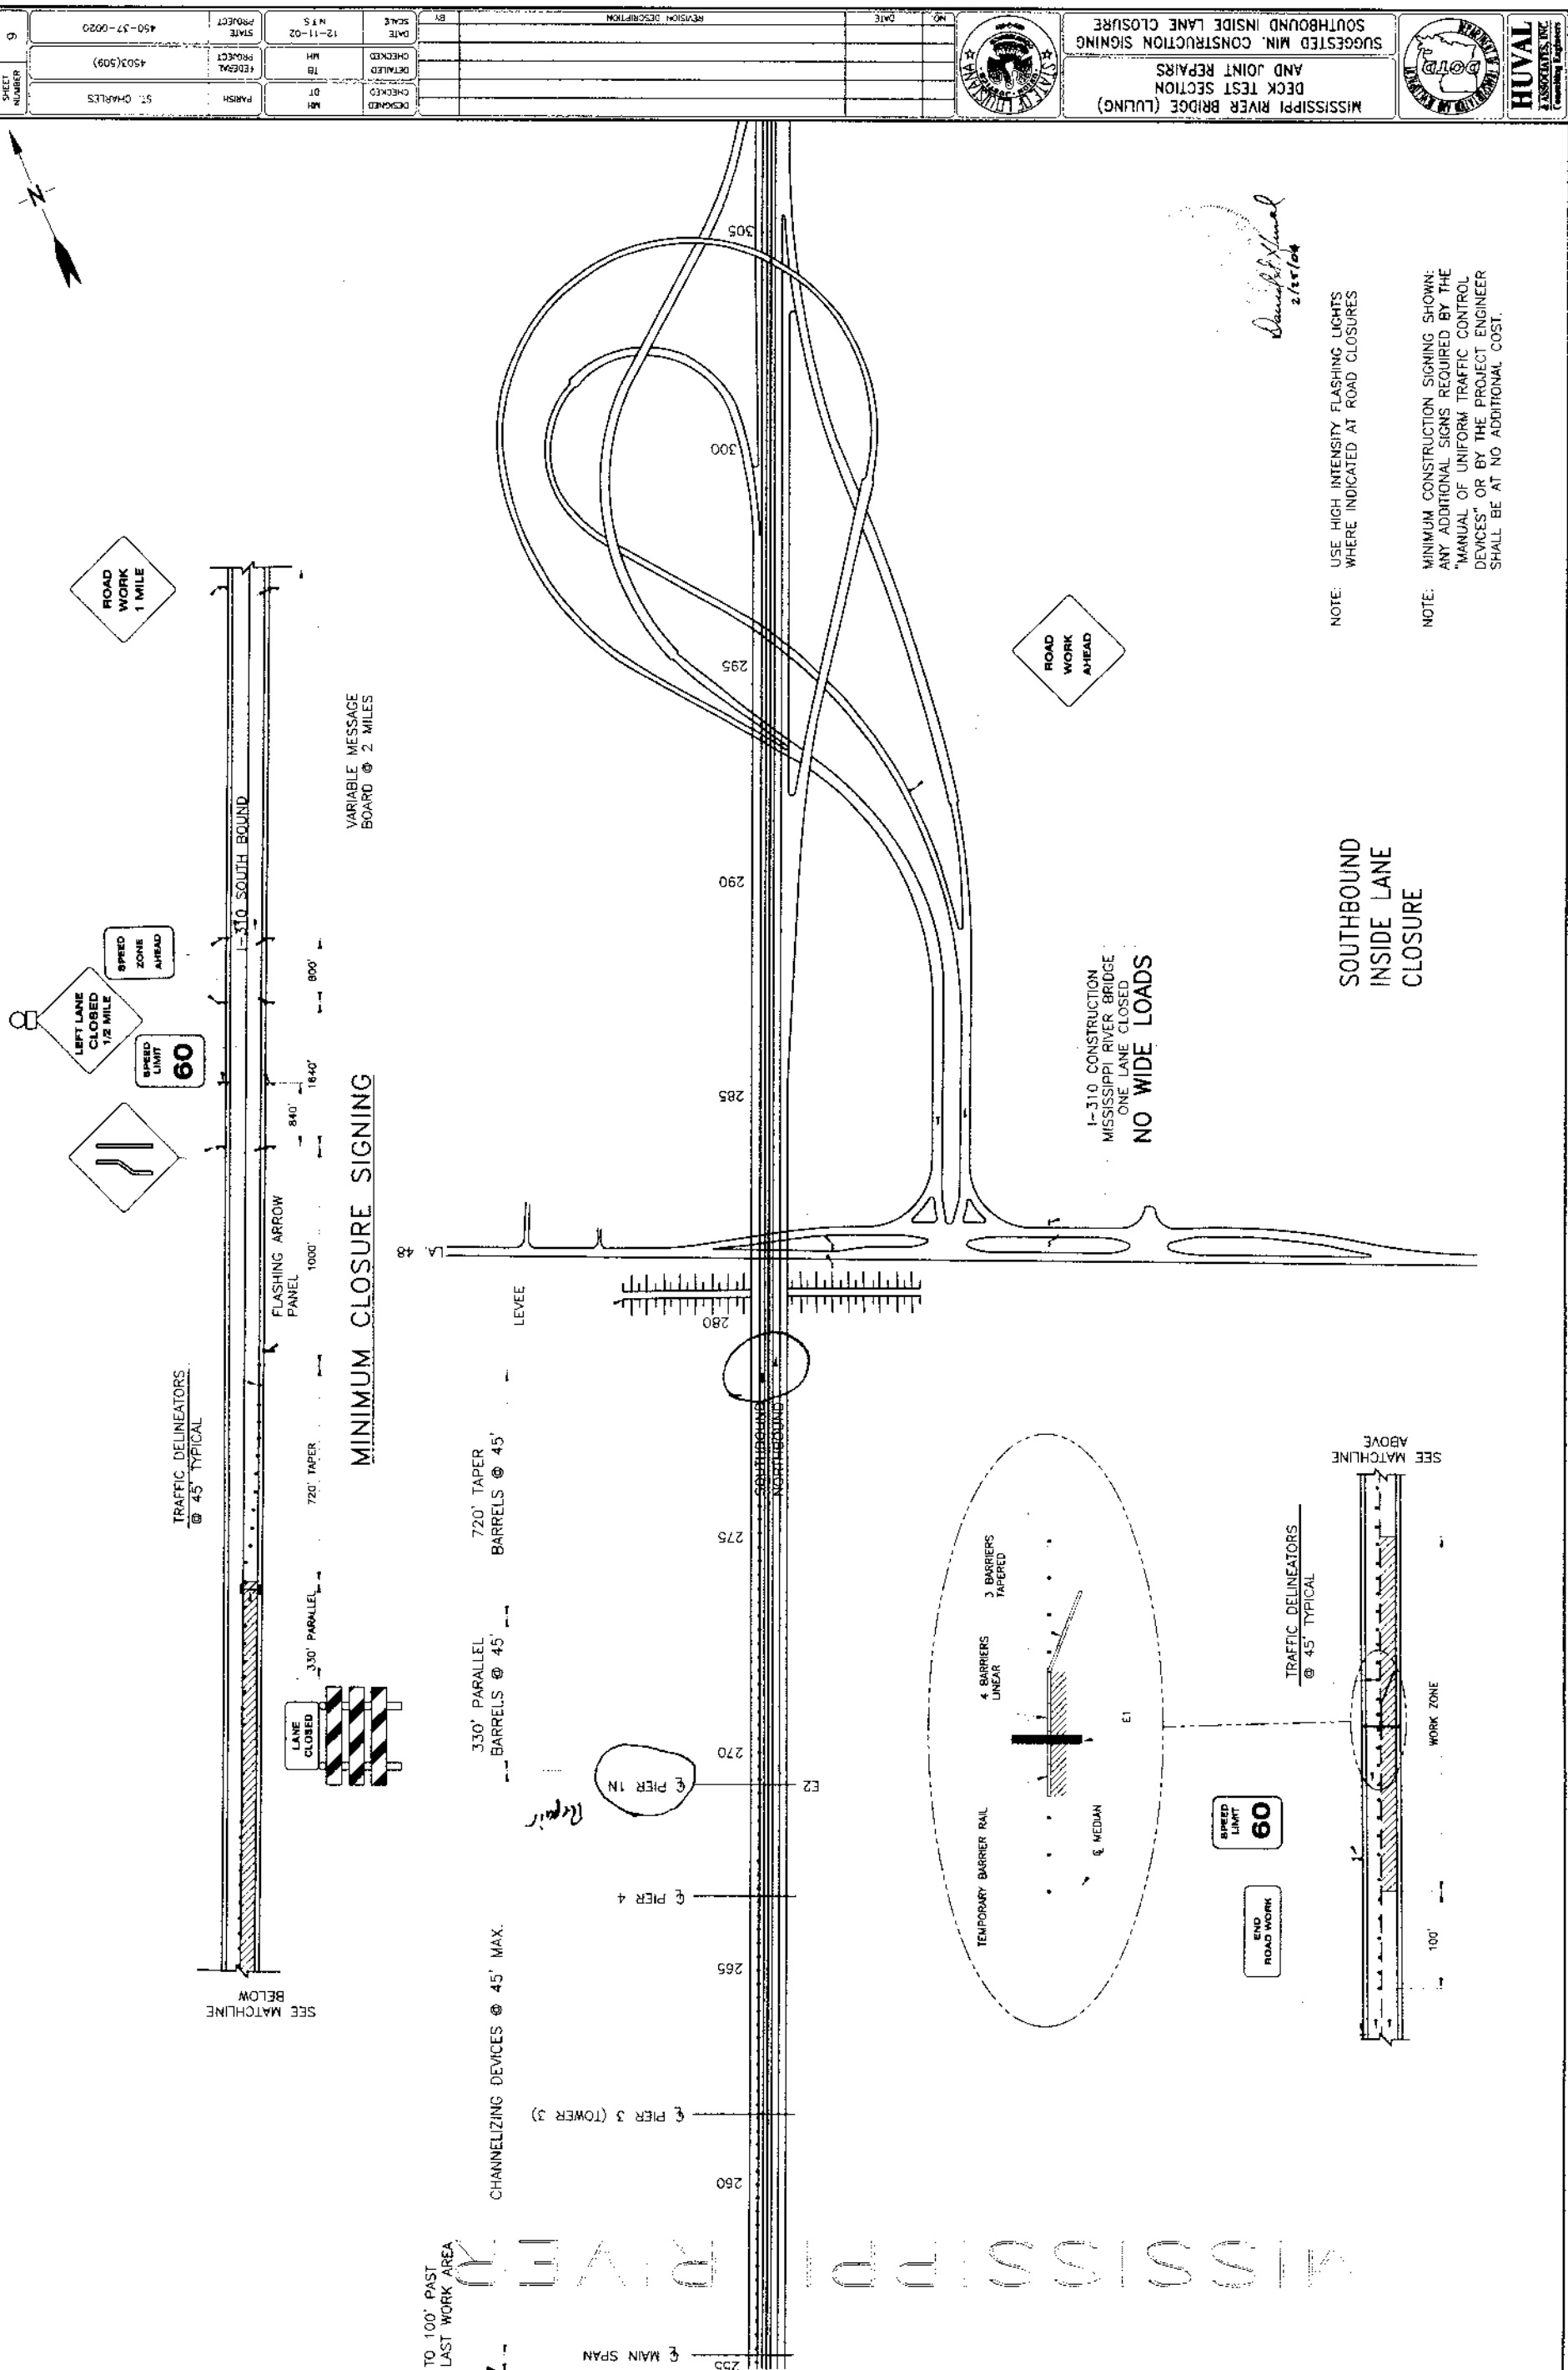

David L. Hall
2/25/04

NOTES:
DEVELOP TRAFFIC DEVIATIONS MINIMUM 100' PAST LAST WORK AREA

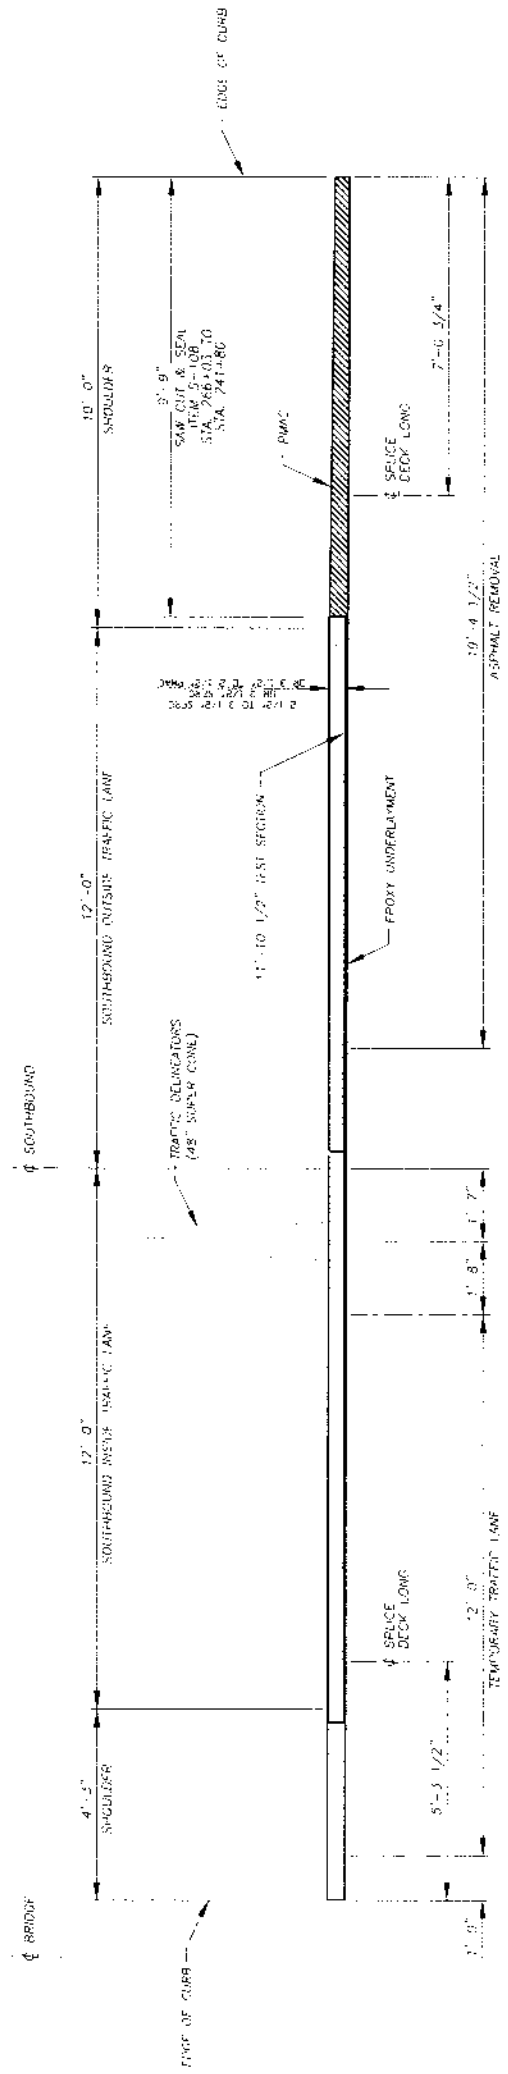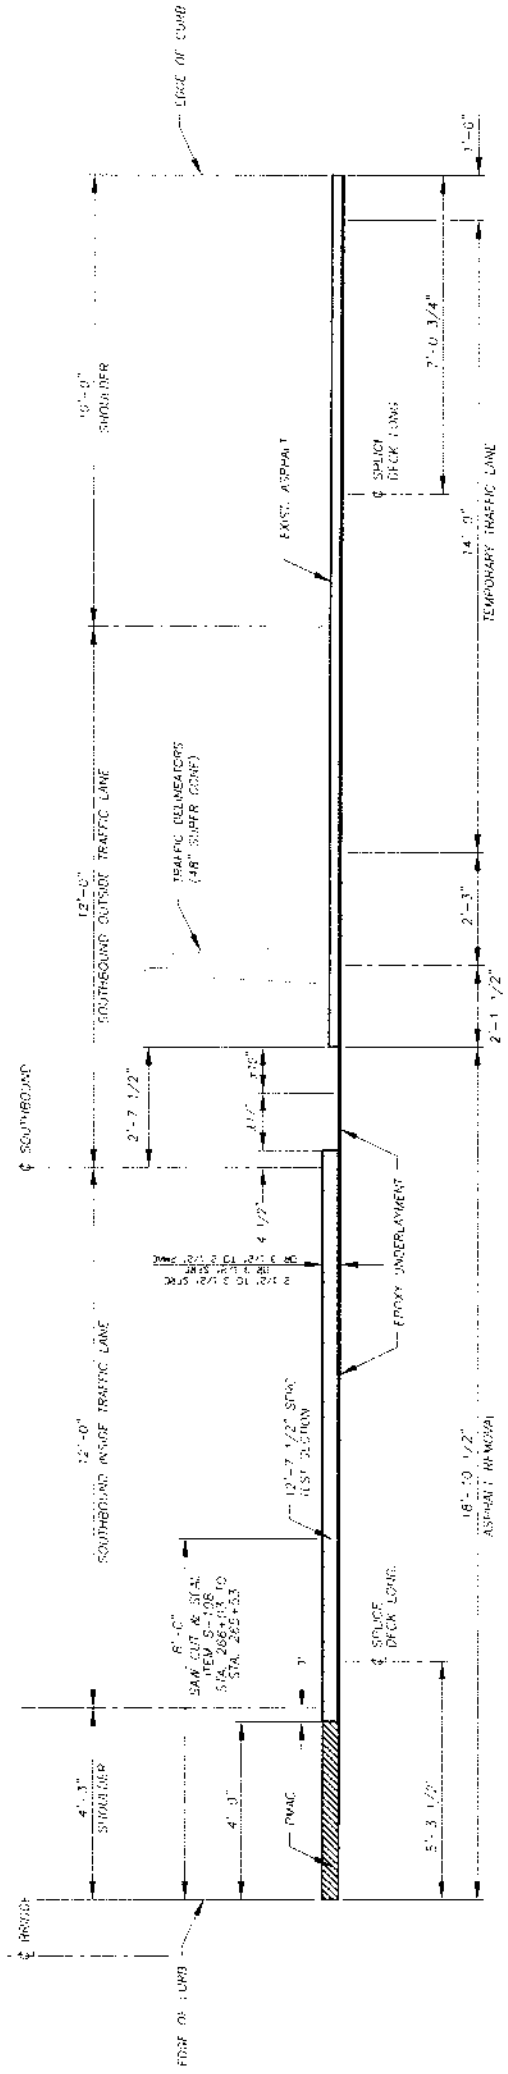

DESIGNED	DT	PARISH	ST CHARLES
CHECKED			
DETAILED	TB	FEDERAL	450-3(509)
CHECKED	MM	PROJECT	
SCALE	N.T.S.	STATE	450-7-0020
DATE	12-11-02	PROJECT	



MISSISSIPPI RIVER BRIDGE (LULUNG)
DECK TEST SECTION
AND JOINT REPAIRS
CONSTRUCTION TRAFFIC LAYOUT
E1 JOINT REPLACEMENT WORK





David P. Linn
2/25/64

NOTES:
** MINIMUM FOUR (4) CONCRETE BARBERS ALONG DOWN AND THREE (3) FOR UPLET TAPPLER
DEPLY COME UP, HEATING EXHAUSTORS WTC BARBER TAPPLER AND MINIMUM 150'
FAST LAST WORK AREA.

CONCERN IT BARRIERS & TRAFFIC DELAYATIONS NOT MEASURED FOR PAY
AT PART OF ITEM 71.5-51.



- PHASING AND PAIR SPICE FISH FLATES TO CONSIDER OPEN BLOCK ROADWAY AND REMOVAL LENGTHS

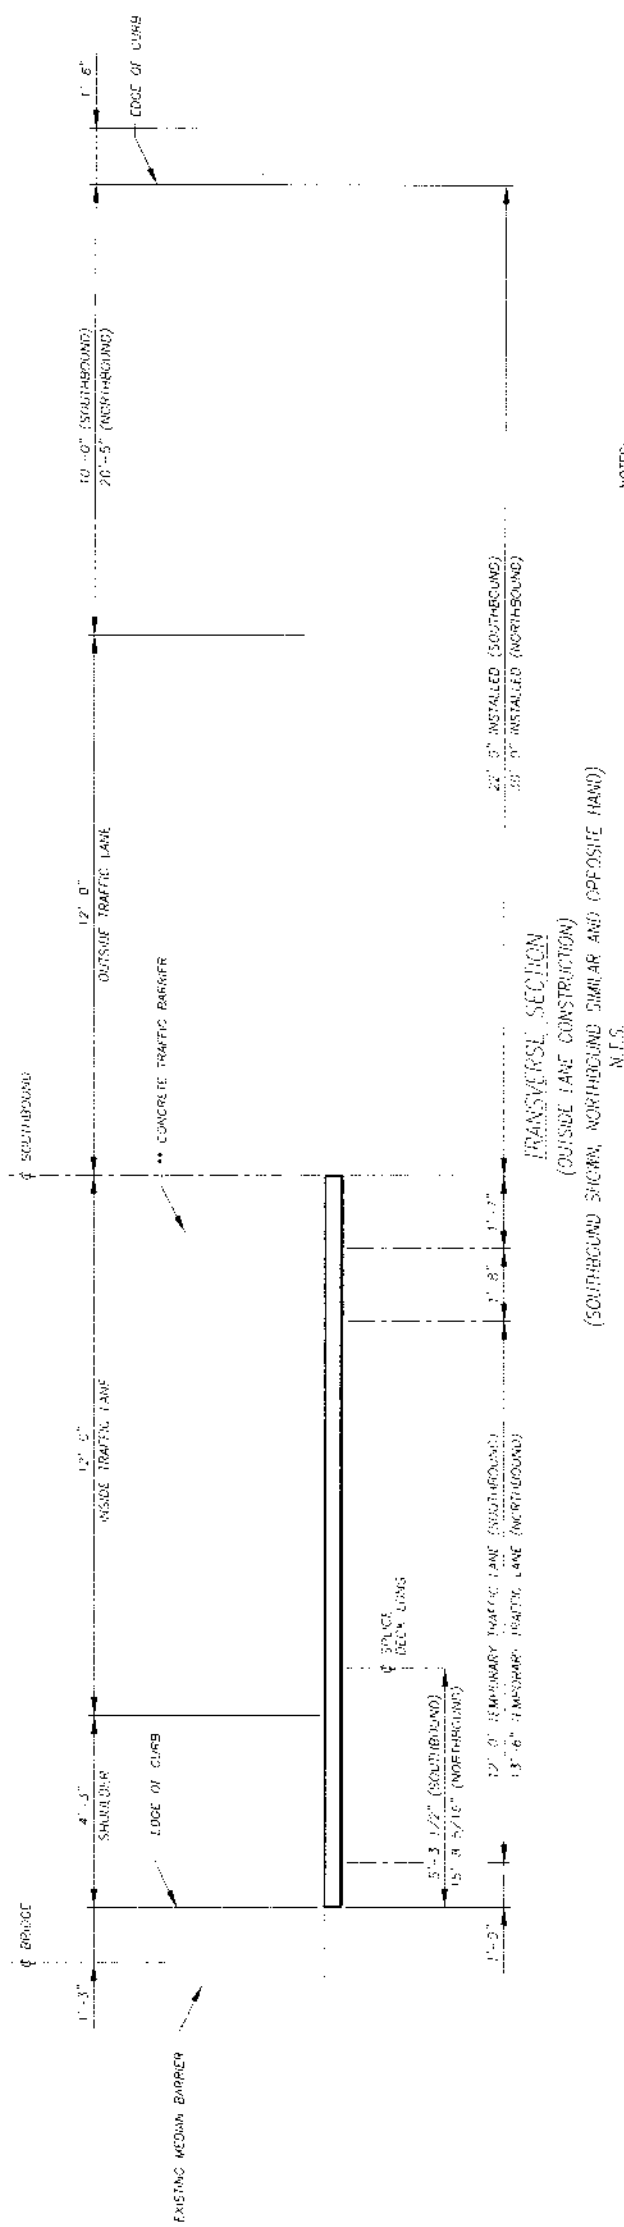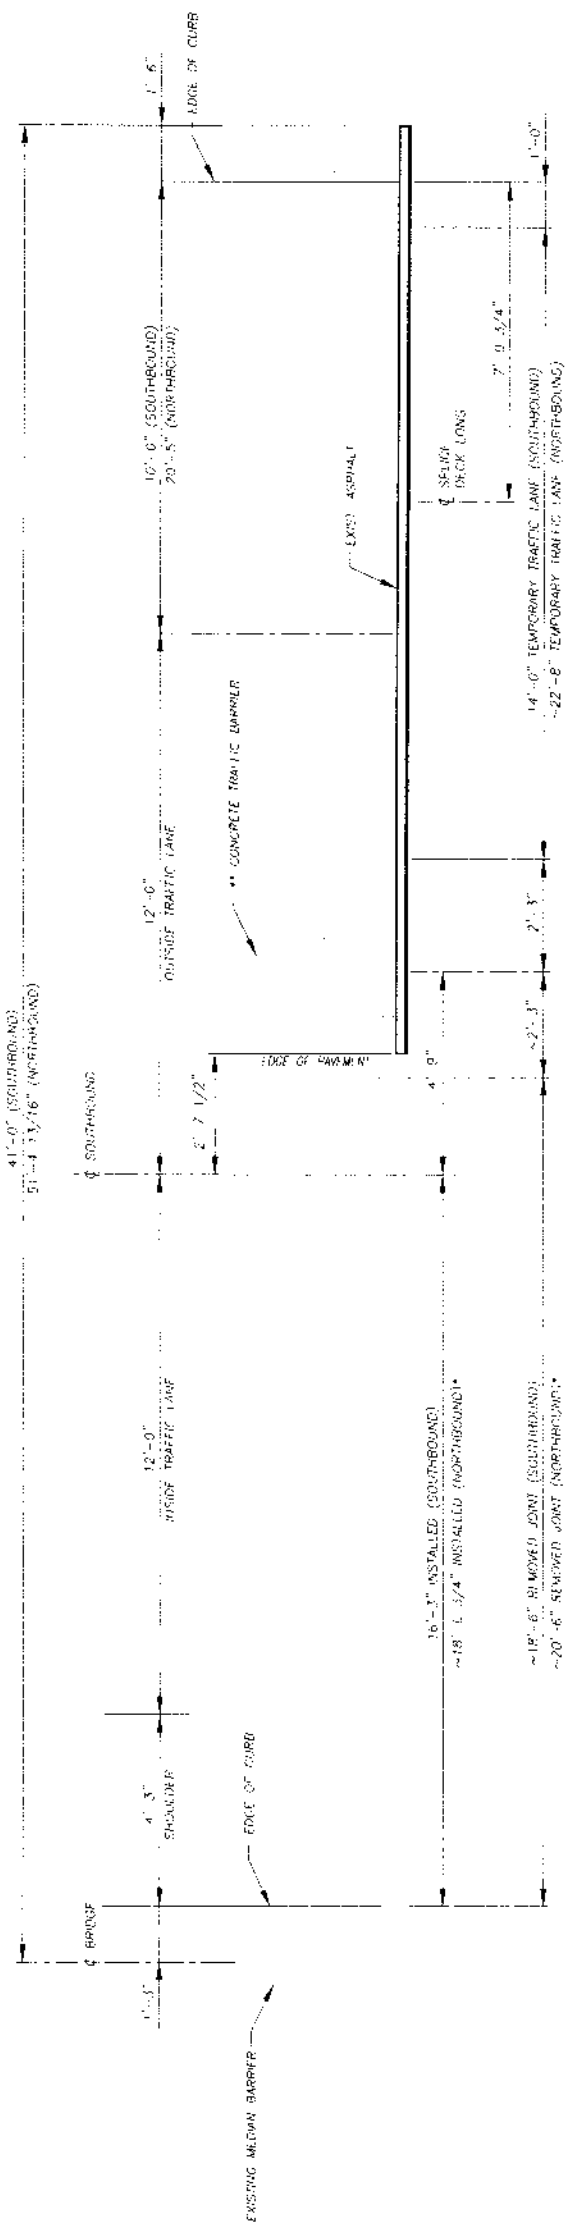


NOTE A: EXACT LOCATIONS/DIMENSIONS OF LONGITUDINAL
& TRANSVERSAL BULK SPILL BOLTS AVAILABLE IN
ORIGINAL BRIDGE CONSTRUCTION PLANS (IF REQUIRED)


FS -- DENOTES TRANSVERSAL FIELD SPIGOT


David H. Hual
2/25/04

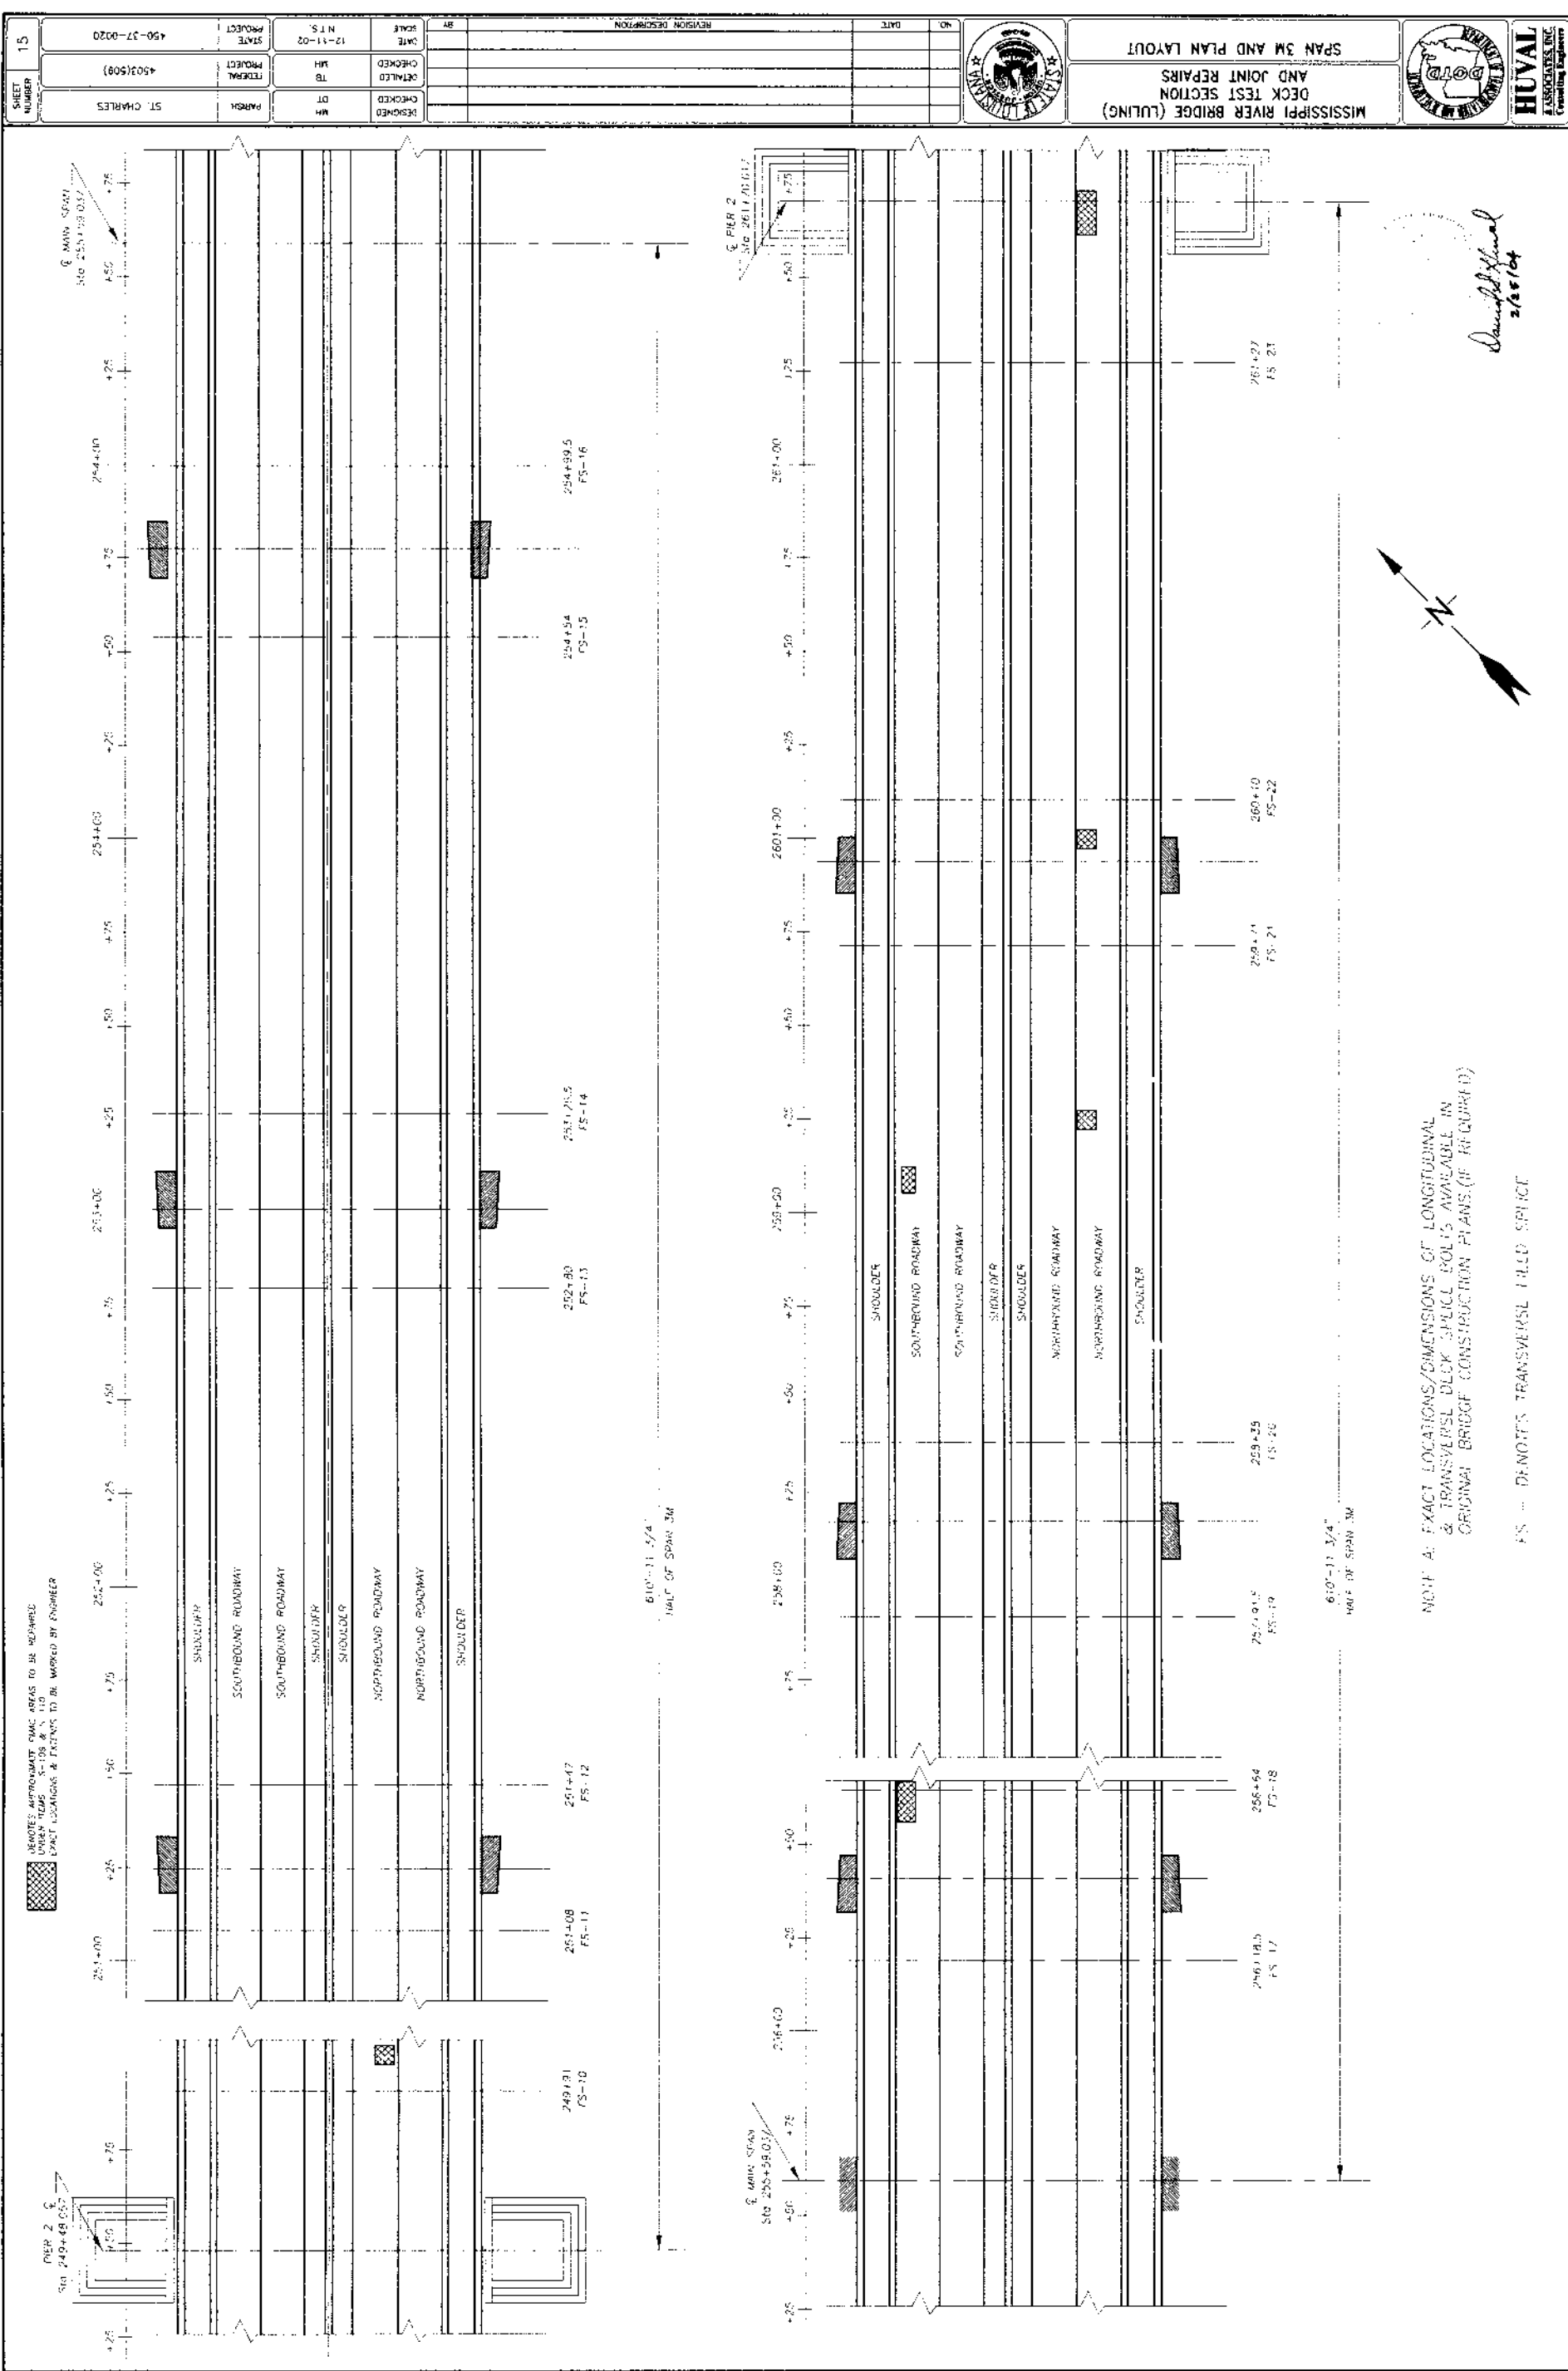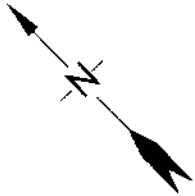

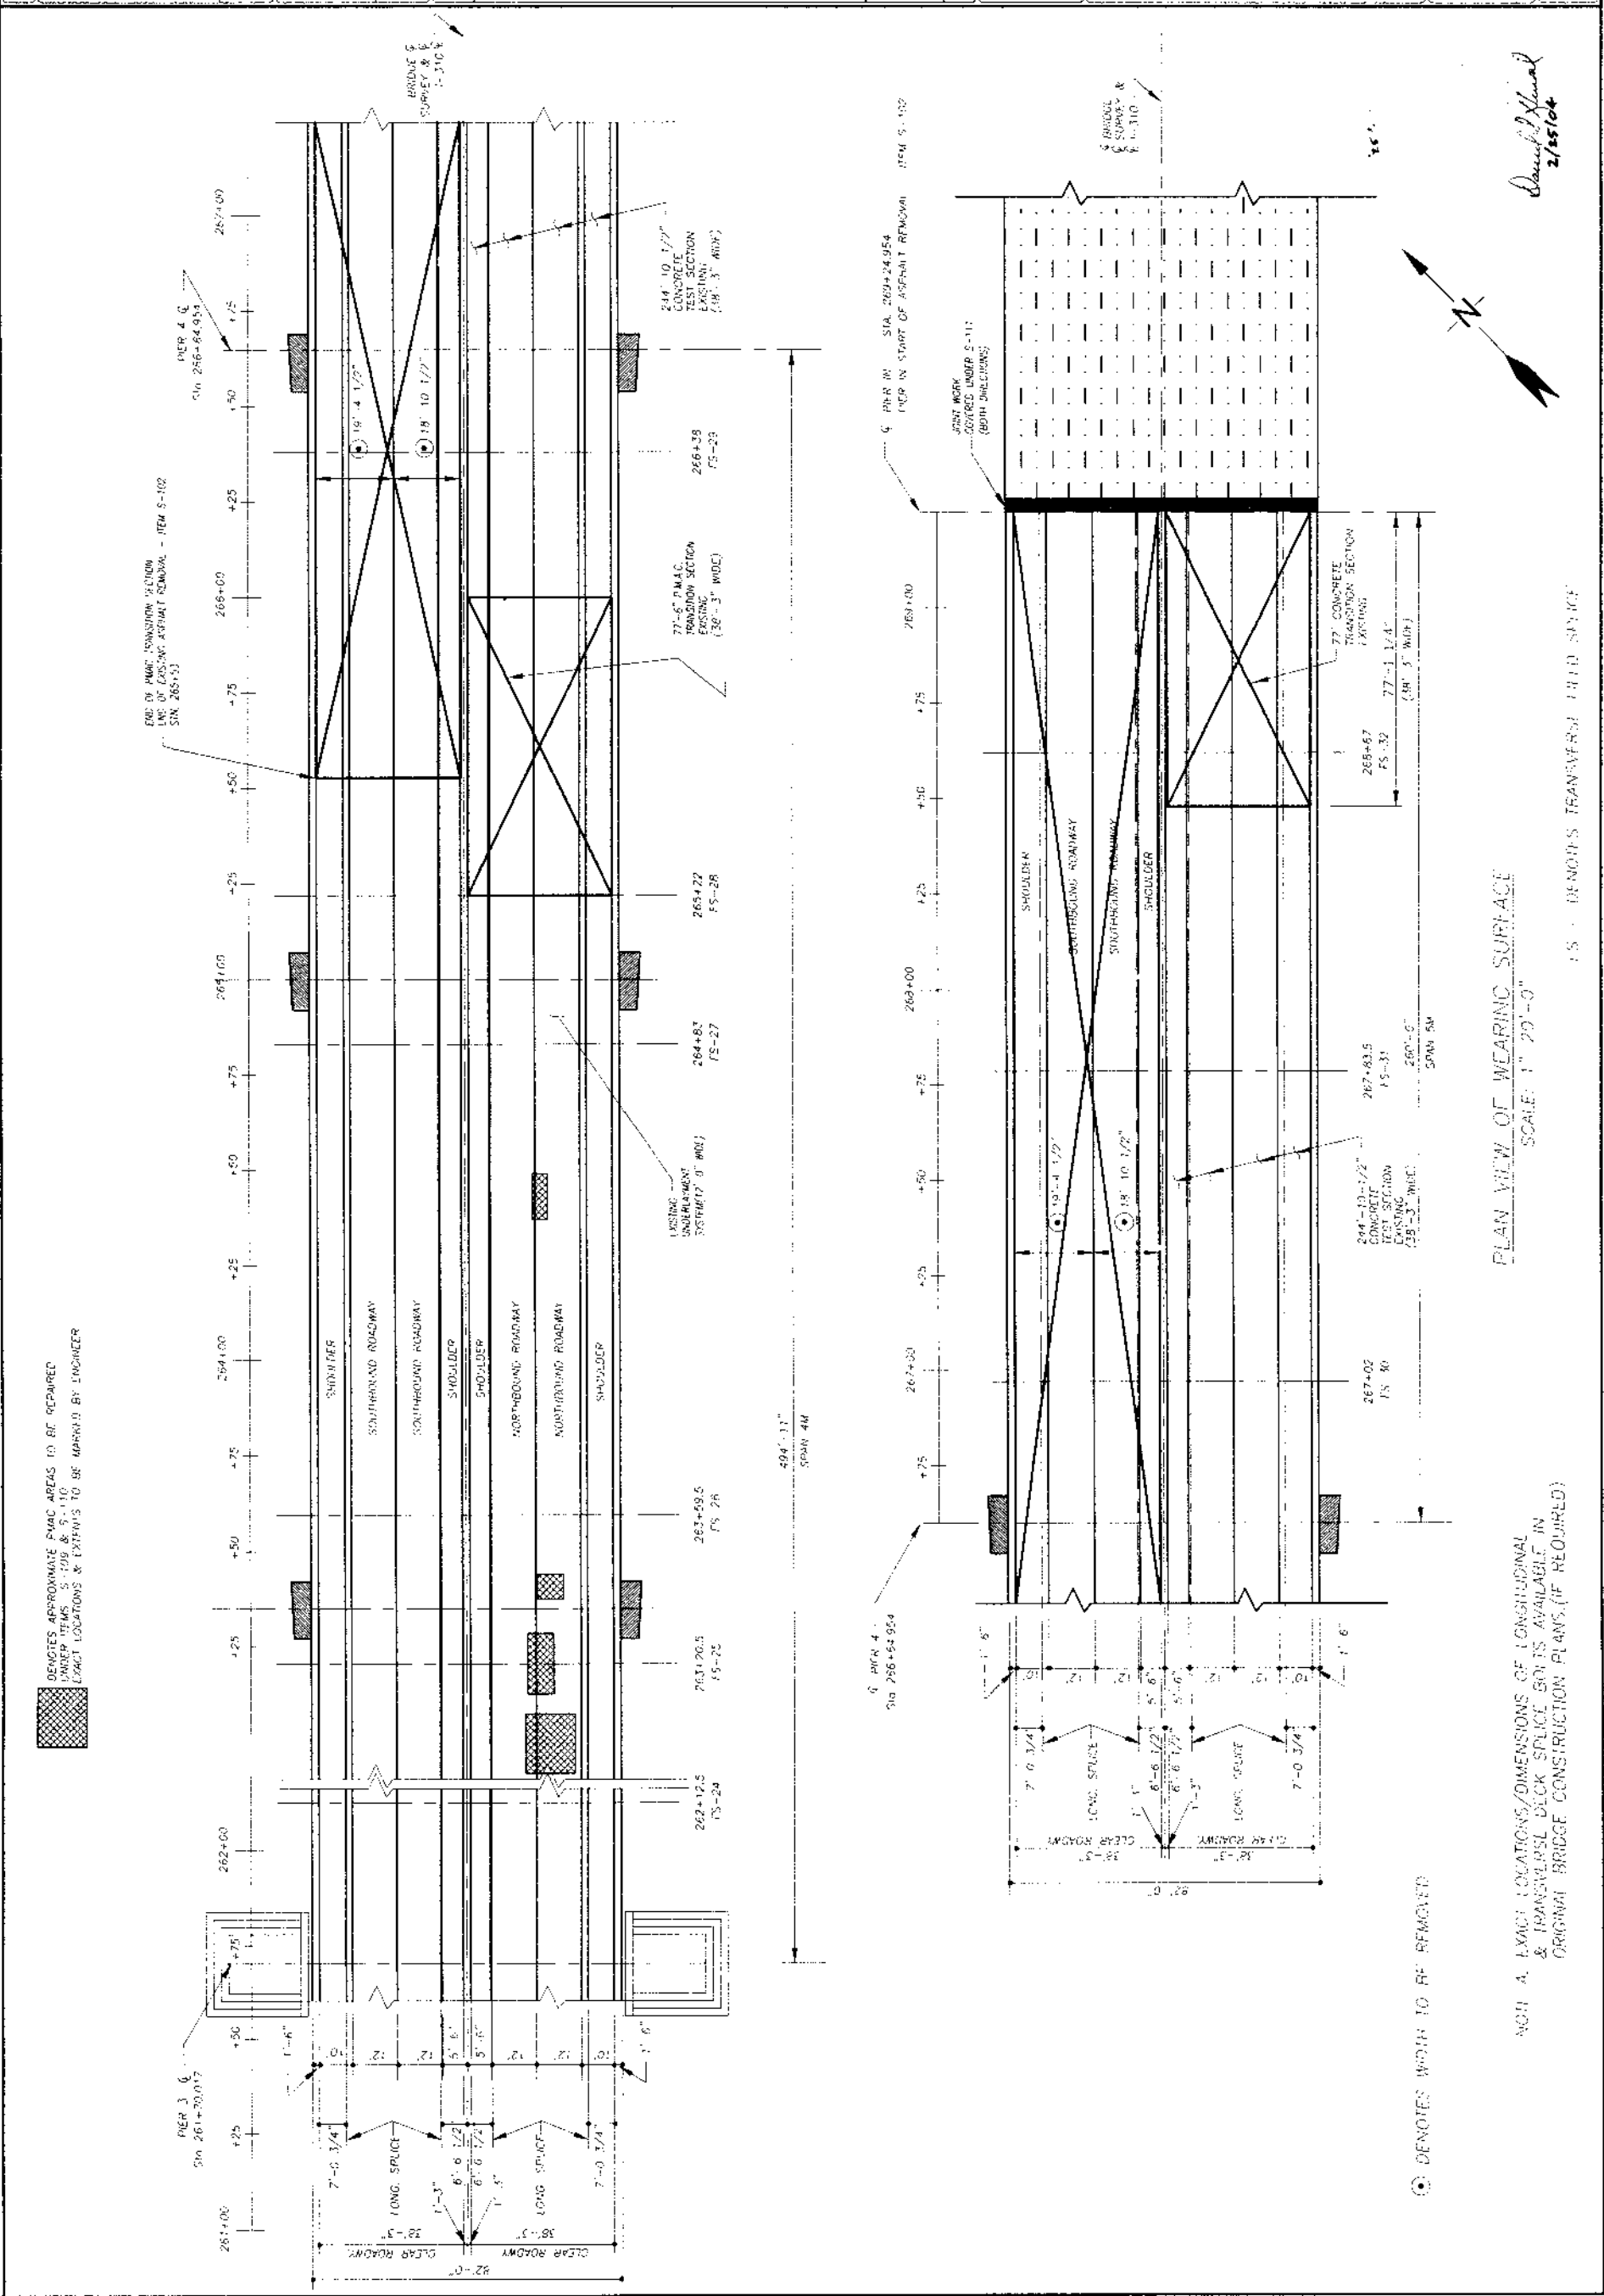

-d	0200-11-15W	003700 ENDF	5.4 M DE-11-2	1700 1100	10	POLYMERIZATION	1100	10
	16001000+	003700 100000	1100 1100	1700 1100				
	110000000	110000	1100 1100	1700 1100				

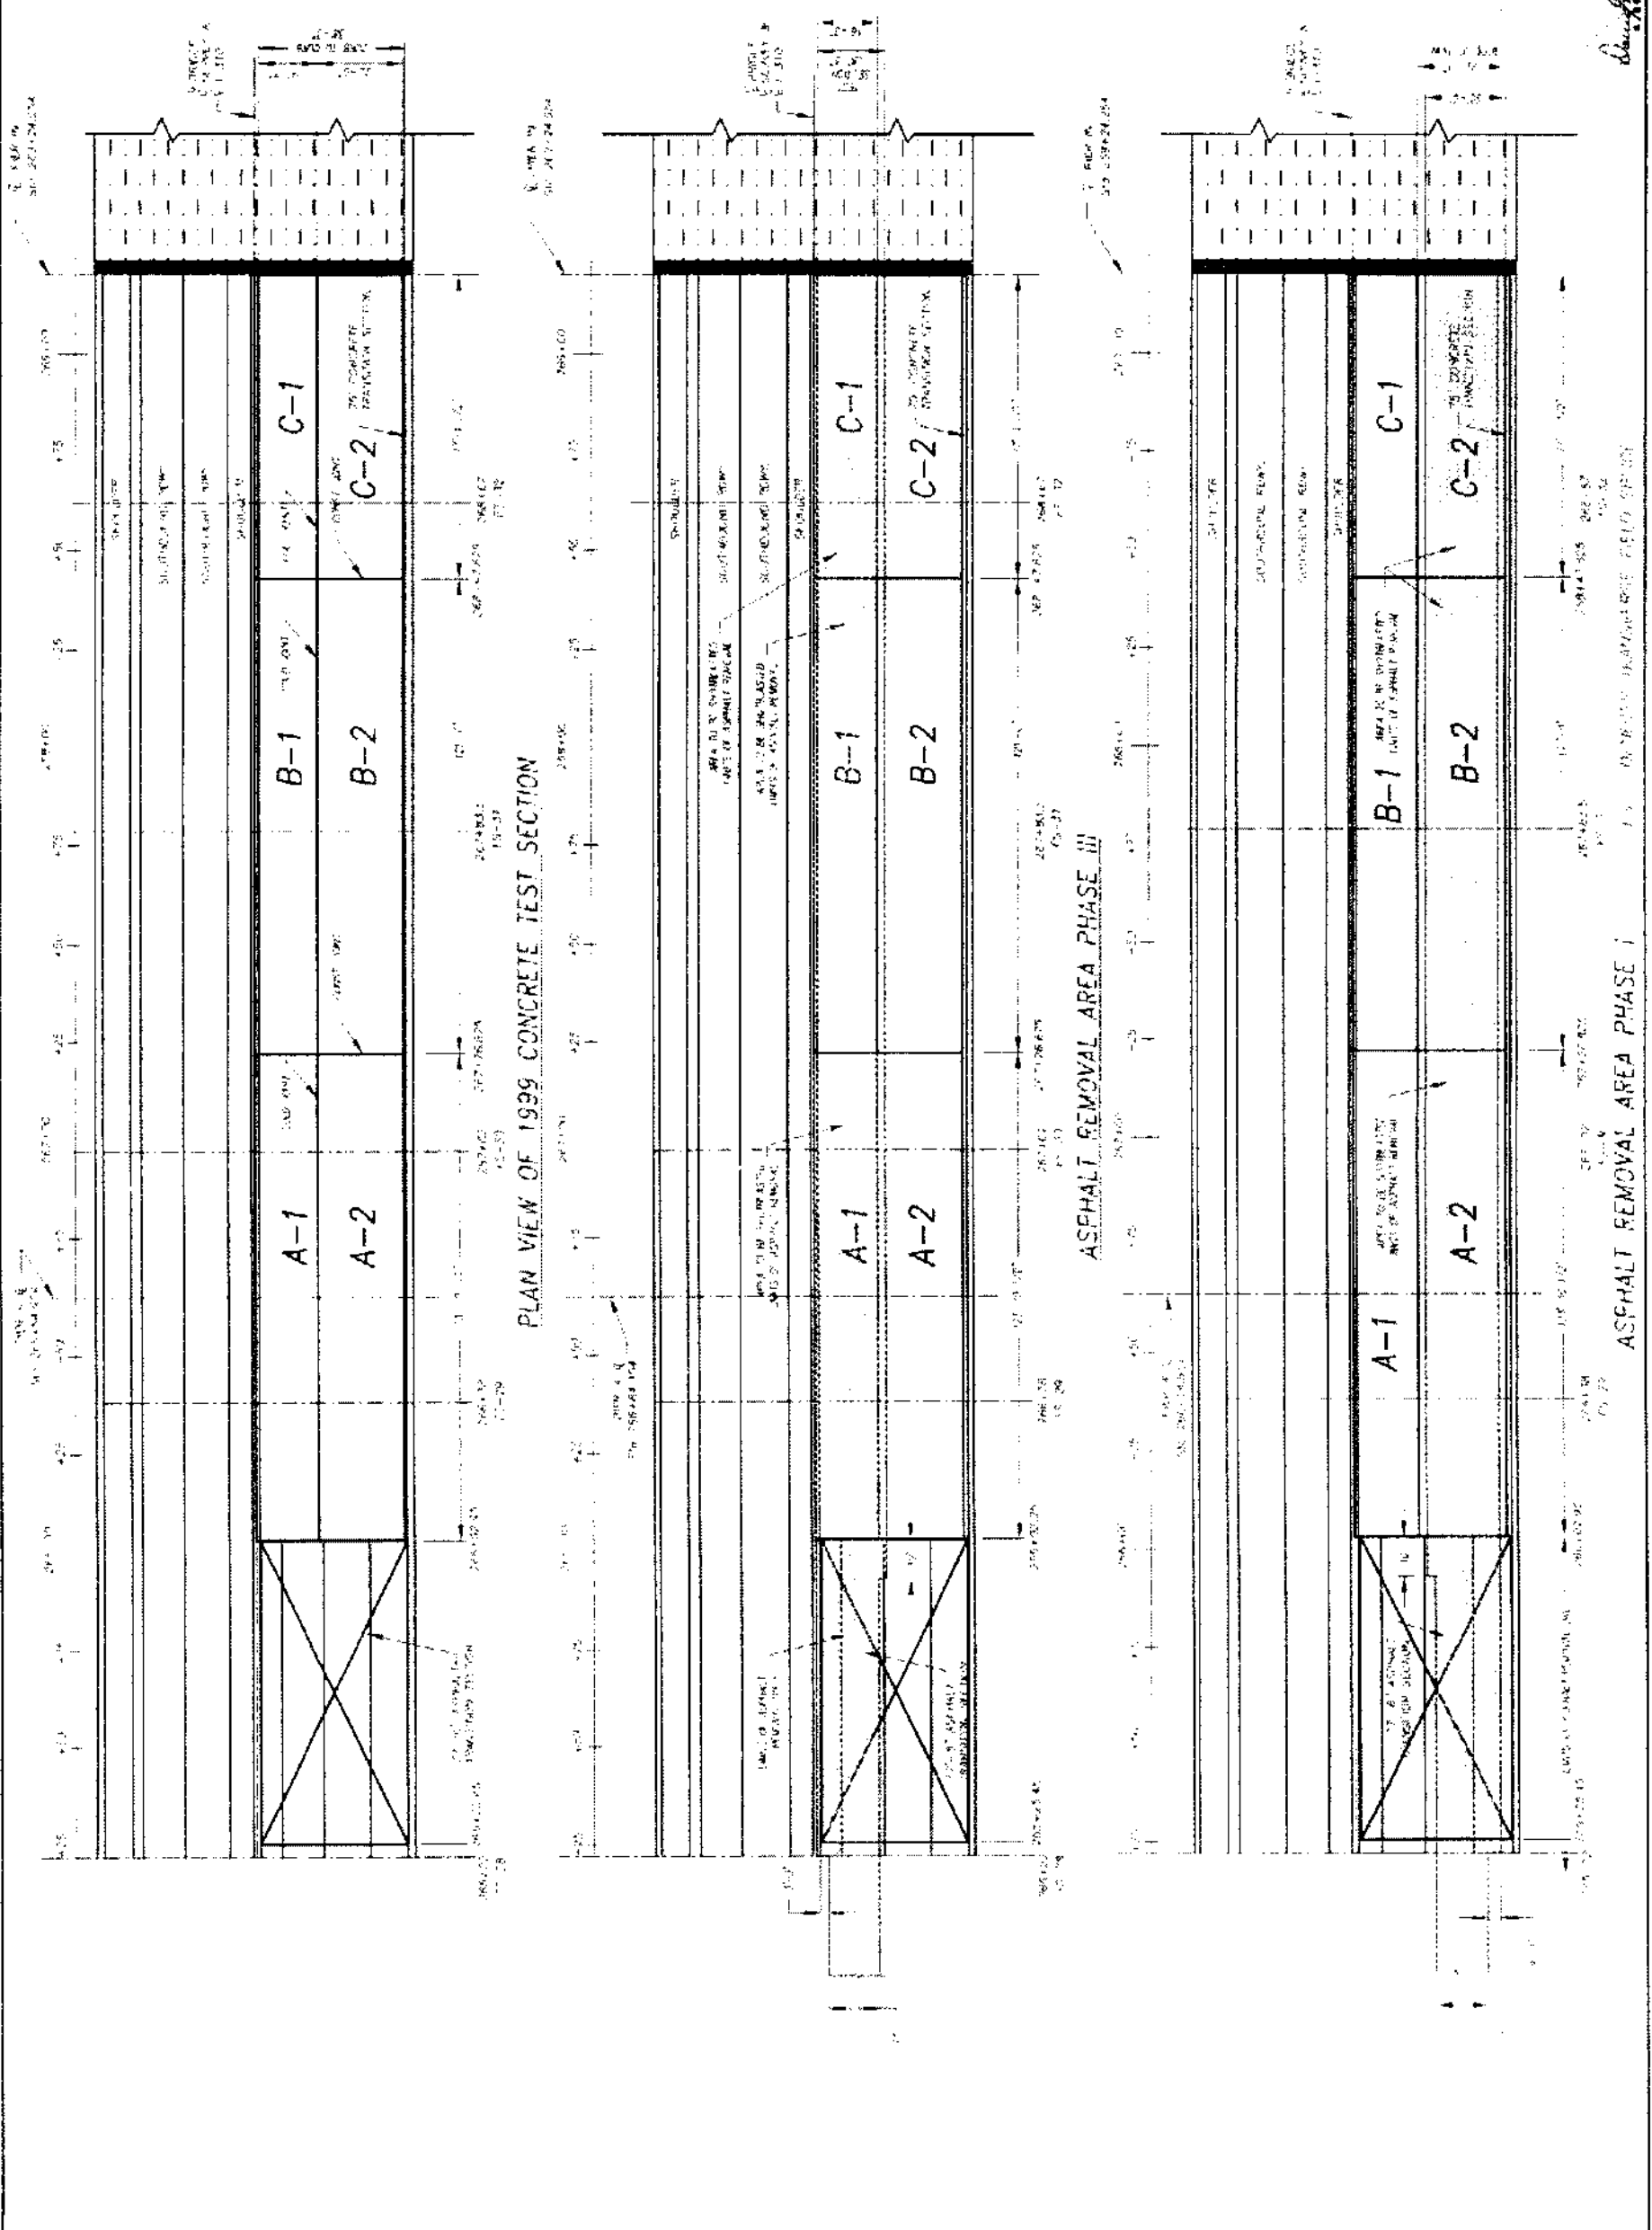

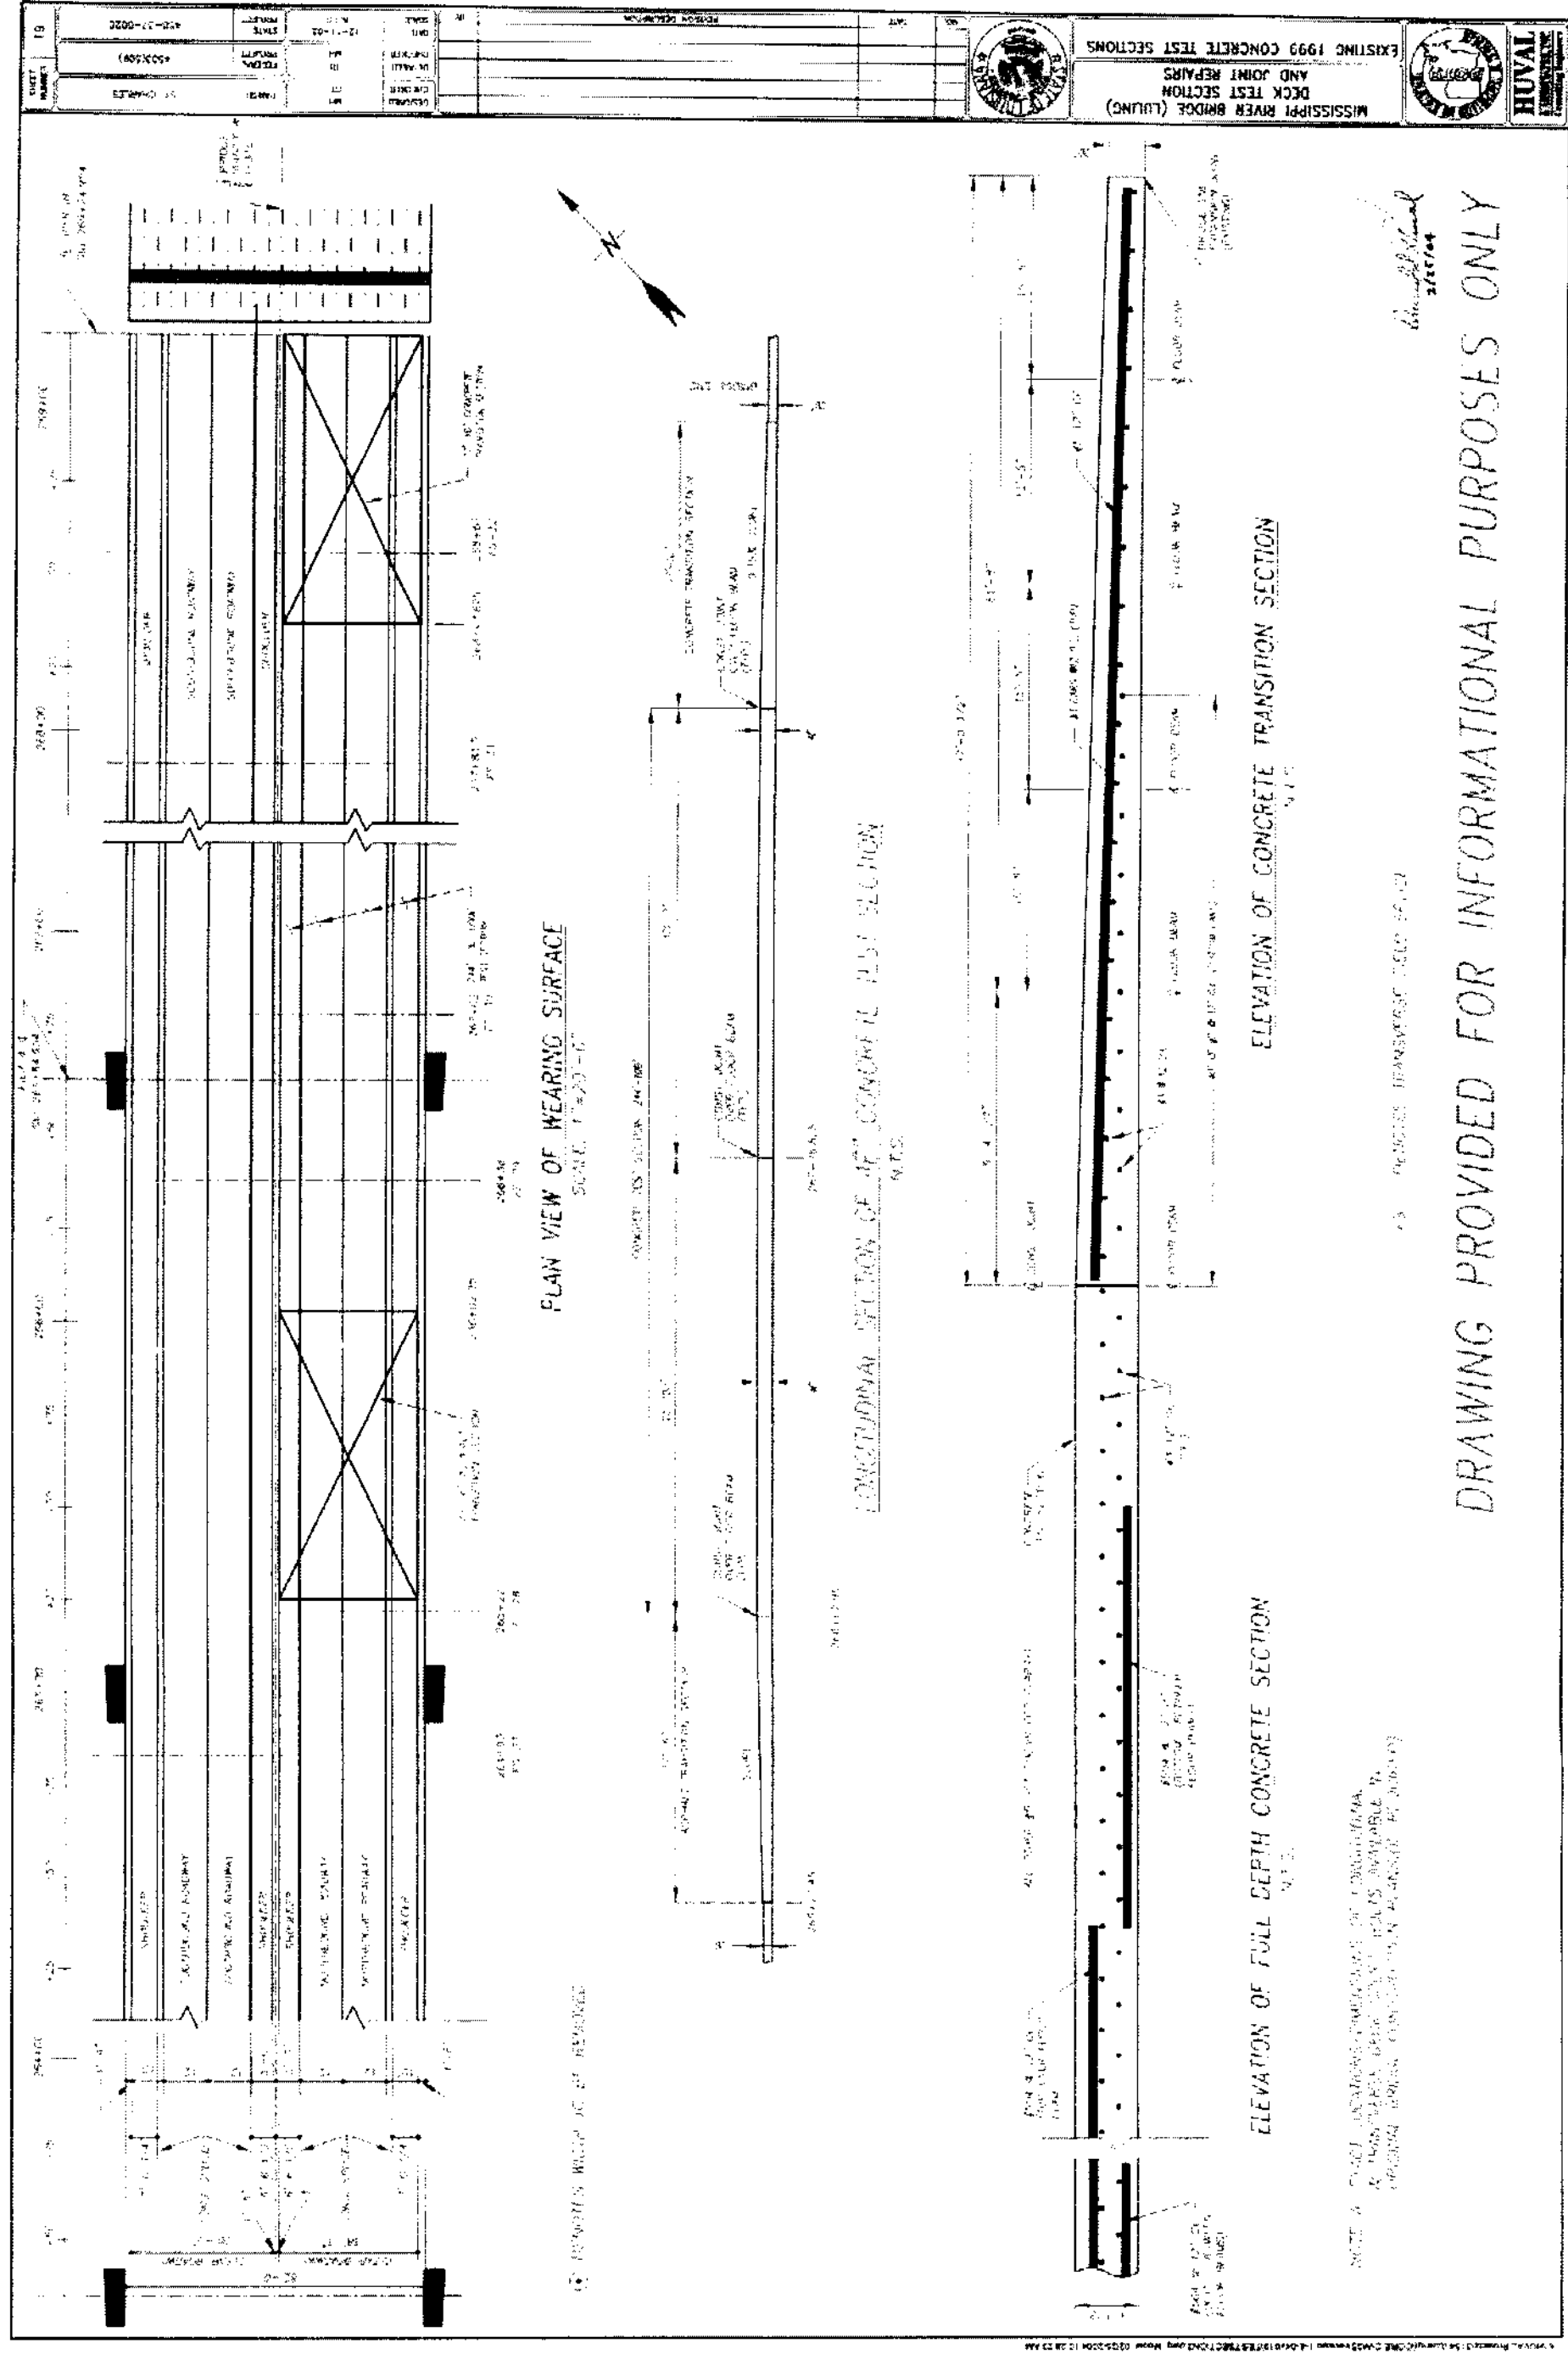

NOTE: A. CHECK DIMENSIONS OF LONGITUDINAL SECTION AGAINST FIELD RECORDS. B. DIMENSIONS OF TRANSVERSE SECTION ARE BASED ON FIELD RECORDS.

ELEVATION OF FULL DEPTH CONCRETE SECTION
ELEVATION OF CONCRETE TRANSITION SECTION
DRAWING PROVIDED FOR INFORMATIONAL PURPOSES ONLY

MISSISSIPPI RIVER BRIDGE (LULUNG)
DECK TEST SECTION
AND JOINT REPAIRS
EXISTING 1999 CONCRETE TEST SECTIONS

PROJECT NO. 10-02
DATE 12-11-02
SCALE 1/4" = 1'-0"

DESIGNED BY: CHARLES
CHECKED BY: [blank]
IN CHARGE: [blank]

PROJECT NO. 10-02
DATE 12-11-02
SCALE 1/4" = 1'-0"

PROJECT NO. 10-02
DATE 12-11-02
SCALE 1/4" = 1'-0"





MISSISSIPPI RIVER BRIDGE (LUNG)
DECK TEST SECTION
AND JOINT REPAIRS
EXISTING 1999 CONCRETE TEST SECTION




NO.	DATE	REVISION DESCRIPTION
BT		
SCALE	DATE	SCALE
12-11-02	12-11-02	12-11-02
PROJECT	STATE	PROJECT
450-37-0020	450-37-0020	450-37-0020
DESIGNED	DT	DESIGNED
DT	DT	DT
PROJECT	PROJECT	PROJECT
4503(509)	4503(509)	4503(509)
ST. CHARLES	ST. CHARLES	ST. CHARLES

DRAWING PROVIDED FOR INFORMATIONAL PURPOSES ONLY


2/15/04

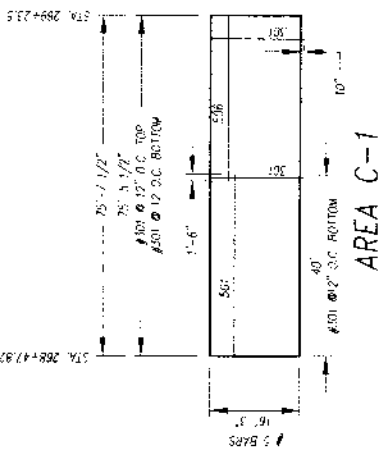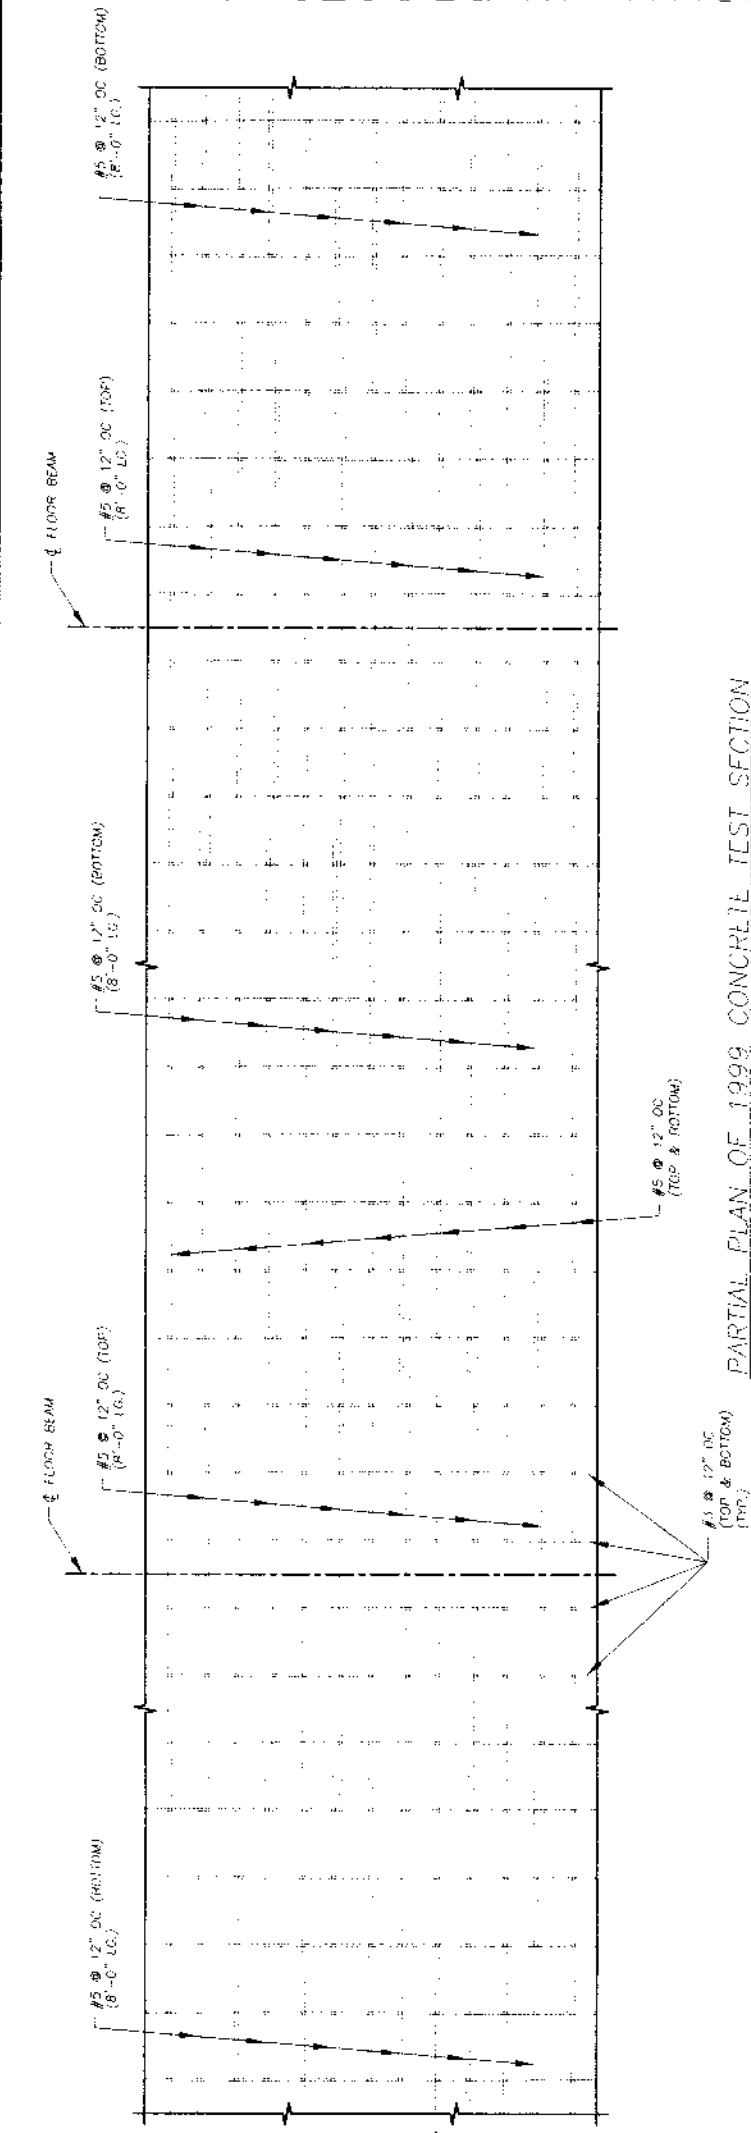


No.	LENGTH	Qty
501	40'-0"	34
506	18'-6"	17
301	17'-0"	28
301	17'-0"	41

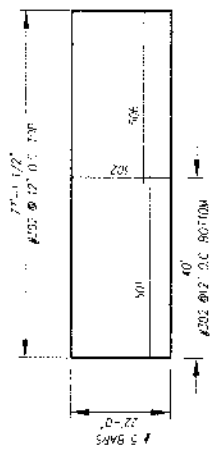


No.	LENGTH	Qty
501	40'-0"	46
506	34'-6"	23
302	21'-10"	78
302	21'-10"	41

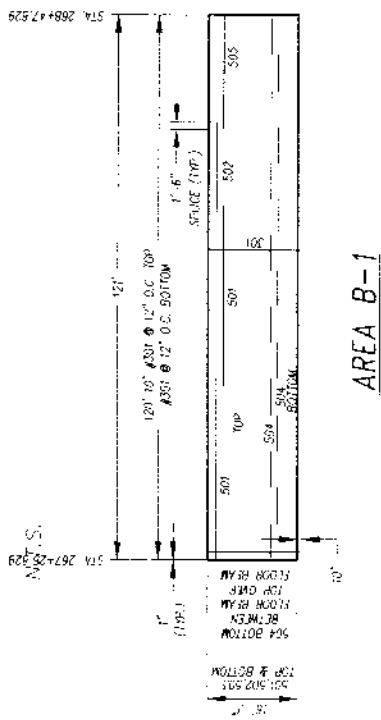


No.	LENGTH	Qty
501	40'-0"	68
502	20'-0"	34
505	25'-4"	34
504	8'-0"	255
301	17'-0"	243

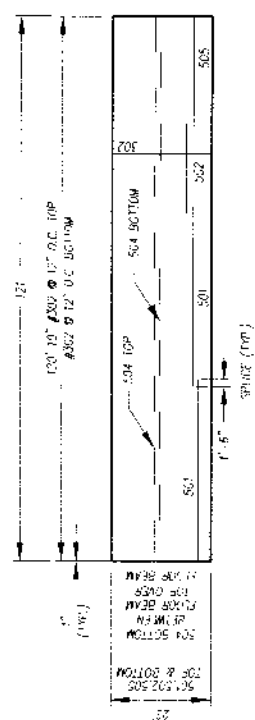


No.	LENGTH	Qty
501	40'-0"	92
502	20'-0"	46
504	9'-0"	345
505	24'-5"	46
302	21'-10"	243

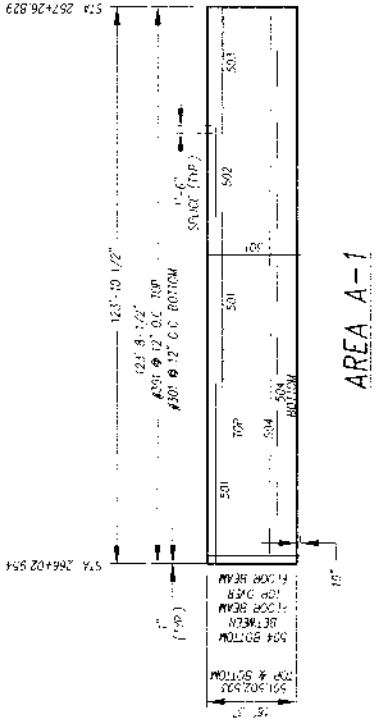

No.	LENGTH	Qty
501	40'-0"	66
502	20'-0"	34
503	28'-3"	34
504	8'-0"	255
301	17'-0"	247

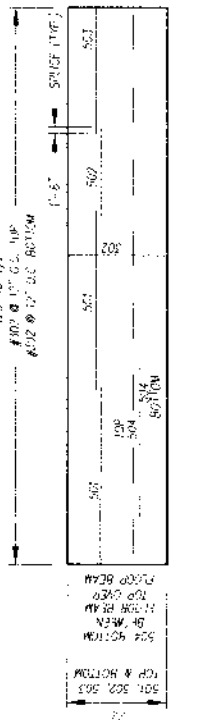


No.	LENGTH	Qty
501	40'-0"	52
502	20'-0"	46
503	28'-3"	46
504	8'-0"	345
302	21'-10"	247

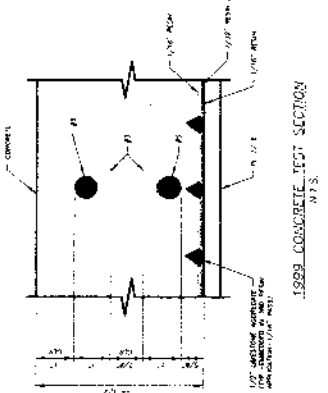

No.	Qty	LENGTH
301	609	17'-0"
501	170	40'-0"
502	68	20'-0"
503	14	28'-3"
504	510	8'-0"
505	34	25'-4"
506	17	18'-6"

No.	Qty	LENGTH
302	609	17'-0"
501	230	40'-0"
502	97	20'-0"
503	46	28'-3"
504	665	8'-0"
505	40	25'-4"
506	29	18'-6"

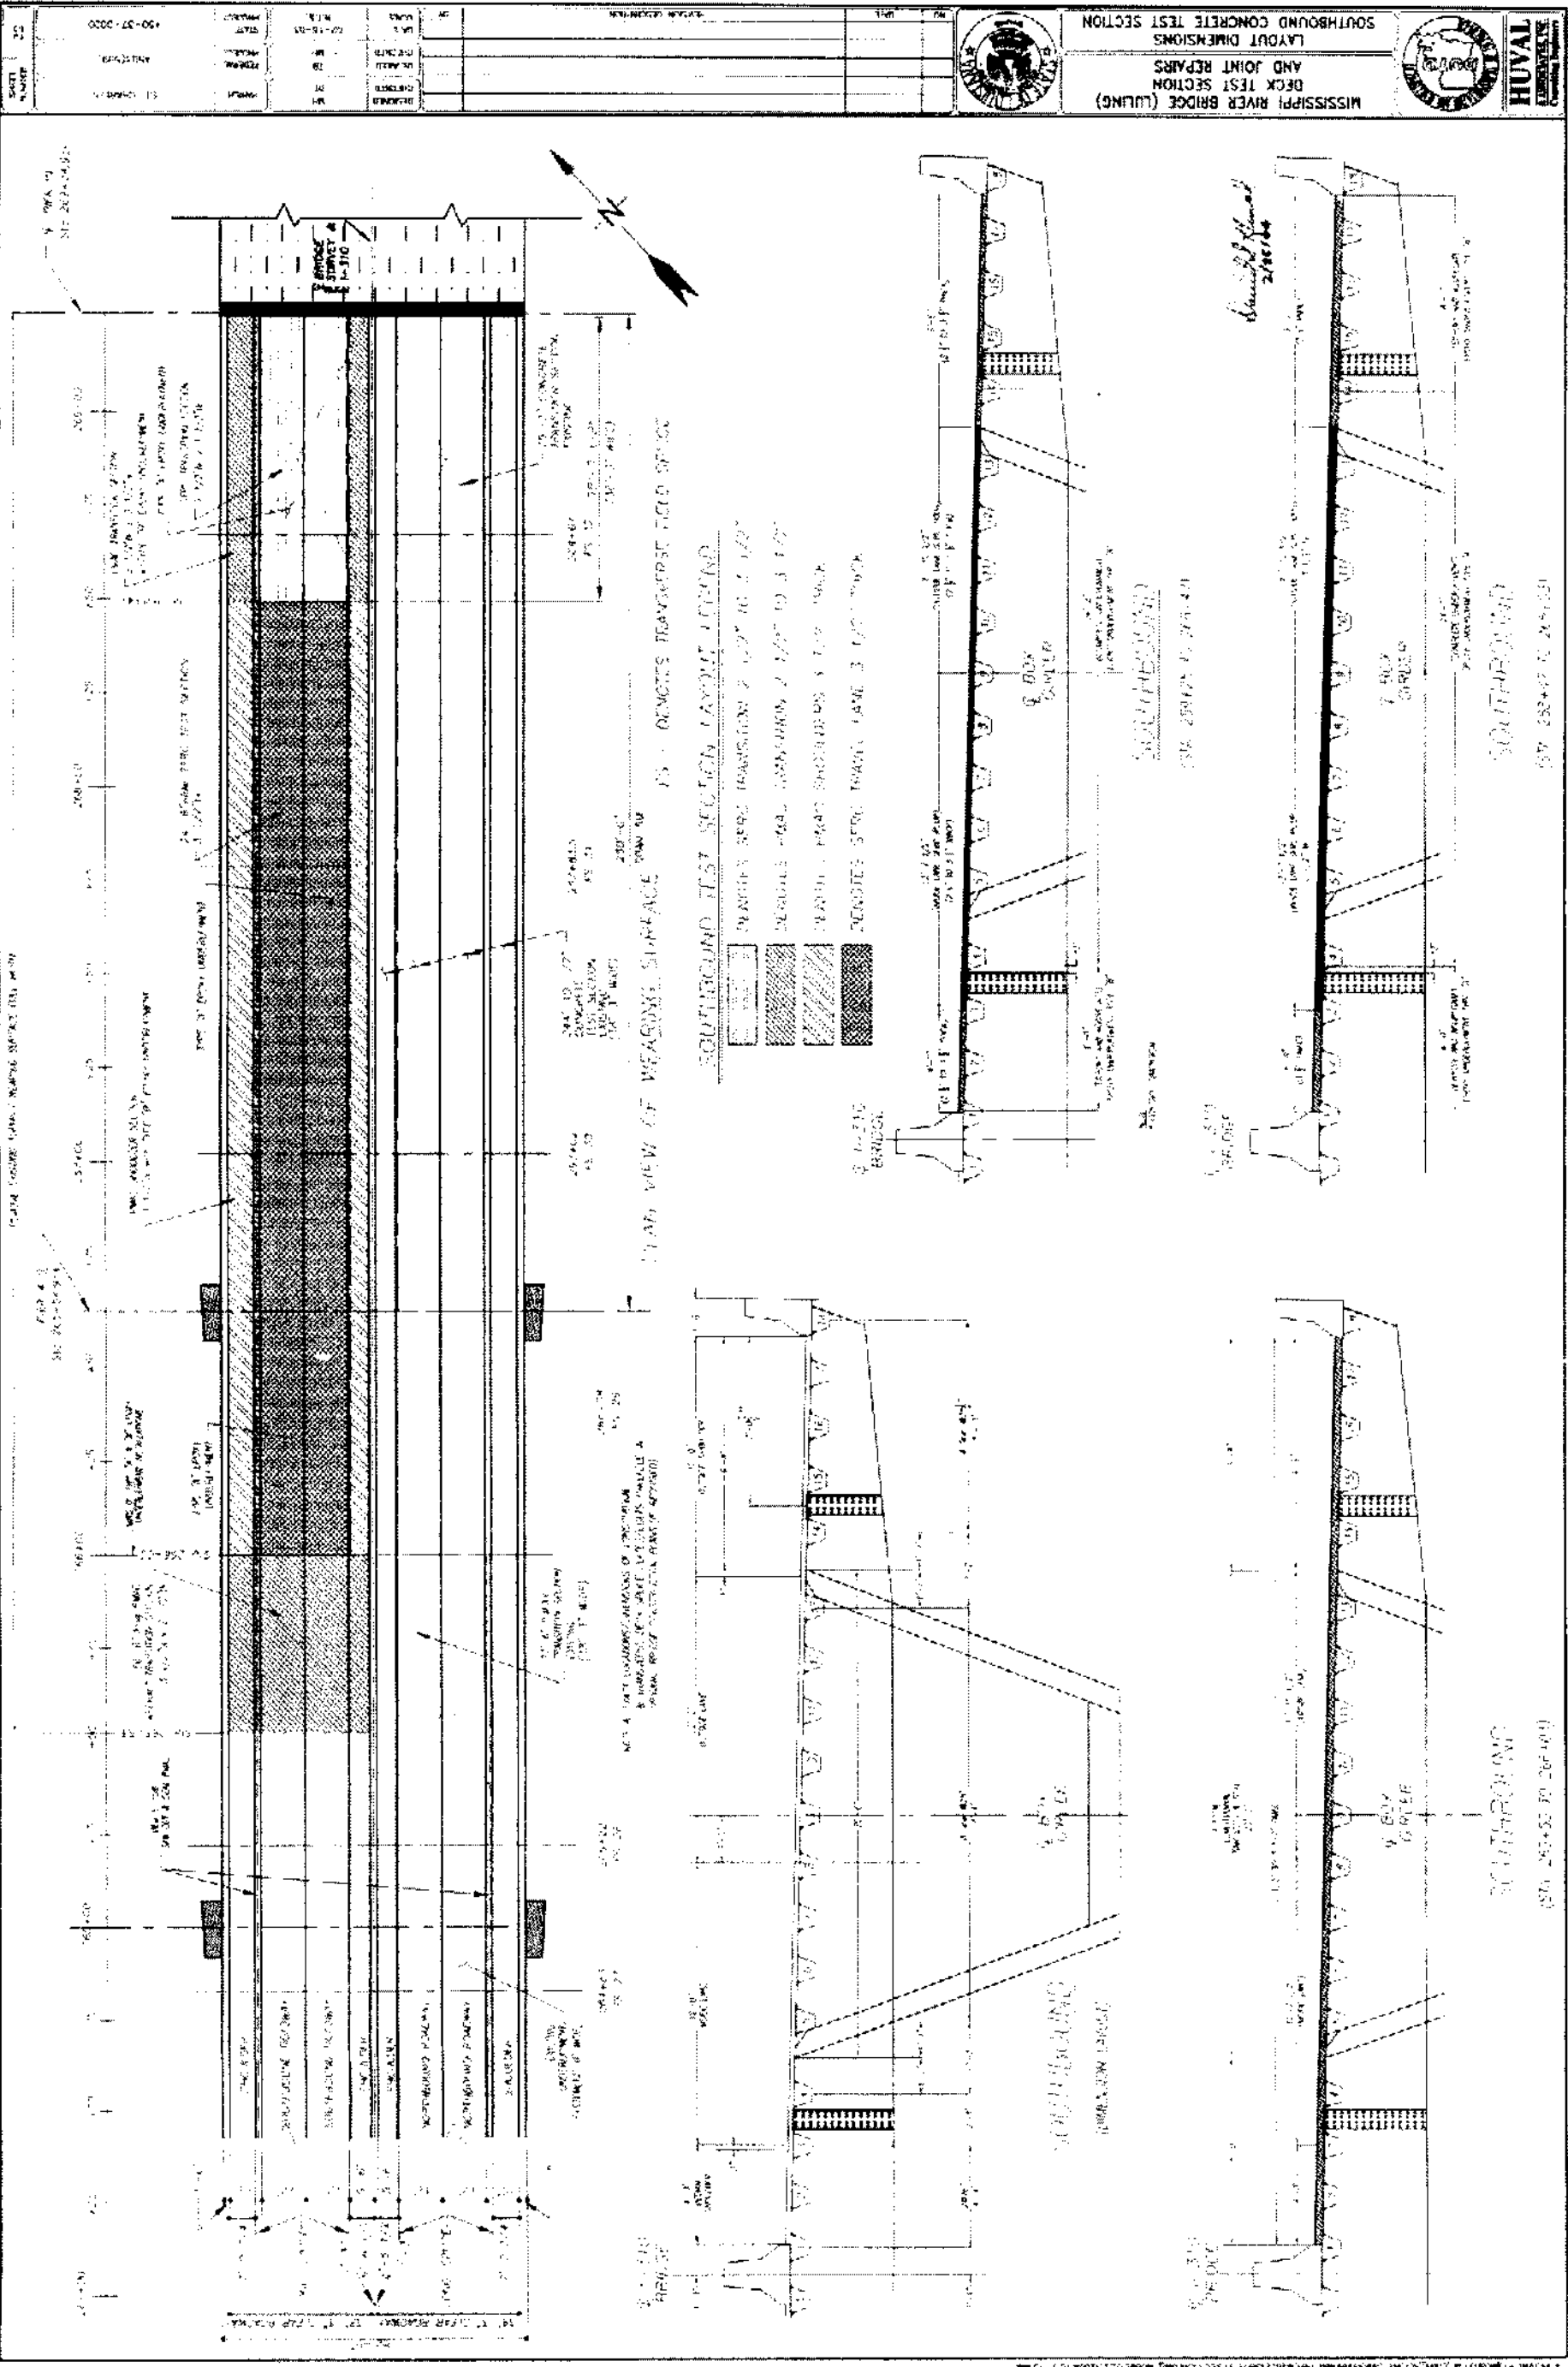

SHEET NUMBER	23
NO.	
DATE	
REVISION DESCRIPTION	
BY	
DATE	
SCALE	
CHECKED	
DATE	
DESIGNED	
DATE	
CHECKED	
DATE	
PROJECT	450-37-0020
STATE	4503(509)
FEDERAL	ST. CHARLES
PARISH	
DT	
MT	
BT	




MISSISSIPPI RIVER BRIDGE (LULING)
DECK TEST SECTION
AND JOINT REPAIRS
TYPICAL SOUTHBOUND TEST SECTIONS
SOUTHBOUND CONCRETE TEST SECTIONS




HUVAL
ASSOCIATES, INC.
Consulting Engineers


David H. Huval
2/25/04

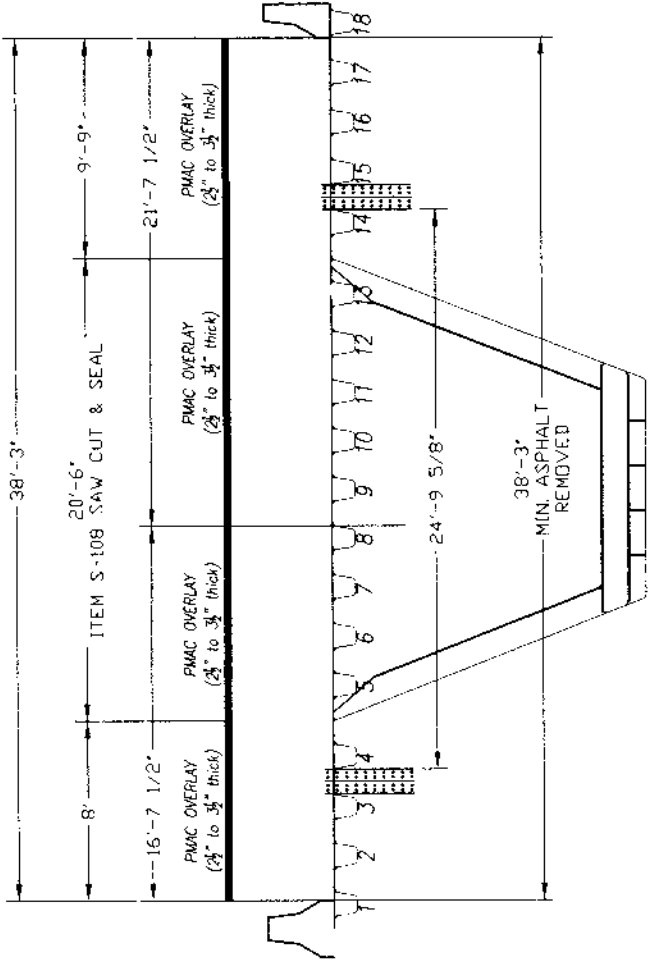

UNDERLAYMENT, SFRC POURS, & PMAC OVERLAY LIMITS
(Stn. 266+03 to 265+53)

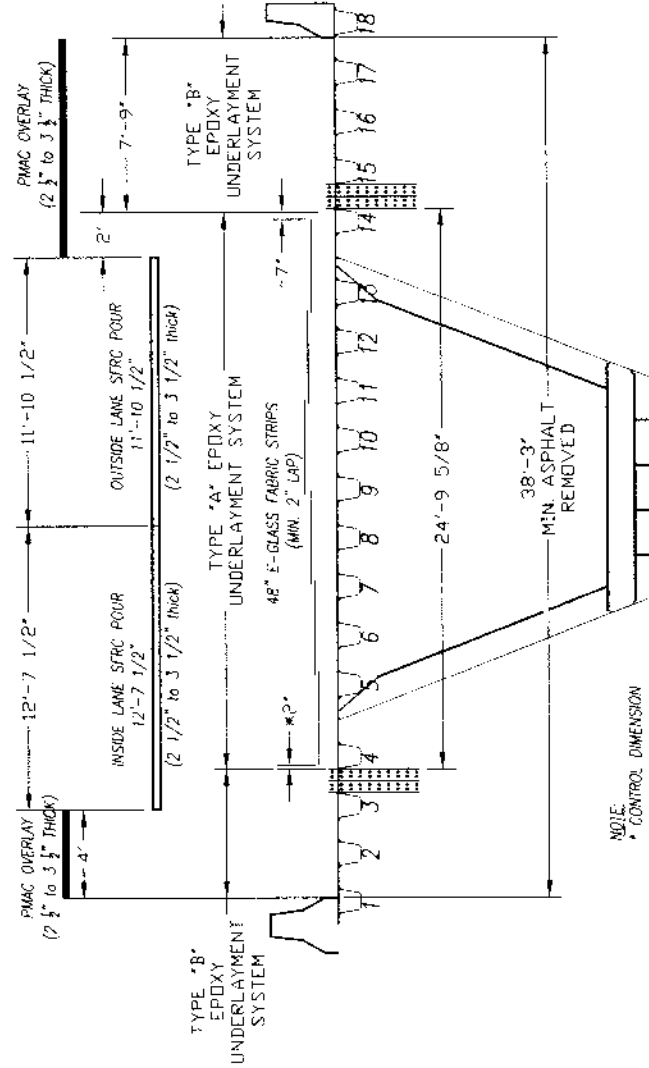

UNDERLAYMENT, SFRC POURS, & PMAC OVERLAY LIMITS
(Stn. 269+25 to 268+47)

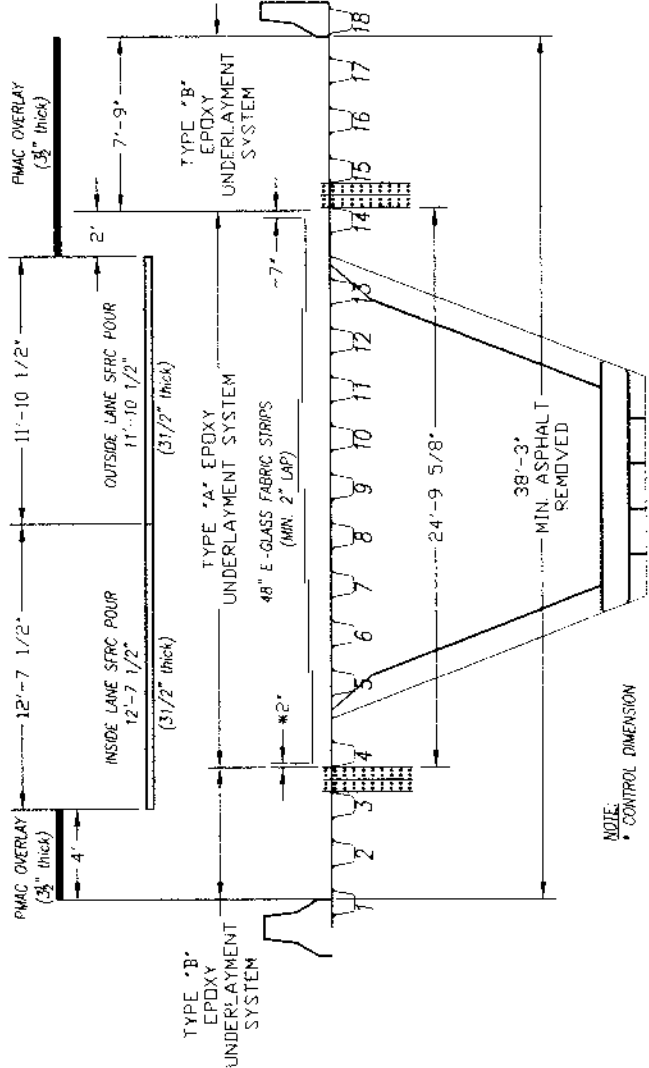

UNDERLAYMENT, SFRC POURS, & PMAC OVERLAY LIMITS
(Stn. 268+47 to 266+03)



MISSISSIPPI RIVER BRIDGE (LULING)
DECK TEST SECTION
AND JOINT REPAIRS
TRANSVERSE SECTIONS
SOUTHBOUND CONCRETE TEST SECTIONS

NO	DATE	REVISION DESCRIPTION	BY
DESIGNED	MHM	DFT	PARTISH
CHECKED			
DETAILED	TB	PROJECT	
CHECKED	MHM	PROJECT	\$503(\$09)
SCALE	1:2-11-02	STATE PROJECT	450-37-0020
DATE	12-11-02	N.T.S.	

SHEET NUMBER 24

QUANTITIES
SOUTHBOUND STA. 269+25 TO 265+53

ASPHALT REMOVAL
1,581 S.Y.



EPOXY UNDERLAYMENT
TYPE "A"
7,986 S.F.

TYPE "B"
4,330 S.F.

STEEL FIBER	
REINFORCED CONCRETE	
A1 -	16.89 C.Y.
A2 -	15.81 C.Y.
B1 -	16.50 C.Y.
B2 -	15.52 C.Y.
C1 -	9.02 C.Y.
C2 -	8.48 C.Y.
	82.22 C.Y.

PMAC	
INSIDE LANE -	43.64 TONS
OUTSIDE LANE -	<u>88.24 TONS</u>
	131.88 TONS


David H. Howard
2/25/04

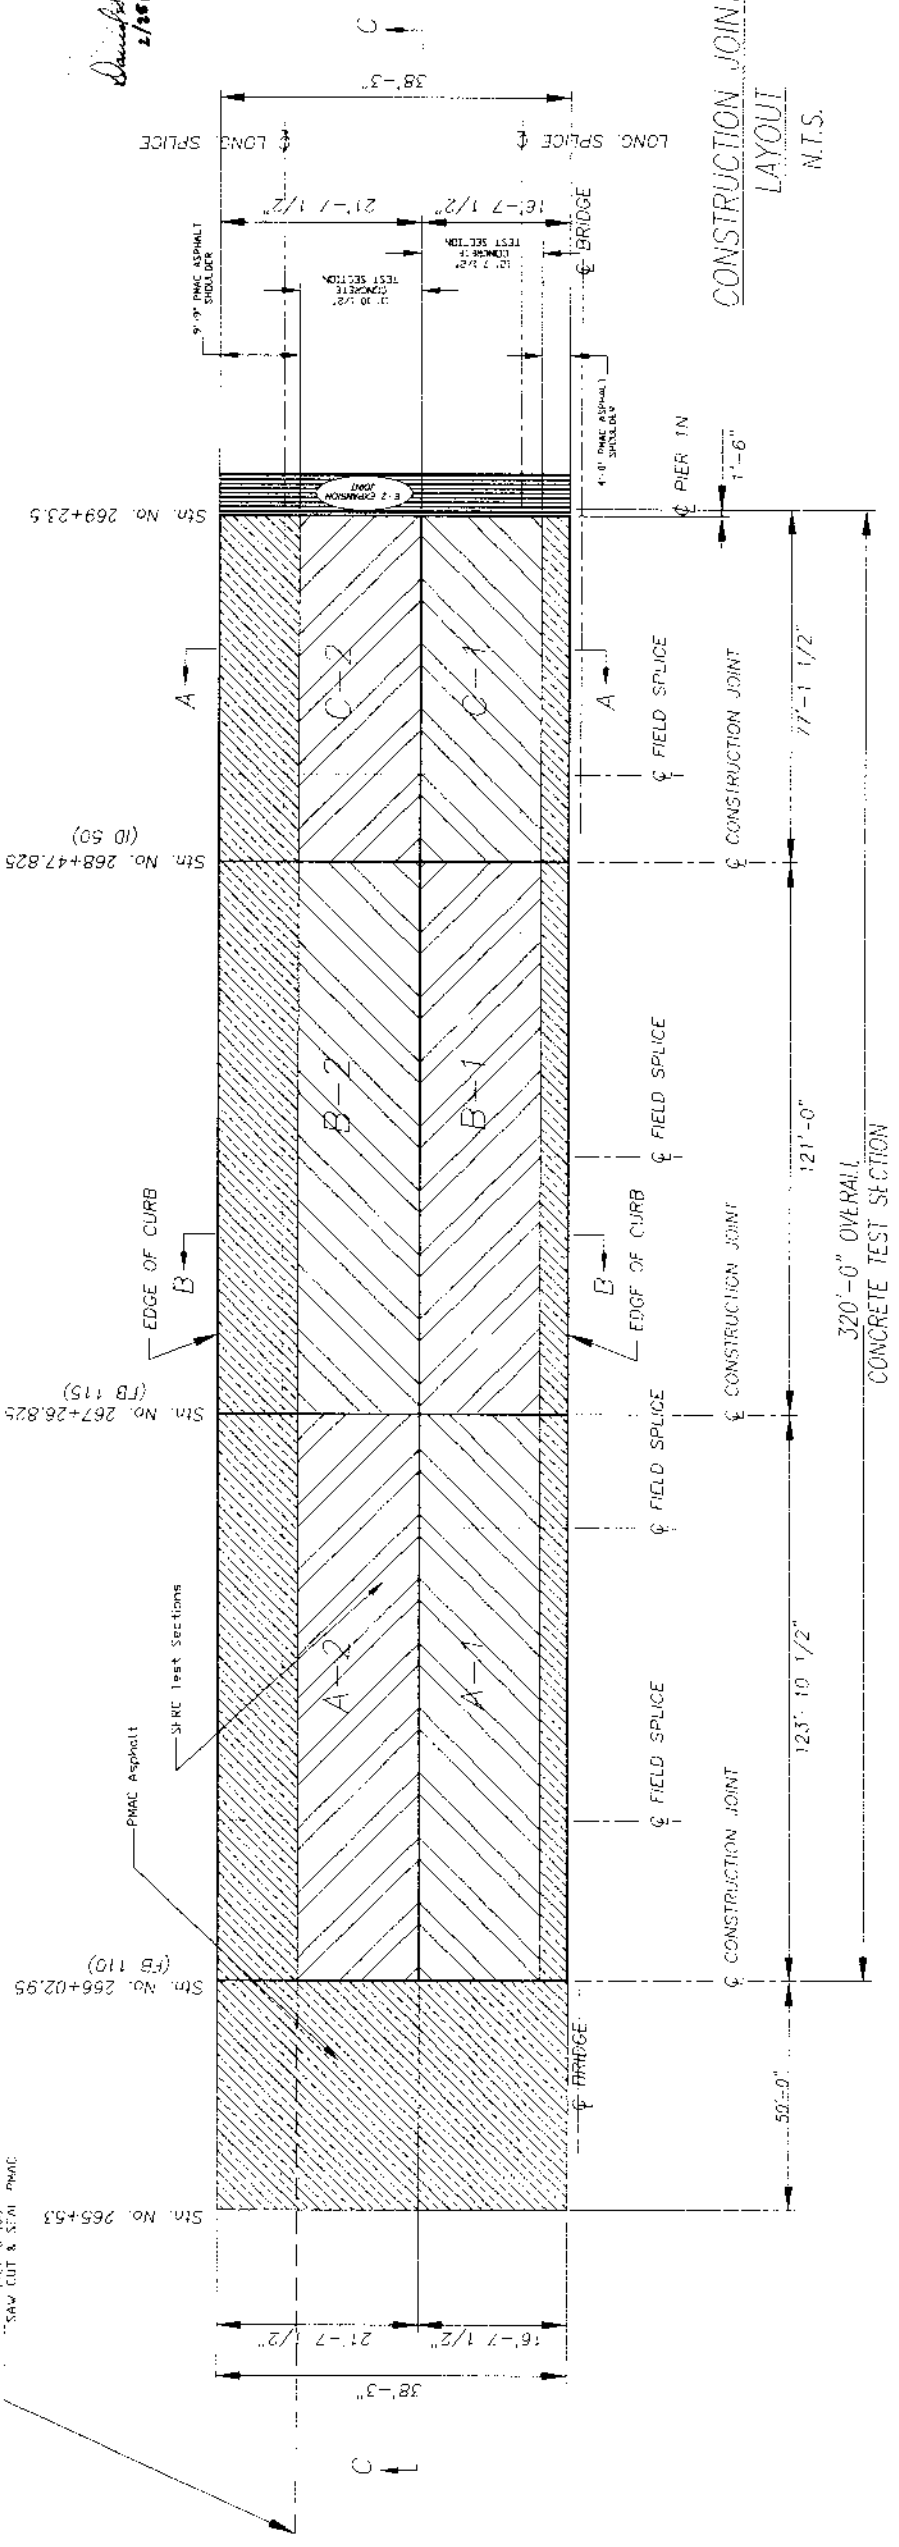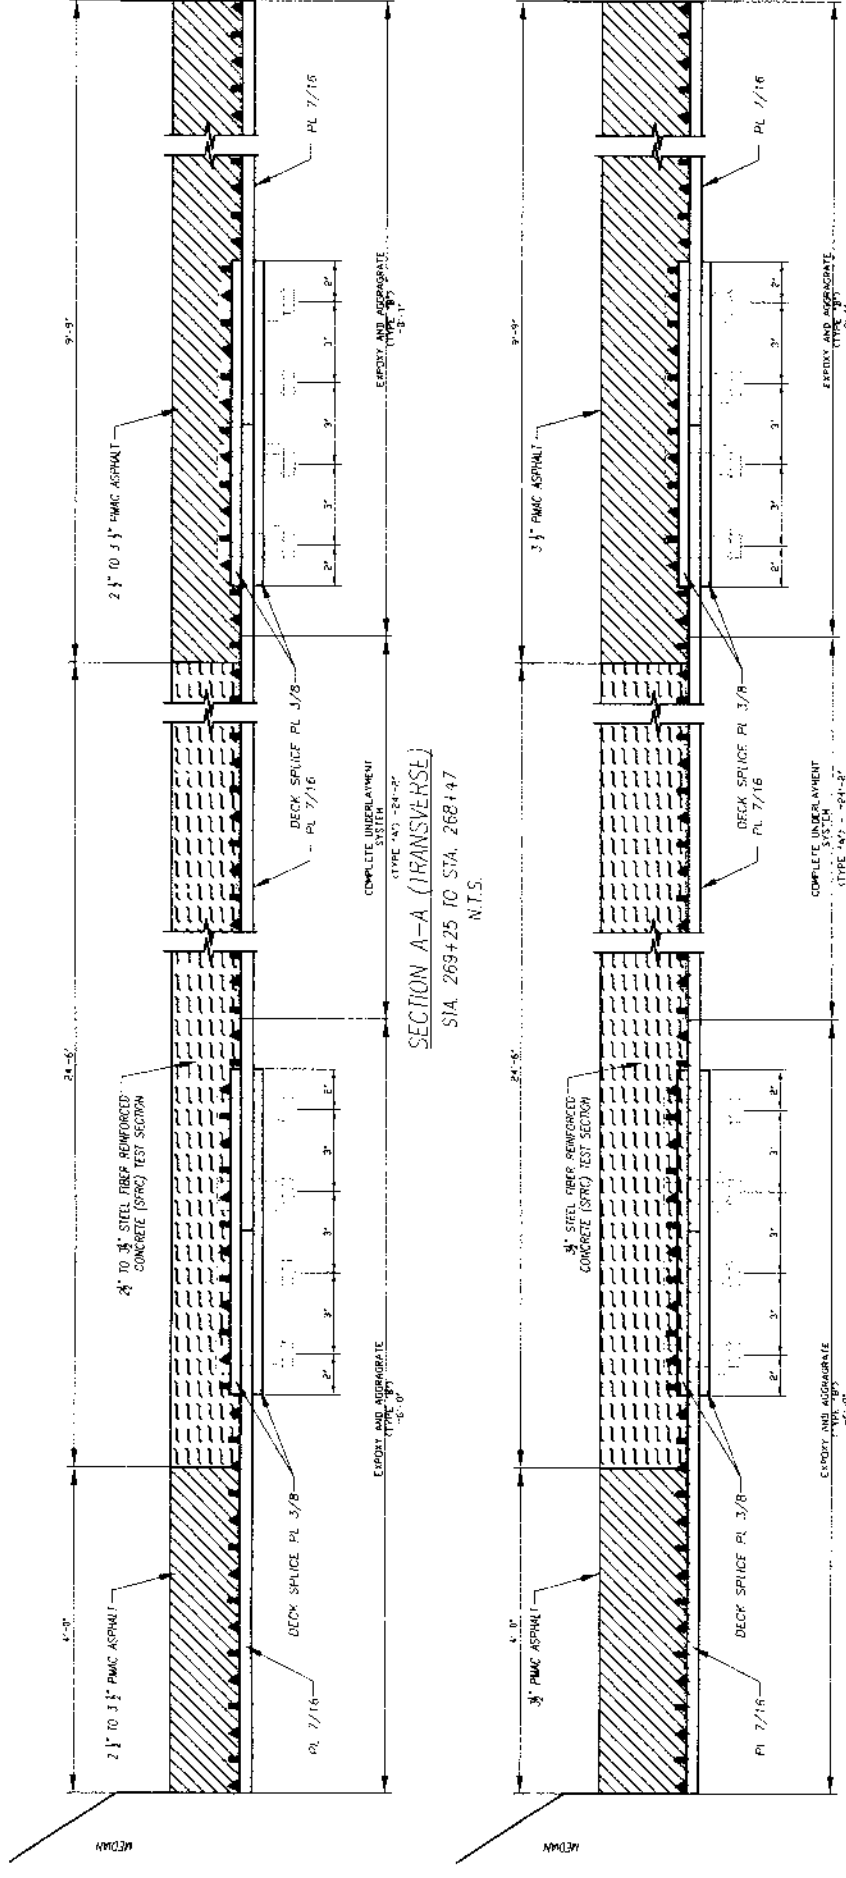


DESIGNED	CH 07	MM	12-11-02	DATE	12-11-02	PROJECT	450-37-0020	SHEET NUMBER	25
CHECKED	CH 07	MM	12-11-02	DATE	12-11-02	PROJECT	450-37-0020		
DESIGNED	CH 07	MM	12-11-02	DATE	12-11-02	PROJECT	450-37-0020		
CHECKED	CH 07	MM	12-11-02	DATE	12-11-02	PROJECT	450-37-0020		
DESIGNED	CH 07	MM	12-11-02	DATE	12-11-02	PROJECT	450-37-0020		
CHECKED	CH 07	MM	12-11-02	DATE	12-11-02	PROJECT	450-37-0020		
DESIGNED	CH 07	MM	12-11-02	DATE	12-11-02	PROJECT	450-37-0020		
CHECKED	CH 07	MM	12-11-02	DATE	12-11-02	PROJECT	450-37-0020		
DESIGNED	CH 07	MM	12-11-02	DATE	12-11-02	PROJECT	450-37-0020		
CHECKED	CH 07	MM	12-11-02	DATE	12-11-02	PROJECT	450-37-0020		



MISSISSIPPI RIVER BRIDGE (LULING)
DECK TEST SECTION
AND JOINT REPAIRS
SOUTHBOUND CONCRETE TEST SECTIONS

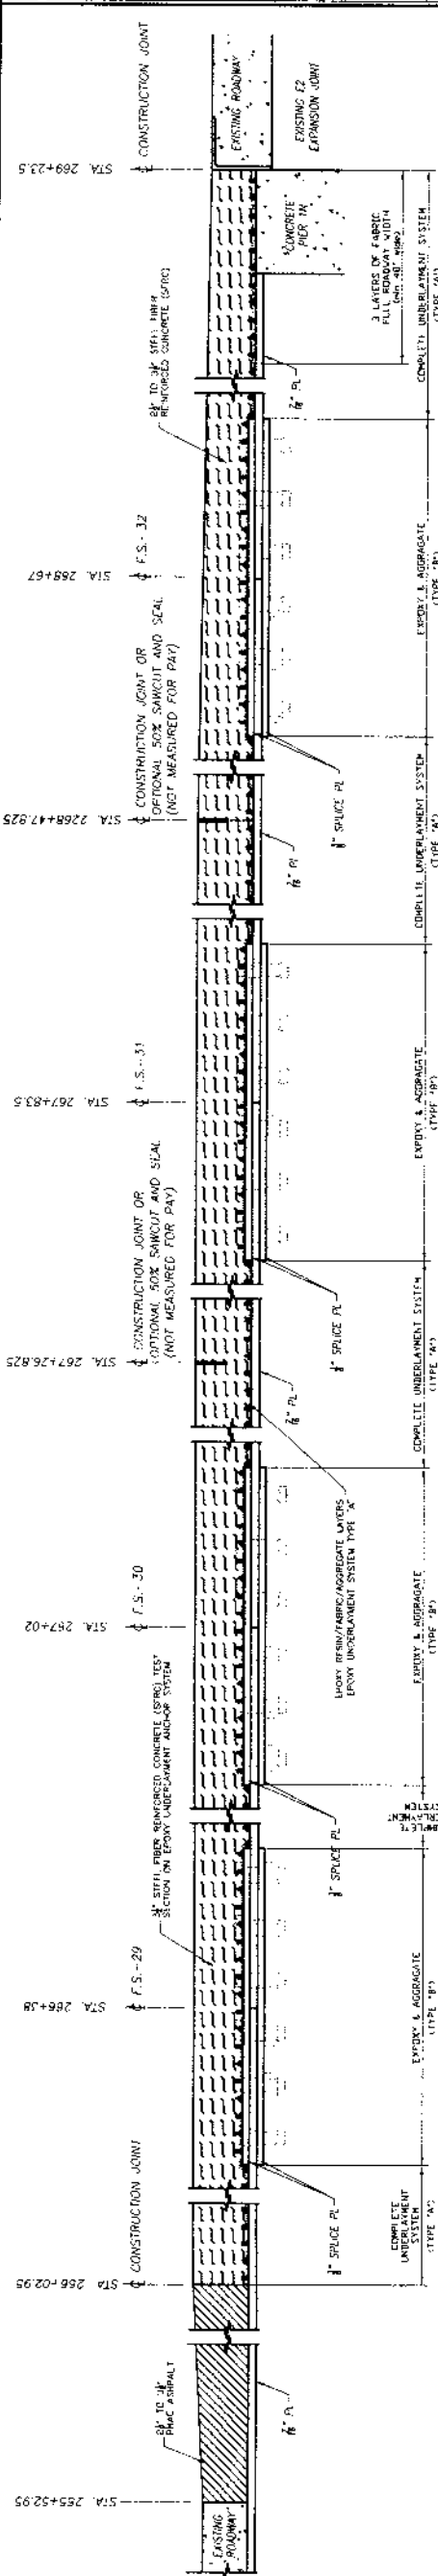


SECTION C-C
(LONGITUDINAL)
N.T.S.

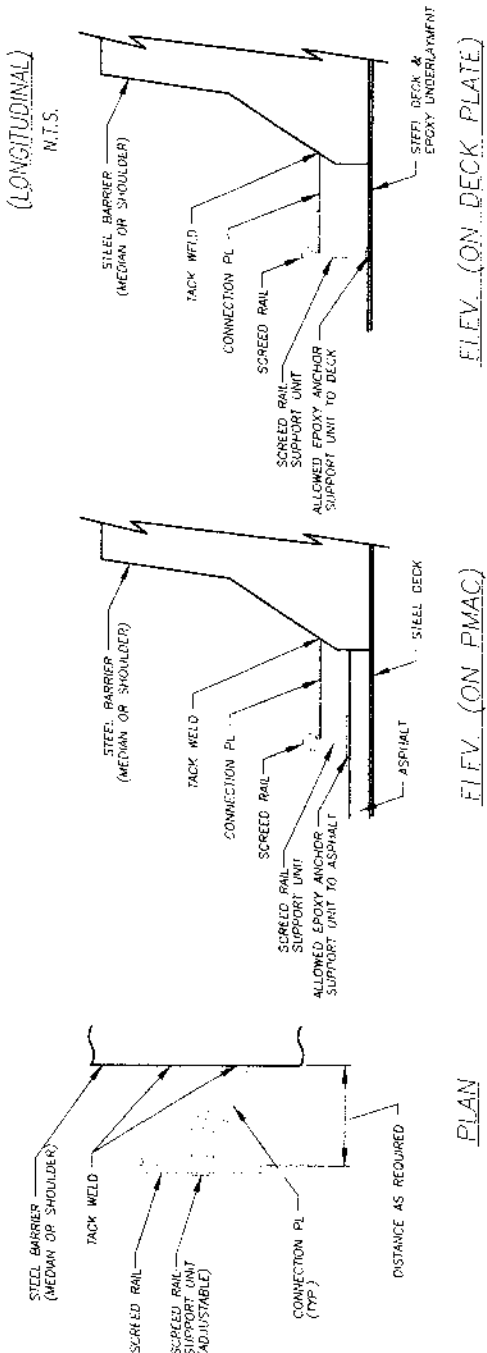


- NOTES
1. THE ADDITIONAL TWO LAYERS OF FABRIC WITHIN THE STIC MOTUS FOR EPOXY UNDERLAYMENT TYPE "X" AND THE ADDITION OF THREE LAYERS OF FABRIC WITHIN THE PMAC SHOULDER FOR EPOXY UNDERLAYMENT TYPE "B" AT STA. 269+25 WILL BE CONSIDERED INCIDENTAL TO THE RESPECTIVE EPOXY UNDERLAYMENT PAY ITEM AND NOT BE MEASURED FOR PAY.
 2. CONTRACTOR TO SUBMIT EDGE FORM DETAIL FOR APPROVAL.

- NOTES
1. WELDING TO ONLY BARRIERS IS ALLOWED.
 2. ADJUST RAIL SUPPORT UNIT TO CORRECT ELEVATION & TACK WELD PLATE TO BARRIER AS REQUIRED.
 3. AFTER REMOVAL OF RAIL UNIT, CRACK & EPOXY PAINT BARRIER WHERE TACK WELDS WERE USED. PAINT WITH COLD SPRAY ZINC RICH OIL-BASED PAINT.
 4. ALL STIC FORM MATERIAL TEMPORARILY BONDED/ANCHORED TO DECK OR UNDERLAYMENT WILL BE COMPLETELY REMOVED PRIOR TO BEING COVERED WITH STIC.

David H. Hual
2/25/04

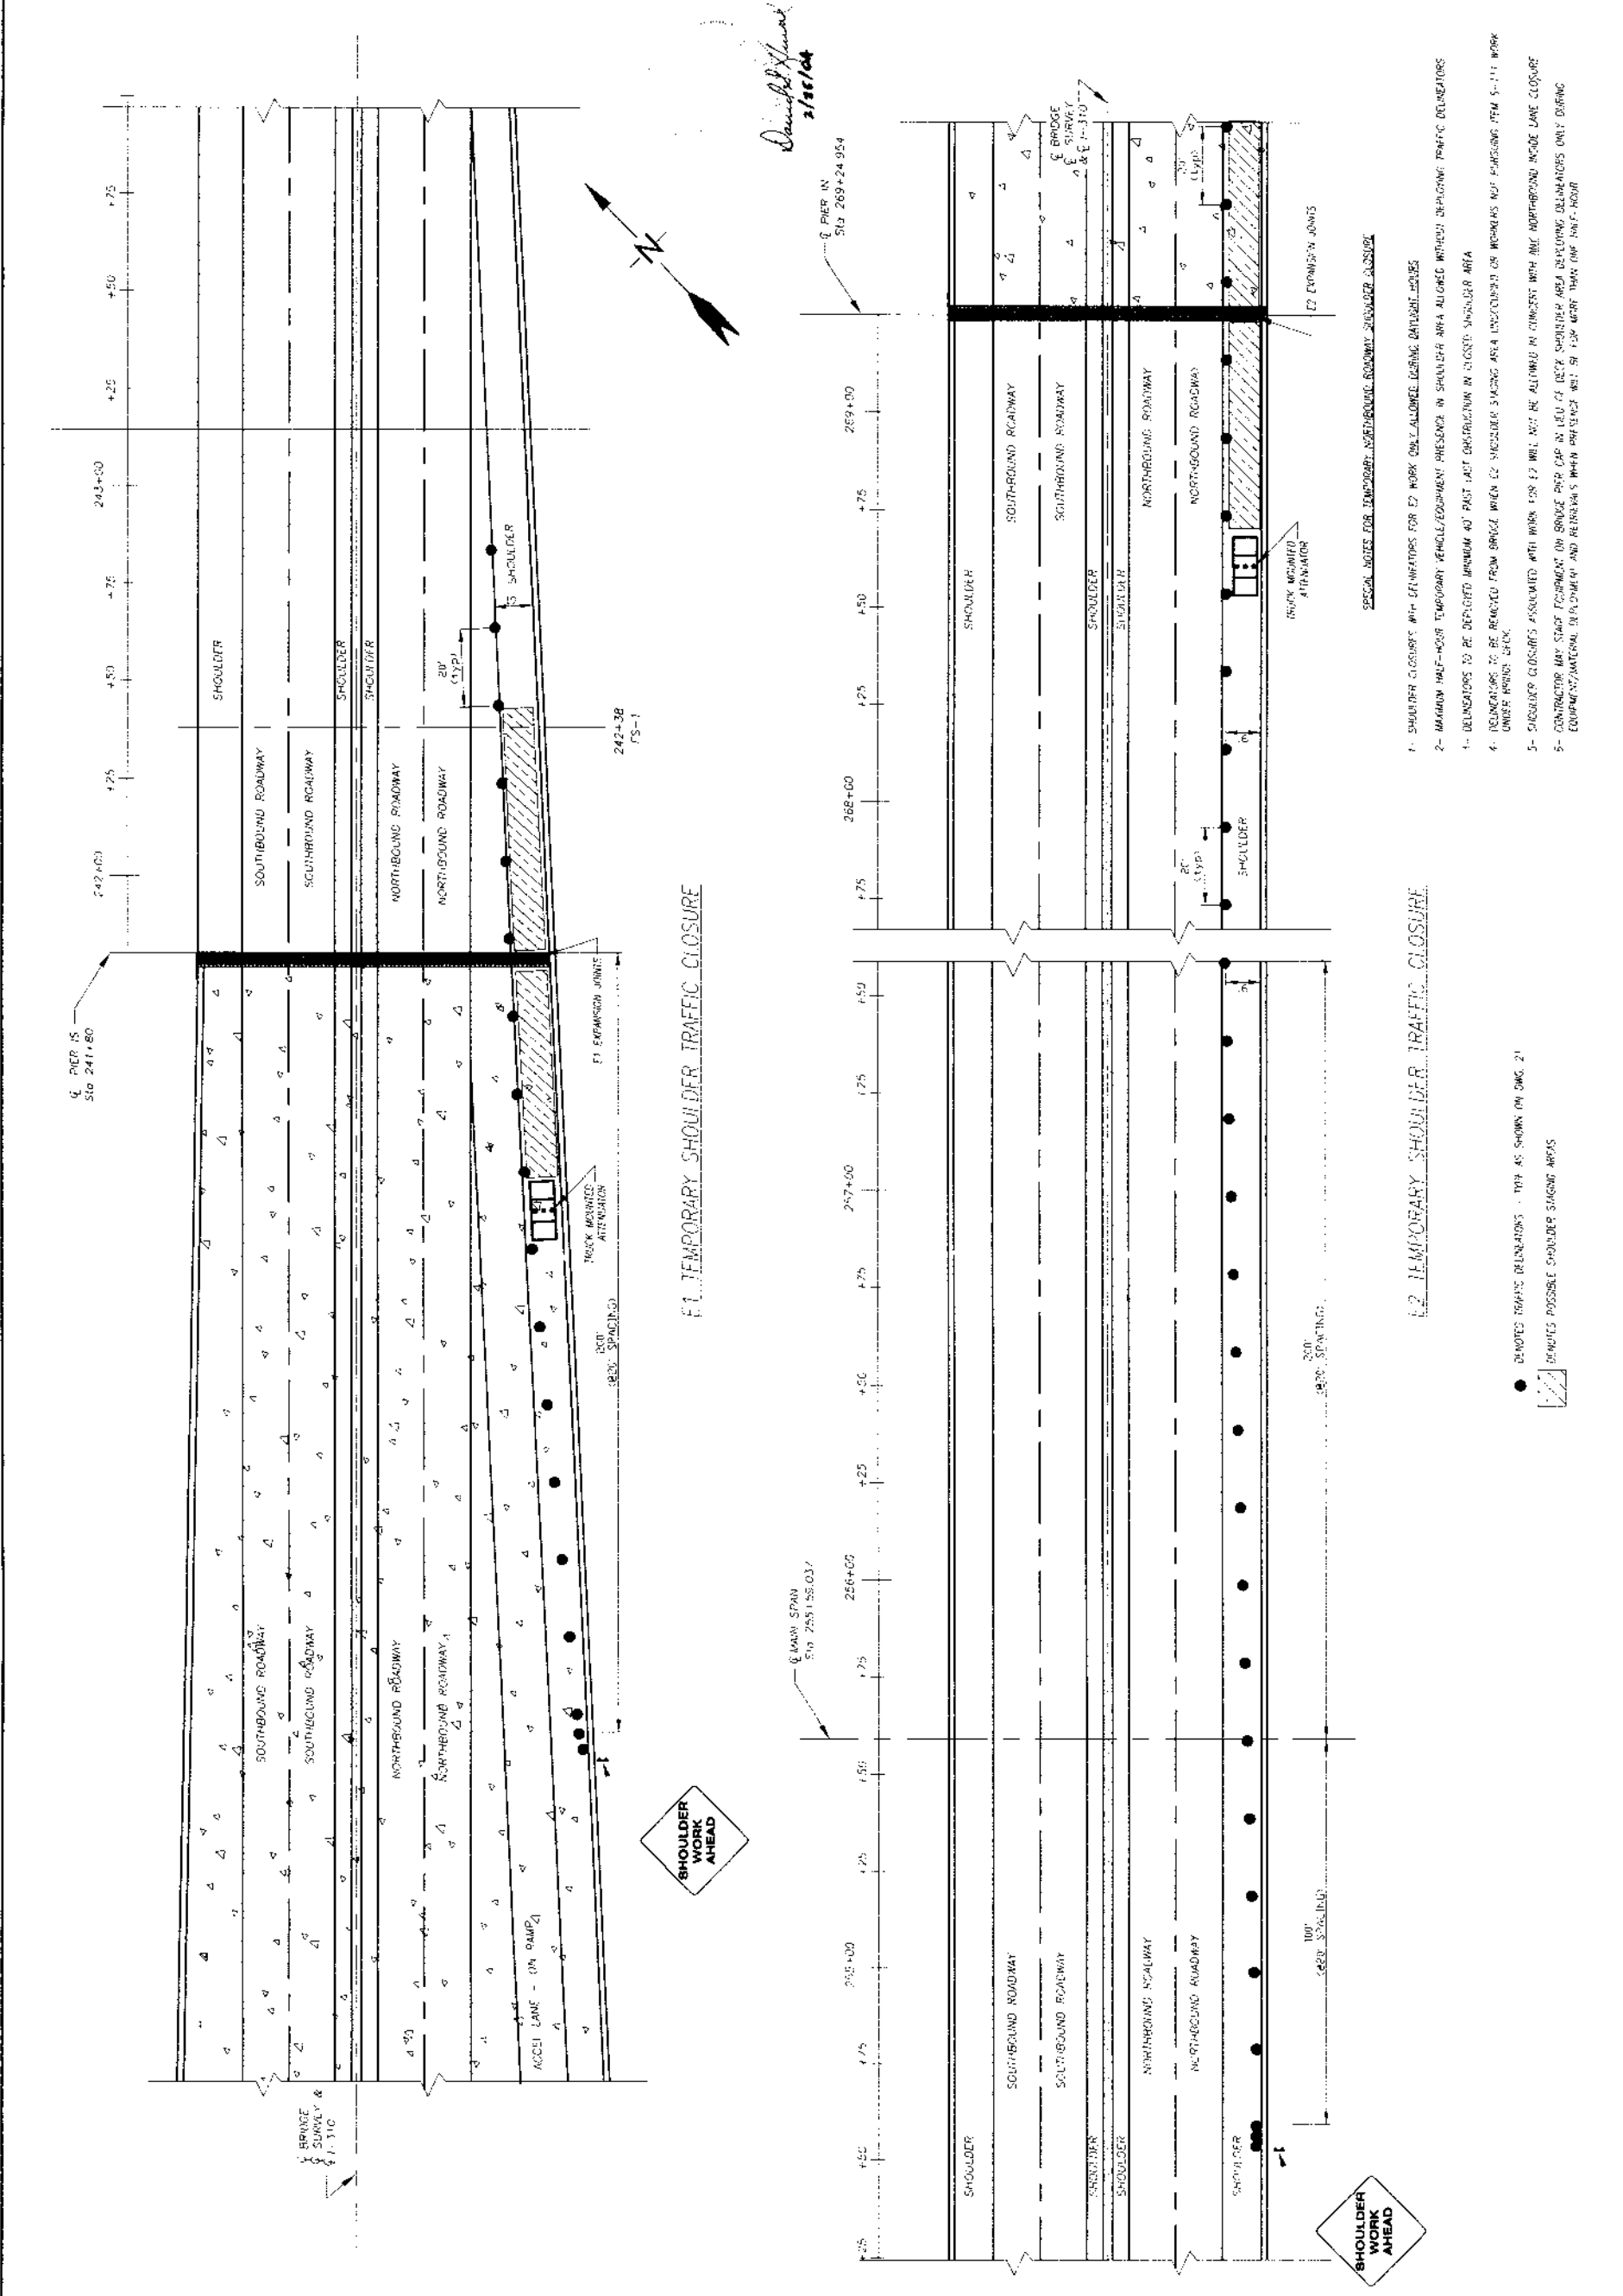

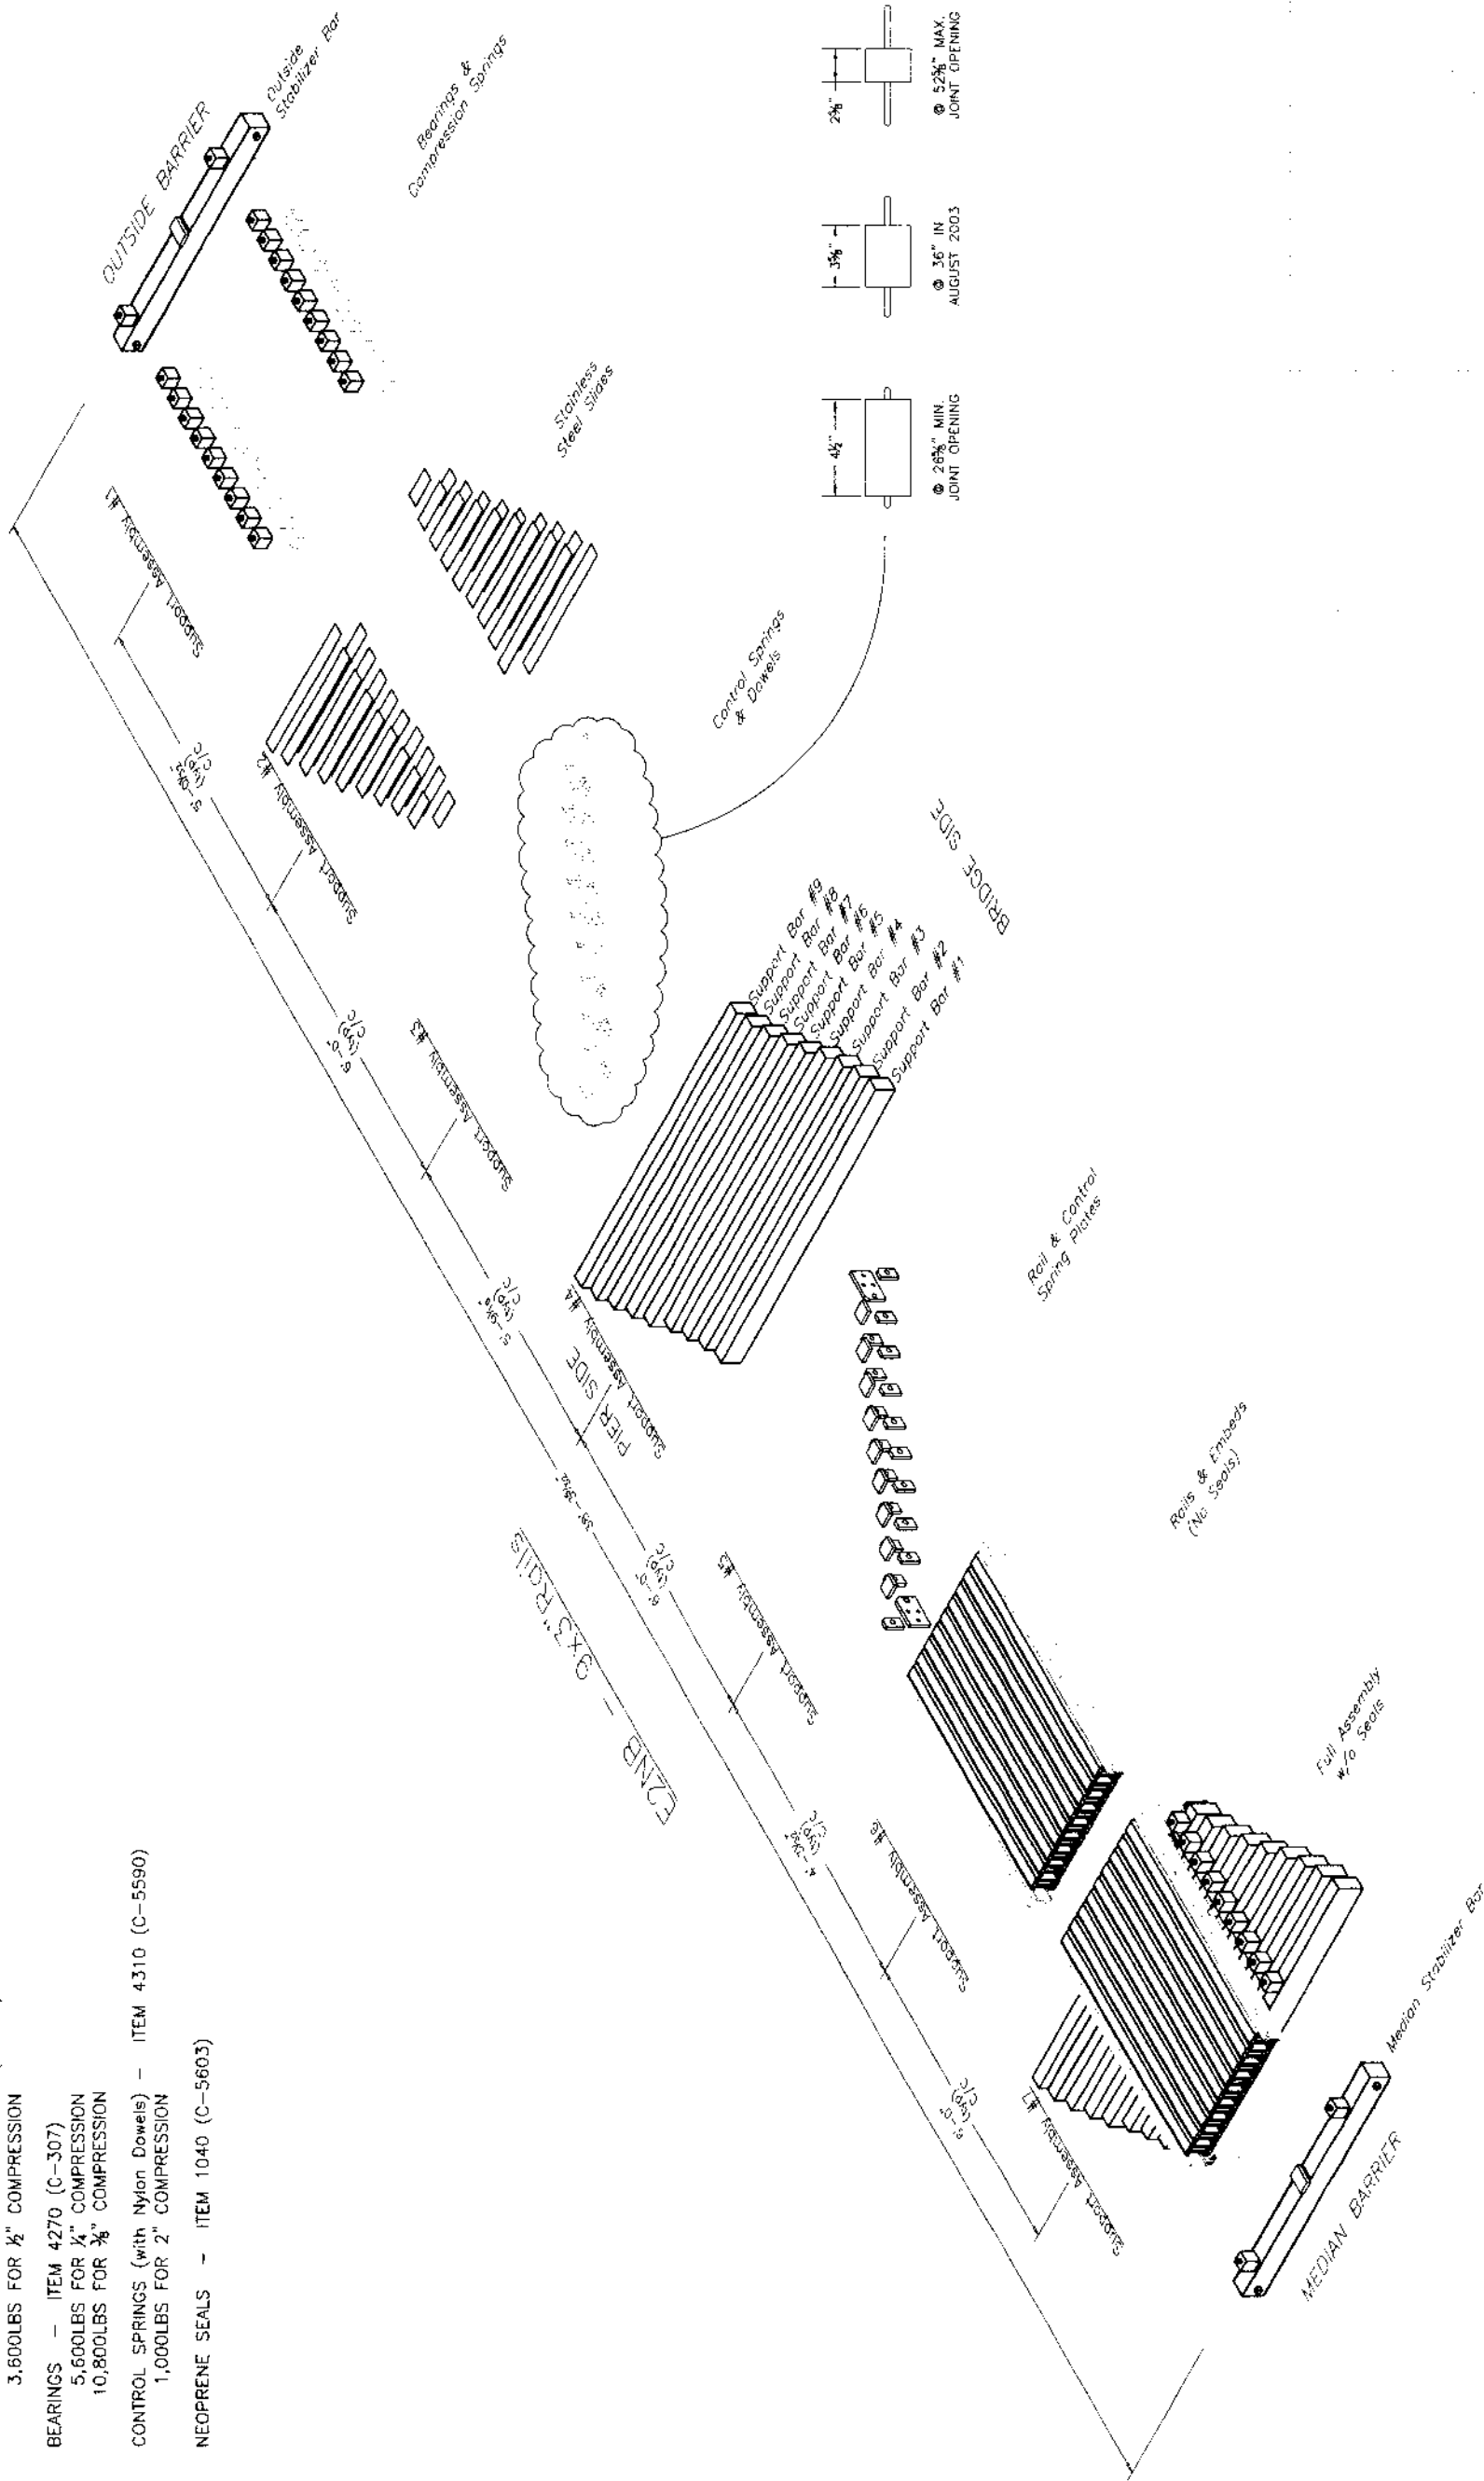

SEE REFERENCE DRAWING SHEETS 103-104 & SHOP DRAWING SHEETS 117-126
COMPRESSION SPRINGS - ITEM 4260 (C-306)
3,600LBS FOR $\frac{1}{2}$ " COMPRESSION

BEARINGS - ITEM 4270 (C-307)
5,600LBS FOR $\frac{1}{4}$ " COMPRESSION
10,800LBS FOR $\frac{3}{8}$ " COMPRESSION

CONTROL SPRINGS (with Nylon Dowels) - ITEM 4310 (C-5590)
1,000LBS FOR 2" COMPRESSION

NEOPRENE SEALS - ITEM 1040 (C-5603)

David P. Hunt
2/25/04

EAST BANK E2: (SOUTHBOUND)
SPECIFIC REPAIR LIST


- SF1- REPLACE ALL EIGHT CONTROL SPRINGS & DOWELS
- SF2- REPLACE ALL EIGHT CONTROL SPRINGS & DOWELS
ROTATE BRIDGE BEARING @ SB2 & 3
- SF3- ~~REPLACE ALL EIGHT CONTROL SPRINGS & DOWELS~~
ROTATE PIER BEARING @ SB1.2 & 5
ROTATE BRIDGE BEARING @ SB2.3 & 5
- SF4- ~~REPLACE ALL EIGHT CONTROL SPRINGS & DOWELS~~
ROTATE PIER BEARING @ SB4 & 5
ROTATE BRIDGE BEARING @ SB3
- SF5- ~~REPLACE ALL EIGHT CONTROL SPRINGS & DOWELS~~
ROTATE PIER BEARING @ SB3 & 5
ROTATE BRIDGE BEARING @ SB1.2 & 4
- SF6- REPLACE ALL EIGHT CONTROL SPRINGS & DOWELS
ROTATE PIER BEARING @ SB3.4, 6 & 7
ROTATE BRIDGE BEARING @ SB3
REPLACE BRIDGE BEARING @ SB2
- SF7- REPLACE ALL EIGHT CONTROL SPRINGS & DOWELS
- REPLACE SEAL #5 & #6
- CLEAN RAIL INSERT AND REPAIR/REINSTALL 8' OF SEAL #3 (FROM 6' TO 14' FROM MEDIAN)

SUMMARY:

- REPLACE 5% CONTROL SPRINGS & DOWELS- ~~56ea~~ 32ea.
- REPLACE BEARINGS- 1ea.
- ROTATE BEARINGS- 21ea.
- REPLACE SEAL #5 & #6
- CLEAN RAIL INSERT AND REPAIR/REINSTALL 8' OF SEAL #3 (FROM 6' TO 14' FROM MEDIAN)
- FOR BIDDING PURPOSES: *
- REPLACE CONTROL SPRINGS @ ~~56ea~~ 32ea.
- SUPPLY EXTRA CONTROL SPRINGS @ 10ea.
- REPLACE BEARINGS @ 32ea.
- ROTATE BEARINGS @ 32ea
- REPLACE SEAL #5 & #6
- CLEAN RAIL INSERT AND REPAIR/REINSTALL 8' OF SEAL #3 (FROM 6' TO 14' FROM MEDIAN)
- RE-RIVET 304 S.S. SLIDES W/ 304 S.S. RE-RIVETS @ 6ea.
- CLEAN ALL SEALS OF FOREIGN MATERIALS.

** EMERGENCY REPAIRS DURING FEBRUARY 2004 HAVE REPLACED THESE 24 UNITS. CONTRACTOR IS TO EXERCISE CAUTION WHILE REPLACING THE REMAINING UNITS SO AS NOT TO DAMAGE THESE EXISTING NEW UNITS.

* ENGINEER TO IDENTIFY ADDITIONAL WORK SCOPE BEYOND SUMMARY NOTED.

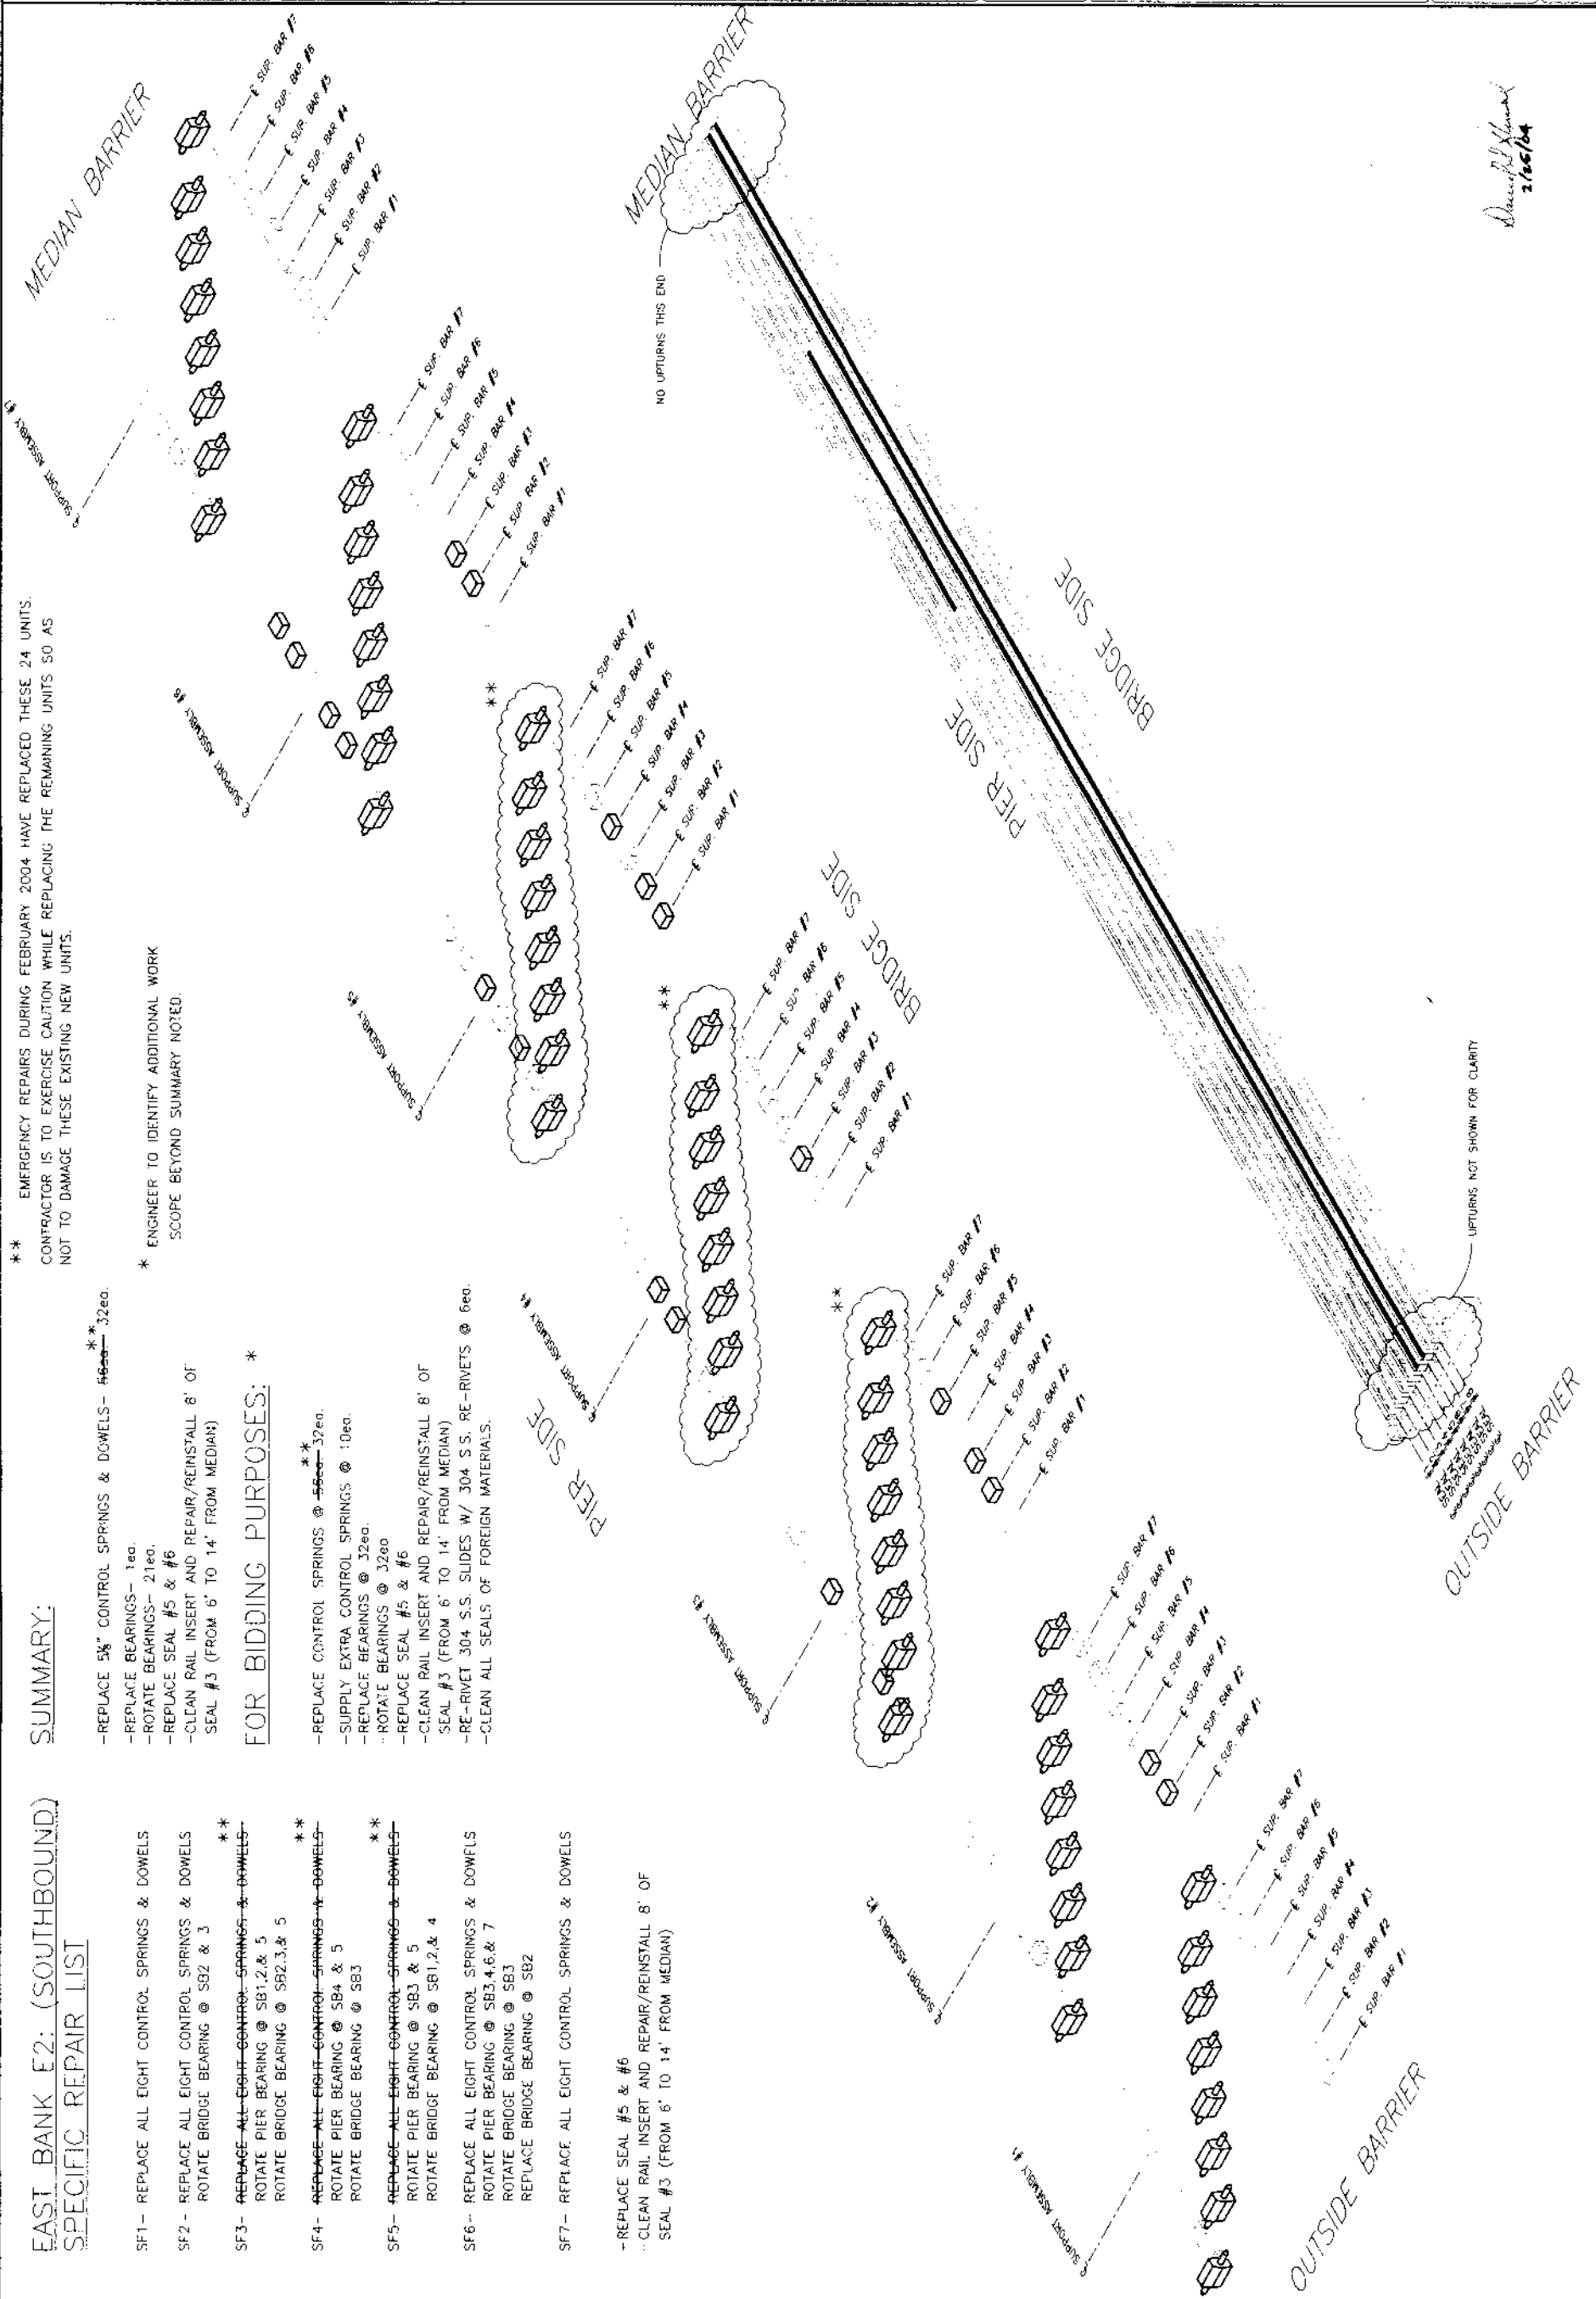

NO.	DATE	REVISION DESCRIPTION	BY	SCALE	DATE	PROJECT	STATE	PROJECT	ST. CHARLES
1	12-11-02	12-11-02	12-11-02	12-11-02	12-11-02	12-11-02	12-11-02	12-11-02	12-11-02
2	12-11-02	12-11-02	12-11-02	12-11-02	12-11-02	12-11-02	12-11-02	12-11-02	12-11-02
2/6/04



MISSISSIPPI RIVER BRIDGE (LULING)
DECK TEST SECTION
AND JOINT REPAIRS
SPECIFIC REPAIR DETAILS
E2 SOUTHBOUND



EAST BANK E2: (NORTHBOUND)
SPECIFIC REPAIR LIST

- SF1- REPLACE ALL TEN CONTROL SPRINGS & DOWELS
- SF2- REPLACE ALL TEN CONTROL SPRINGS & DOWELS
ROTATE PIER BEARING @ SB9
REPLACE PIER BEARING @ SB6 & 7
ROTATE BRIDGE BEARING @ SB12.2 & 4
- SF3- REPLACE ALL TEN CONTROL SPRINGS & DOWELS
ROTATE PIER BEARING @ SB5.8, 8. & 9
REPLACE PIER BEARING @ SB2 & 7
ROTATE BRIDGE BEARING @ SB1.2, 6.7, 8. & 9
REPLACE BRIDGE BEARING @ SB4 & 5
- SF4- REPLACE ALL TEN CONTROL SPRINGS & DOWELS
ROTATE PIER BEARING @ SB5 & 6
REPLACE PIER BEARING @ SB3
ROTATE BRIDGE BEARING @ SB6 & 8
REPLACE BRIDGE BEARING @ SB2
- SF5- REPLACE ALL TEN CONTROL SPRINGS & DOWELS
ROTATE PIER BEARING @ SB4 & 5
REPLACE PIER BEARING @ SB6
ROTATE BRIDGE BEARING @ SB2 & 3
REPLACE BRIDGE BEARING @ SB5
- SF6- REPLACE ALL TEN CONTROL SPRINGS & DOWELS
ROTATE PIER BEARING @ SB2.4 & 6
REPLACE PIER BEARING @ SB7
ROTATE BRIDGE BEARING @ SB1.3, 5. & 9
REPLACE BRIDGE BEARING @ SB2
- SF7- REPLACE ALL TEN CONTROL SPRINGS & DOWELS
REPLACE BRIDGE BEARING @ SB4
- CLEAN PLASTIC MOLDING/#10 SEAL RECEIVER AND REATTACH TO SUPPORT BOX # 7
- CLEAN RAIL INSERT AND REPAIR/REINSTALL SEAL #10 (FIRST 15' FROM MEDIAN)


SUMMARY:


- REPLACE 4 1/2" CONTROL SPRINGS & DOWELS-- 63ea.
- REPLACE BEARINGS-- 13ea.
- ROTATE BEARINGS-- 29ea.
- CLEAN AND RE-ATTACH PLASTIC RAIL SEAL MOLDING @ SA#7/SEAL #10
- CLEAN RAIL INSERT AND REPAIR/REINSTALL SEAL #10 (FIRST 15' FROM MEDIAN)



FOR BIDDING PURPOSES: *

- REPLACE CONTROL SPRINGS @ 63ea.
- SUPPLY EXTRA CONTROL SPRINGS @ 10ea.
- REPLACE BEARINGS @ 42ea.
- ROTATE BEARINGS @ 42ea.
- CLEAN RAIL INSERT AND REPAIR/REINSTALL SEAL #10 (FIRST 15' FROM MEDIAN)
- RE-RIVET 304 S.S. SLIDES W/ 304 S.S. RE-RIVETS @ 4ea.
- CLEAN AND RE-ATTACH PLASTIC RAIL SEAL MOLDING @ SA#7/SEAL #10
- CLEAN ALL SEALS OF FOREIGN MATERIALS.

* ENGINEER TO IDENTIFY ADDITIONAL WORK SCOPE BEYOND SUMMARY NOTED.

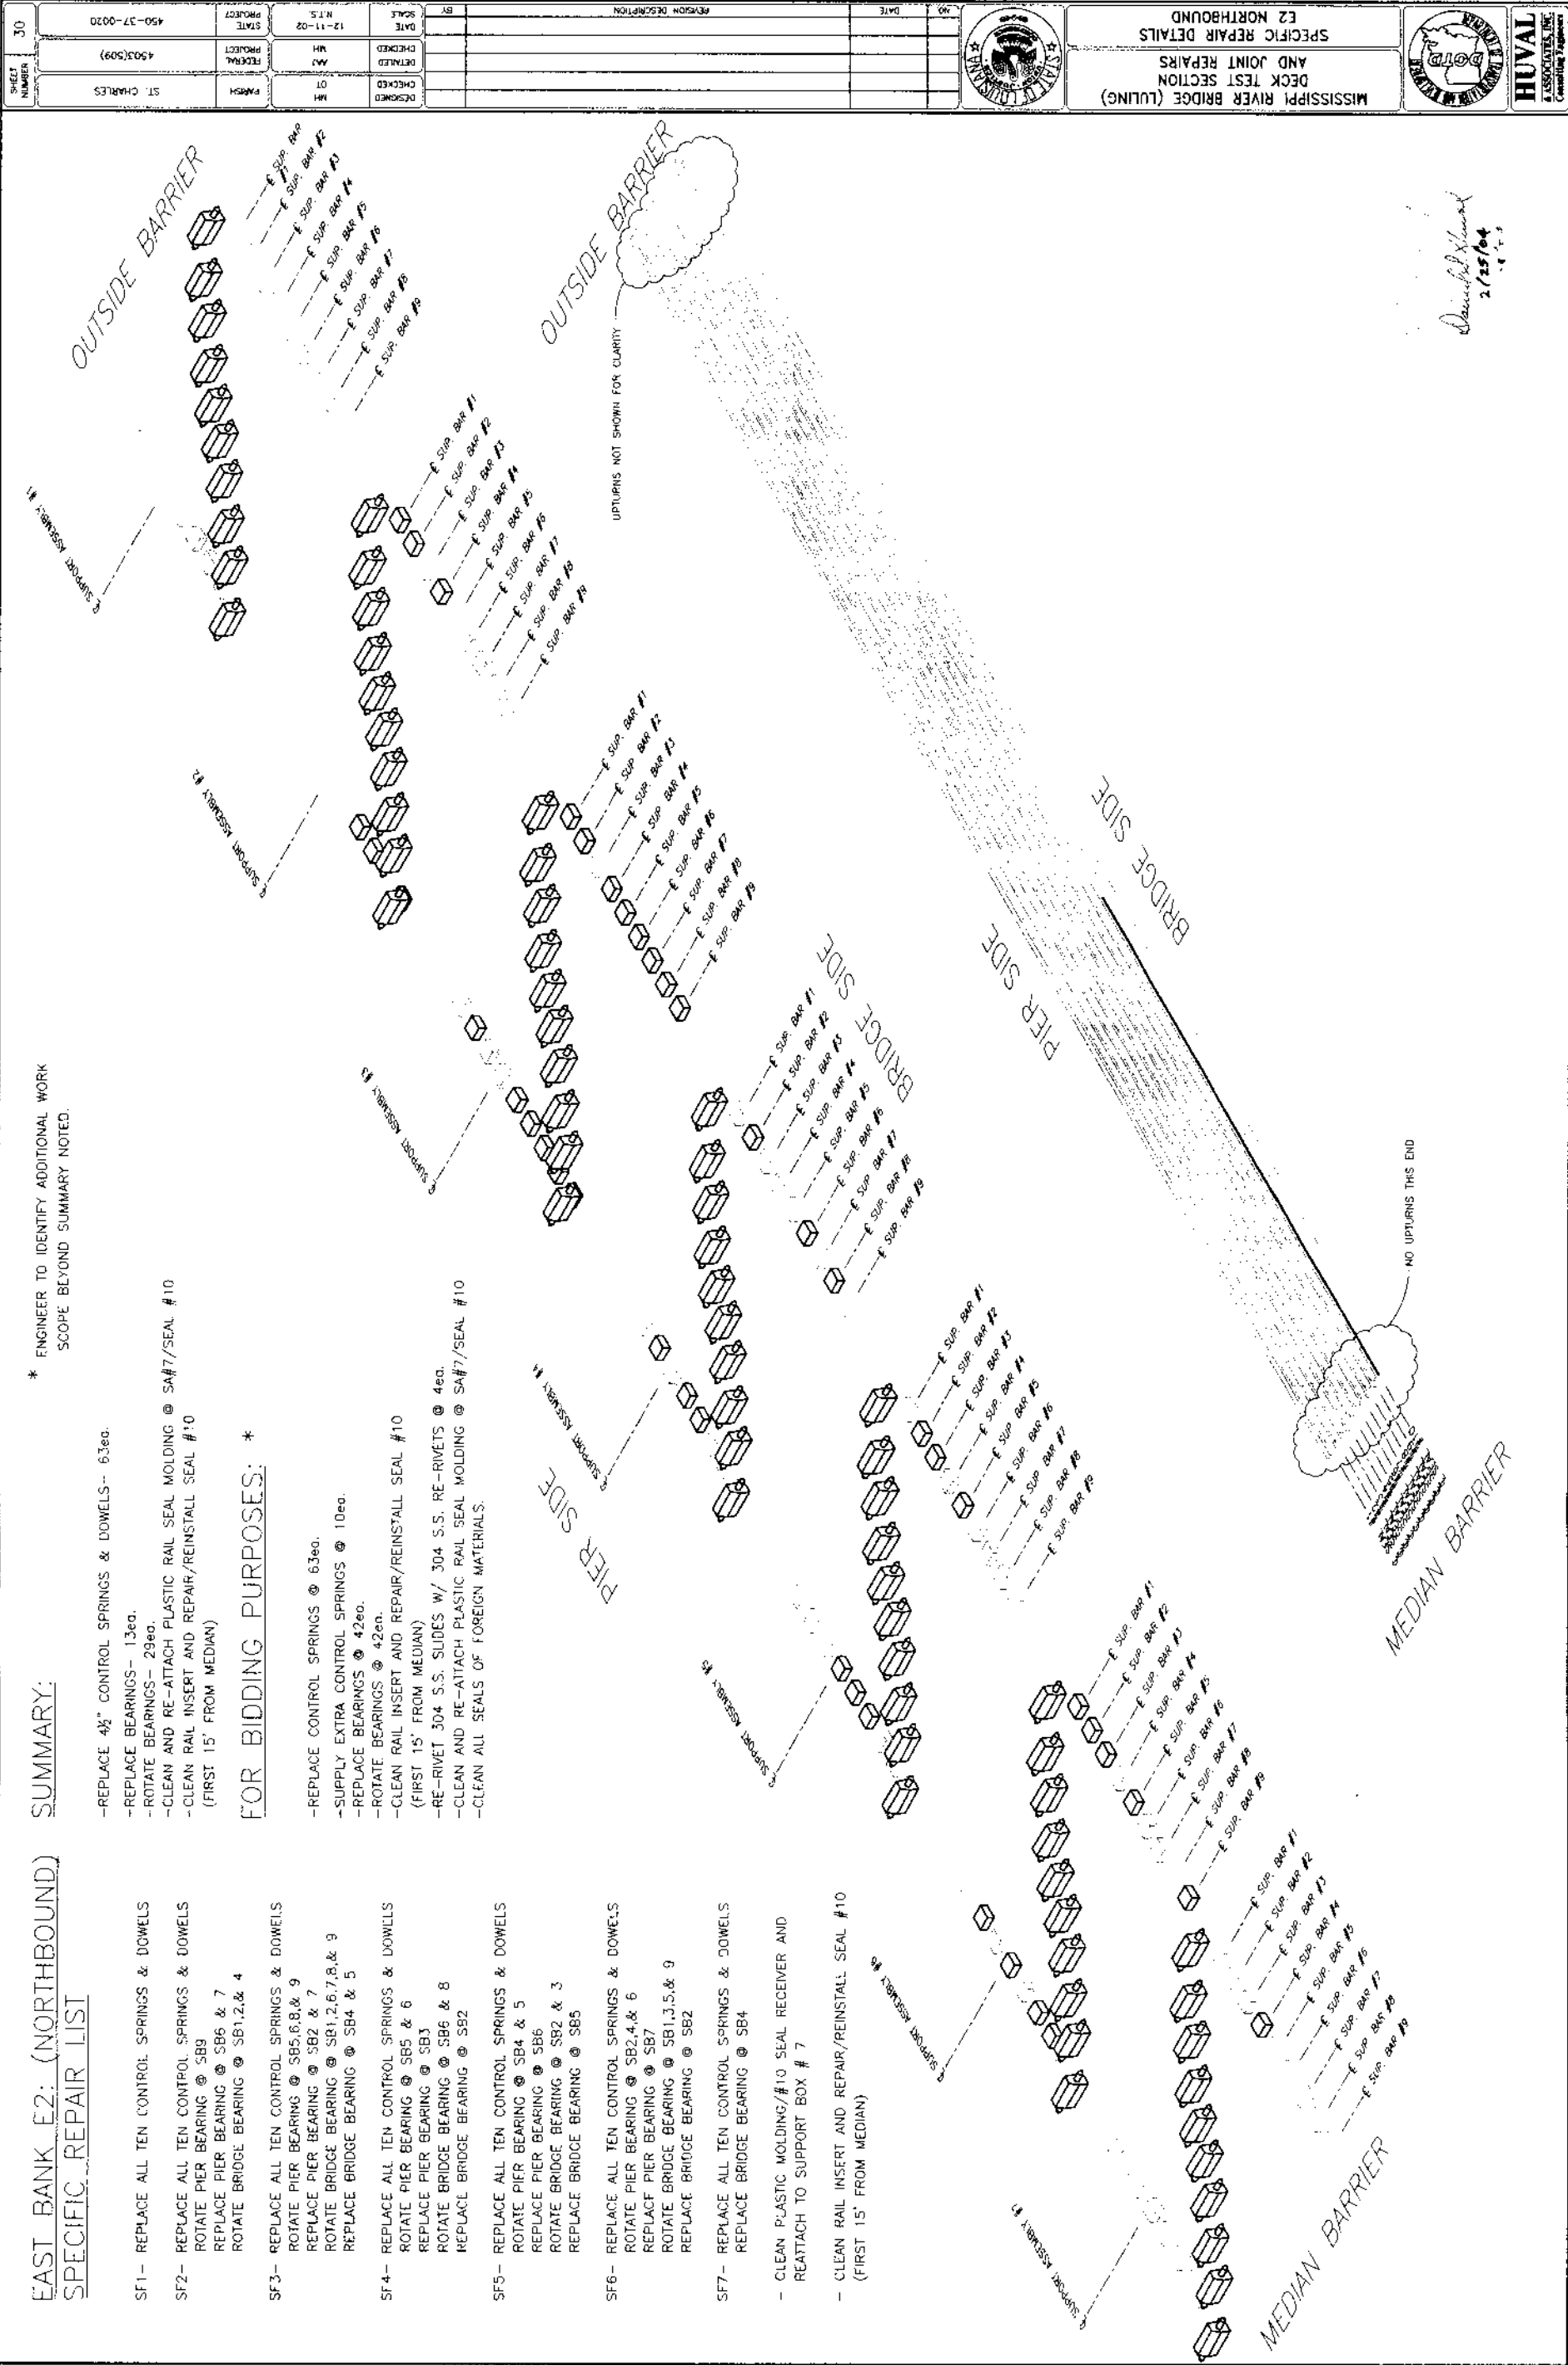


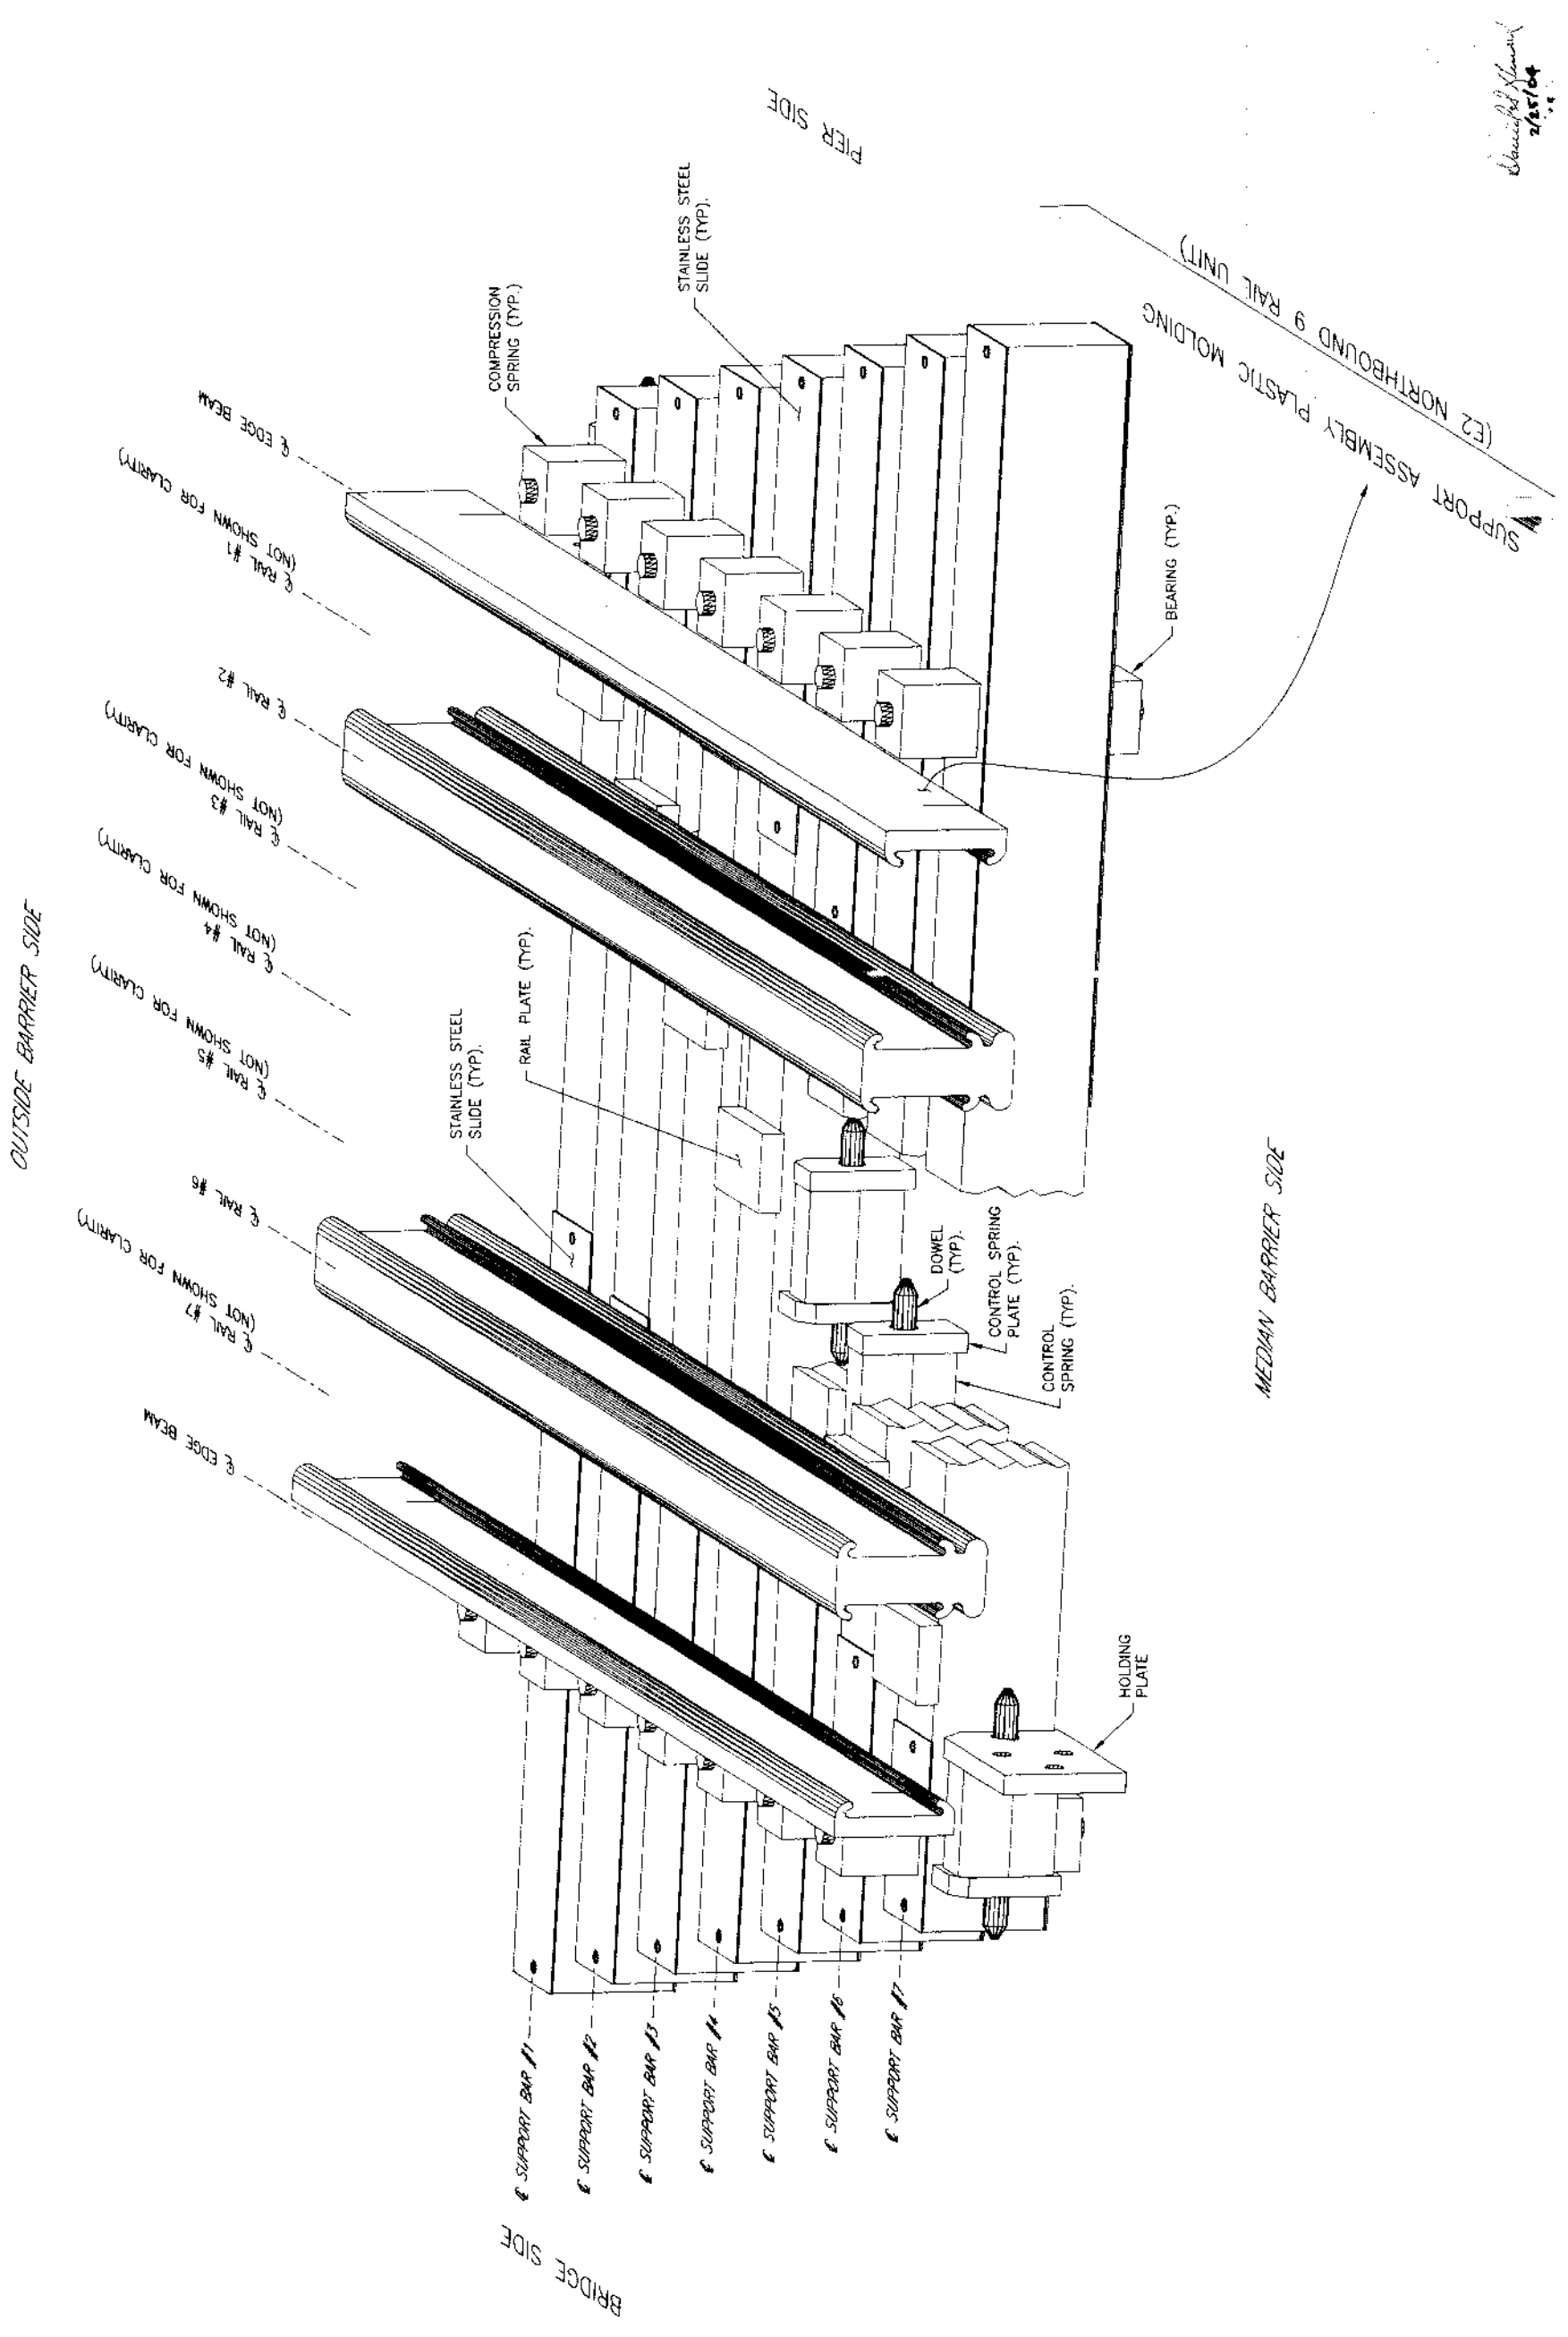


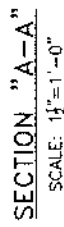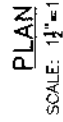

GENERAL NOTE: CONTRACTOR IS ADVISED THAT REMOVAL OF THE EXISTING MEDIAN BARRIER SLIDING PLATE ASSEMBLY IS REQUIRED FOR E1 WORK. THIS REMOVAL WILL EXPOSE BOTH SIDES OF THE FIXED MEDIAN BARRIER PROVIDING AN UNACCEPTABLE SNAG CONDITION FOR TRAFFIC IF SOUTHBOUND AND NORTHBOUND INSIDE LANES ARE NOT WORKED CONCURRENTLY. TRAFFIC WILL NOT BE ALLOWED IN EITHER INSIDE LANE WITH A MEDIAN SNAG EXPOSURE. TEMPORARY COVER PLATE PER THIS SHEET OR APPROVED EQUAL MUST BE PROVIDED. CONTRACTOR TO SUBMIT FOR APPROVAL PLANNED SEQUENCING AND MEDIAN BARRIER PROVISIONS PROPOSED.

SPECIFICATIONS OF NB/SB JOINT E1:

- 1.) WABO STR-1800 MODULAR EXPANSION JOINT, HS-20 DESIGN ~ 30% IMPACT LOADING
FIVE RAIL 2 1/2"x5" RAILS/1 1/2"x4" EDGE BEAMS/SIX STRIP-SEAL ELEMENTS
- 2.) CONCRETE - SFRC - SEE SPECIFICATION ITEM S-106 (NO DIRECT PAYMENT)
- 3.) REINFORCING STEEL - ASTM-A615 GRADE 60 (NO DIRECT PAYMENT)
- 4.) EPOXY UNDERLAYMENT - TYPE "B" - SEE SPECIFICATION ITEM S-105 MODIFIED FOR MANUAL/HAND APPLICATION (NO DIRECT PAYMENT)
- 5.) WELDING: ANSI/AASHTO/AWS D1.5-95
- 6.) STRUCTURAL STEEL (NO DIRECT PAYMENT):
 - a.) PLATES AND SHIMS - ASTM-A709 GRADE 50W
 - b.) WEATHERING STEEL-UNPAINTED STEEL
 - c.) JOINT E1 - WABO - ASTM-A705 GRADE 50W WEATHERING STEEL
- 7.) PAINT ON JOINT E1 - THREE COAT WATERBORNE PAINT SYSTEM PER DOTD SECTION 811.
APPROACH SIDE: PAINT ALL EXPOSED STEEL SURFACES NOT IN CONTACT WITH CONCRETE.
BRIDGE SIDE: PAINT ALL EXPOSED STEEL SURFACES EXCEPT SUPPORT ASSEMBLY BOX 1/2" PLATE TOP & FILLER 1/2" PLATE TOP. THESE AREAS ARE TO BE DESCRIBED ON SHOP DRAWINGS.

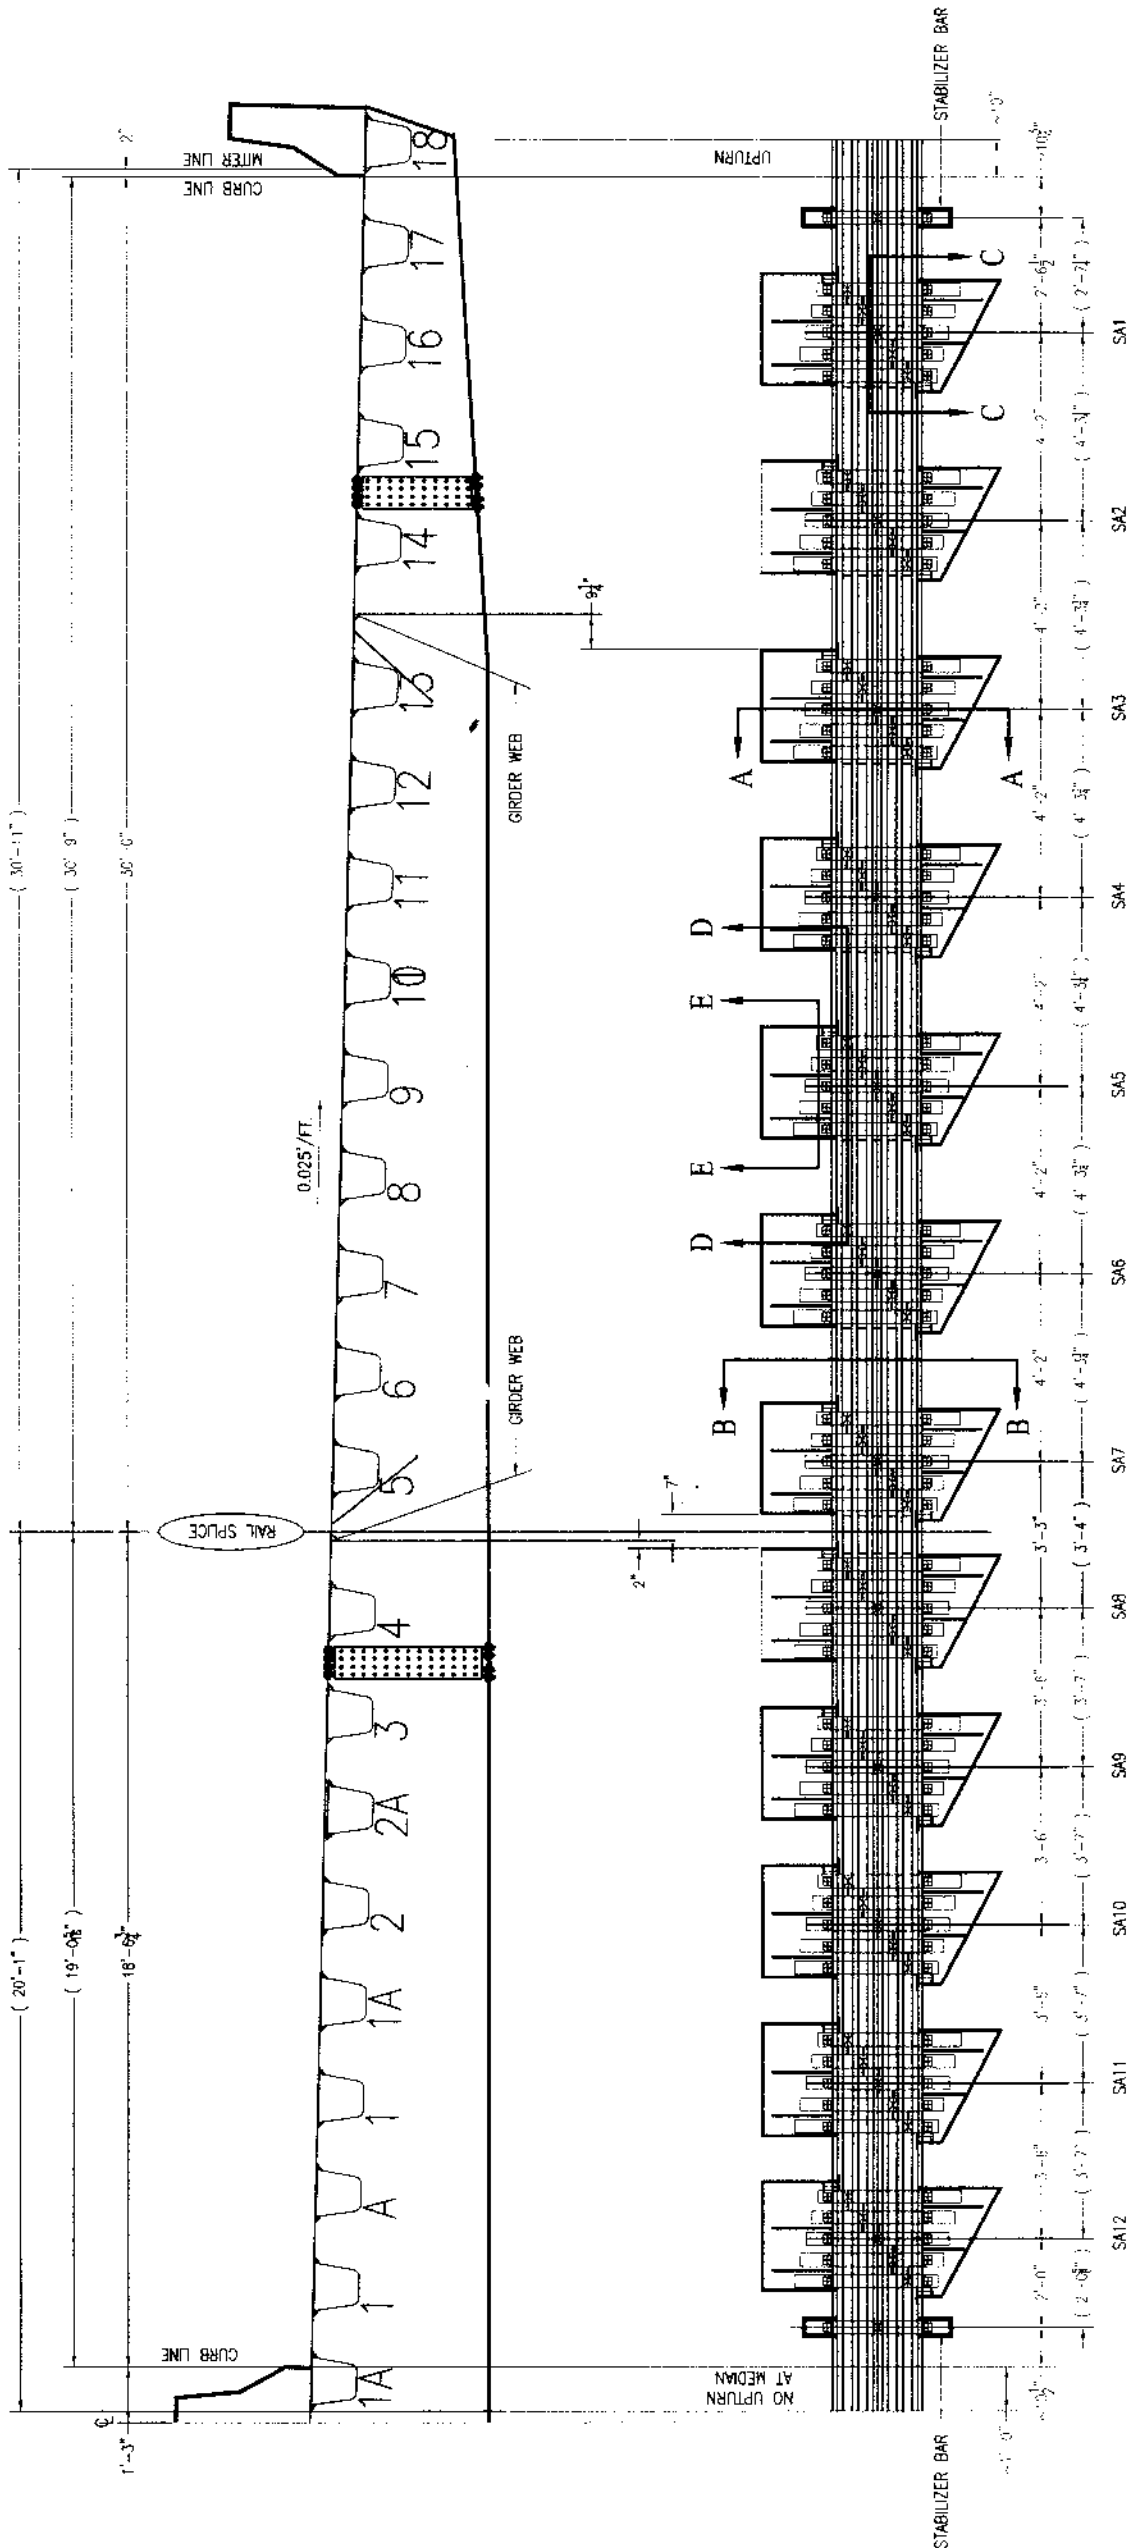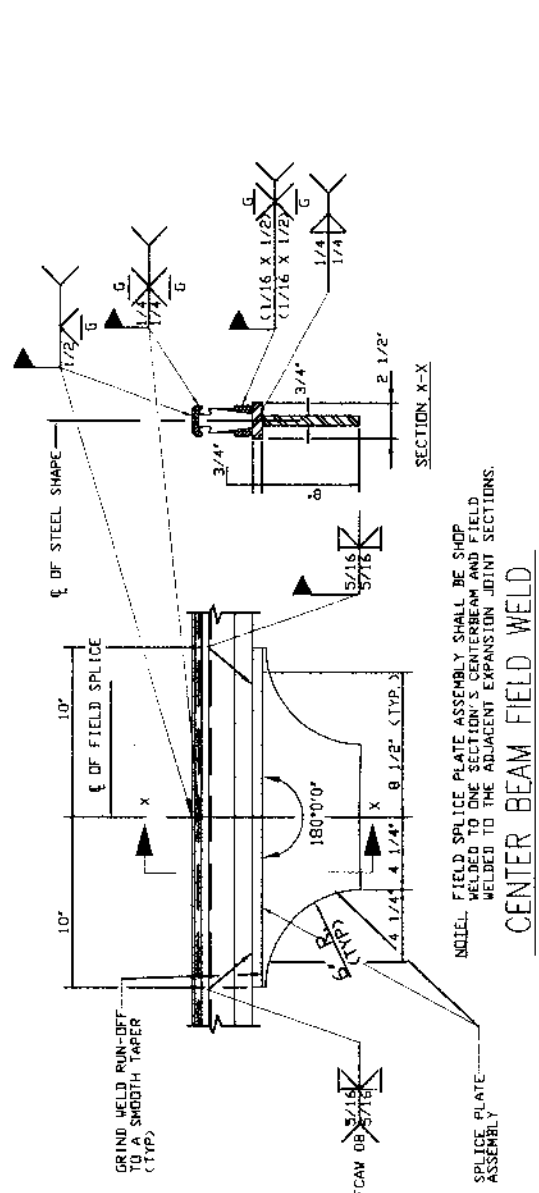

NORTHBOUND ROADWAY
CROSS SECTION & PLAN VIEW
OF NEW E1 JOINT
SCALE: 1/4"=1'-0"

- NOTES:
- 1.) SA2 & SA8 HAVE NO BACK PLATE.
 - 2.) LAYOUT DIMENSIONS/SPACING ARE NORMAL TO DECK & PRELIMINARY. FINAL DIMENSIONS WILL BE DETERMINED DURING SHOP DRAWING PREPARATION.
 - 3.) DIMENSIONS WILL BE DETERMINED DURING SHOP DRAWING PREPARATION.
 - 4.) MITER LINE-TO-CURB 2" DIMENSION (OUTSIDE BARRIER) CONTROLS LAYOUT SETTING.
 - 5.) SUPPORT ASSEMBLY (BOXES) SIDES MUST CLEAR GIRDER WEBS MINIMUM 3".
 - 6.) DIMENSIONS IN () DENOTE FABRICATION DIMENSIONS NORMAL TO DECK SLOPE

David H. Hume
2/15/14

NO.	DATE	REVISION DESCRIPTION
1	02/25/2014	1.000000-034611dim.mwg 033.02252014 10:43:13 AM
2	02/25/2014	1.000000-034611dim.mwg 033.02252014 10:43:13 AM

MAJOR WORK ACTIVITIES

BRIDGE SIDE


- ① SAWCUT WITHIN $\frac{1}{2}$ " OF DECK PLATE AND REMOVE EXISTING PMAC 4'-0" FROM E1 EDGE BEAM.
- ② CUT/BEVEL EXISTING $\frac{1}{16}$ " DECK PLATE, SPLICE PLATE, AND 9" RIBS $\frac{1}{8}$ " FROM BRIDGE DIAPHRAGM SURFACE.
- ③ UNBOLT OR CUT RIB BOLT FROM $\frac{1}{2}$ "x8" SUPPORT PLATE - DO NOT DAMAGE PLATE!
- ④ UNBOLT OR CUT E1 SUPPORT BAR FRAME BOLT FROM $\frac{1}{2}$ "x8" SUPPORT PLATE - DO NOT DAMAGE PLATE!
- ⑤ CUT EXISTING RAILS & EDGE BEAMS.
- ⑥ REMOVE E1 & SUPPORT BARS/BOXES, DECK END DAM, EDGE BEAMS, RAILS, SEALS, DECK, RIBS, AND $\frac{1}{8}$ "x4" SPACER PLATES AND SHIMS.
- ⑦ MECHANICALLY CLEAN TOP OF FLANGE PLATE & DRESS CUT DECK PLATE AND RIB EDGES..

APPROACH SIDE


- ⑧ SAWCUT CONCRETE AT EDGE ANGLE & REMOVE APPROACH CONCRETE AS REQUIRED.
- ⑨ EXPOSE AND CLEAN EXISTING REBAR TO REMAIN.
- ⑩ UNBOLT OR CUT E1 SUPPORT BAR FRAME BOLT FROM 1"x5" SUPPORT PLATE.
- ⑪ COMPLETE REMOVAL OF EXISTING ROAD SURFACE AND APPROACH CONCRETE A MINIMUM OF 1'-0" DEEP AND 3'-0" BACK FROM E1 EDGE BEAM.
- ⑫ REMOVE E1 SUPPORT BARS/BOXES, EDGE BEAMS, BULKHEADS, RAILS, SEALS, SHIMS, AND 1"x4" SPACER PLATE.
- ⑬ MECHANICALLY CLEAN TOP OF 1"x5" FLANGE PLATE.
- ⑭ CUT REBAR AS REQUIRED AND DRESS OUT REBAR TO REMAIN.

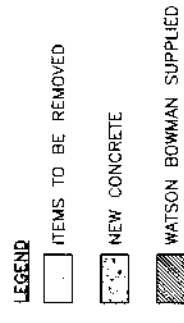

2/15/04
David H. Howard

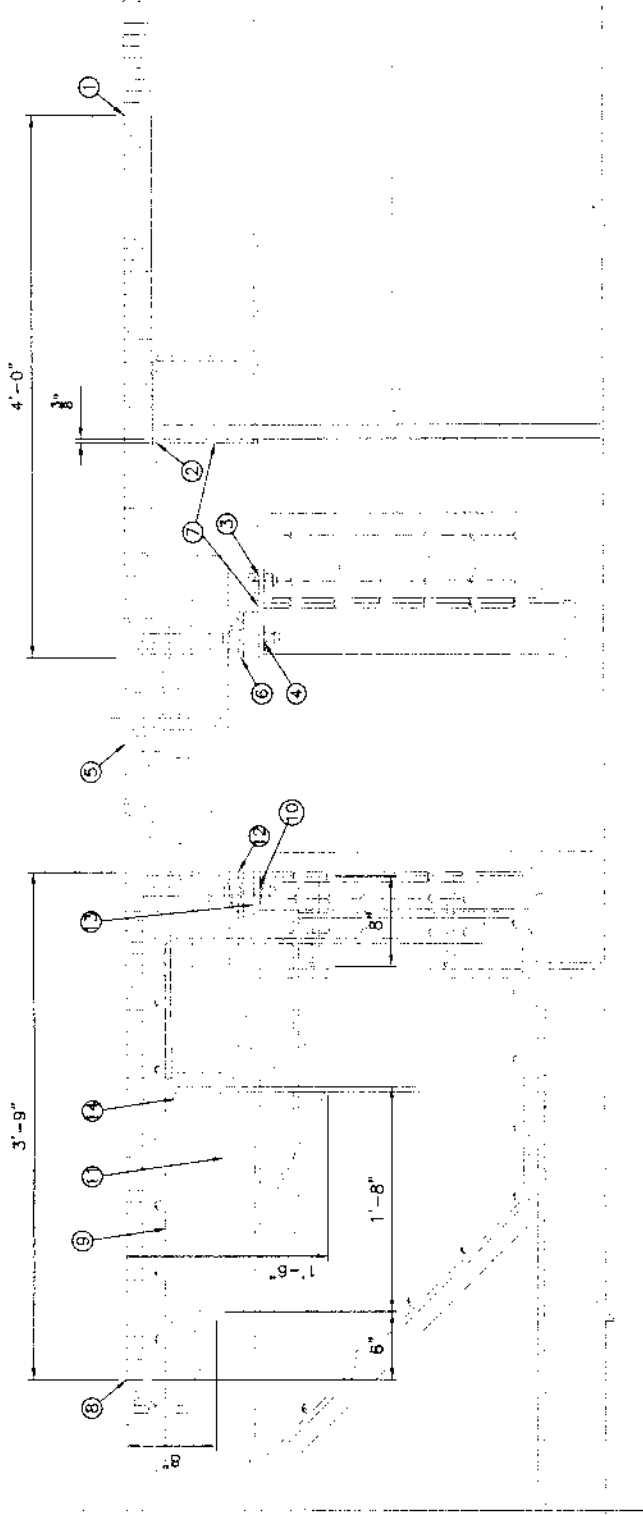

SECTION "A-A"
SHOWING ITEMS TO BE REMOVED

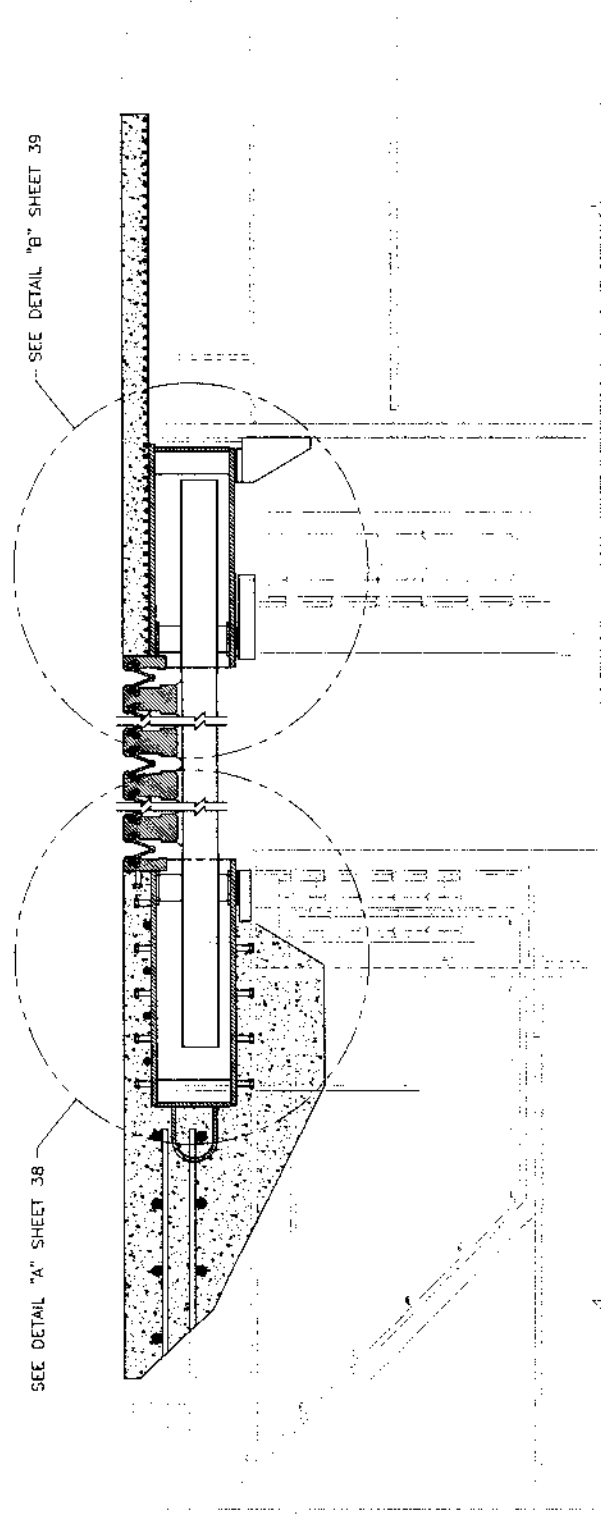

SECTION "A-A"
SHOWING ITEMS TO BE ADDED

36		MISSISSIPPI RIVER BRIDGE (LULING)		SUPPORT ASSEMBLY SECTION "A-A"			HUVAL ASSOCIATES, INC. Consulting Engineers	
		DECK TEST SECTION AND JOINT REPAIRS						
		NO.	DATE	REVISION DESCRIPTION	BY			DATE
		DESIGNED	DT	MH	PARISH	ST. CHARLES		
		CHECKED						
		DETAILED	BHM		FORMAL			
		CHECKED						
		DATE			STATE	1-1/2"-1-0"		
		BY			PROJECT			
							*50-37-0020	

MAJOR WORK ACTIVITIES

BRIDGE SIDE


- ① SAWCUT WITHIN $\frac{1}{2}$ " OF DECK PLATE AND REMOVE EXISTING PMAC 4'-0" FROM E1 EDGE BEAM.
- ② CUT/BEVEL EXISTING $\frac{7}{8}$ " DECK PLATE, SPLICE PLATE, AND 9" RIBS $\frac{1}{8}$ " FROM BRIDGE DIAPHRAGM SURFACE.
- ③ UNBOLT OR CUT RIB BOLT FROM $\frac{1}{2}$ "x8" SUPPORT PLATE – DO NOT DAMAGE PLATE!
- ④ UNBOLT OR CUT E1 SUPPORT BAR FRAME BOLT FROM $\frac{1}{2}$ "x8" SUPPORT PLATE – DO NOT DAMAGE PLATE!
- ⑤ CUT EXISTING RAILS & EDGE BEAMS.
- ⑥ REMOVE E1 & SUPPORT BARS/BOXES; DECK END DAM, EDGE BEAMS, RAILS, SEALS, DECK, RIBS, AND $1\frac{1}{8}$ "x4" SPACER PLATES AND SHIMS.
- ⑦ MECHANICALLY CLEAN TOP OF FLANGE PLATE & DRESS CUT DECK PLATE AND RIB EDGES..

APPROACH SIDE

- ③ SAWCUT CONCRETE AT EDGE ANGLE & REMOVE APPROACH CONCRETE AS REQUIRED.
- ③ EXPOSE AND CLEAN EXISTING REBAR TO REMAIN.
- ⑩ UNBOLT OR CUT E1 SUPPORT BAR FRAME BOLT FROM 3"x5" SUPPORT PLATE.
- ⑪ COMPLETE REMOVAL OF EXISTING ROAD SURFACE AND APPROACH CONCRETE A MINIMUM OF 1'-0" DEEP AND 3'-0" BACK FROM E1 EDGE BEAM.
- ⑫ REMOVE E1 SUPPORT BARS/BOXES, EDGE BEAMS, BULKHEADS, RAILS, SEALS, SHIMS, AND 1"x4" SPACER PLATE.
- ⑬ MECHANICALLY CLEAN TOP OF 3"x5" FLANGE PLATE.
- ⑭ CUT REBAR AS REQUIRED AND DRESS OUT REBAR TO REMAIN.


LEGEND

-  ITEMS TO BE REMOVED
 NEW CONCRETE
 WATSON BOWMAN SUPPLIED

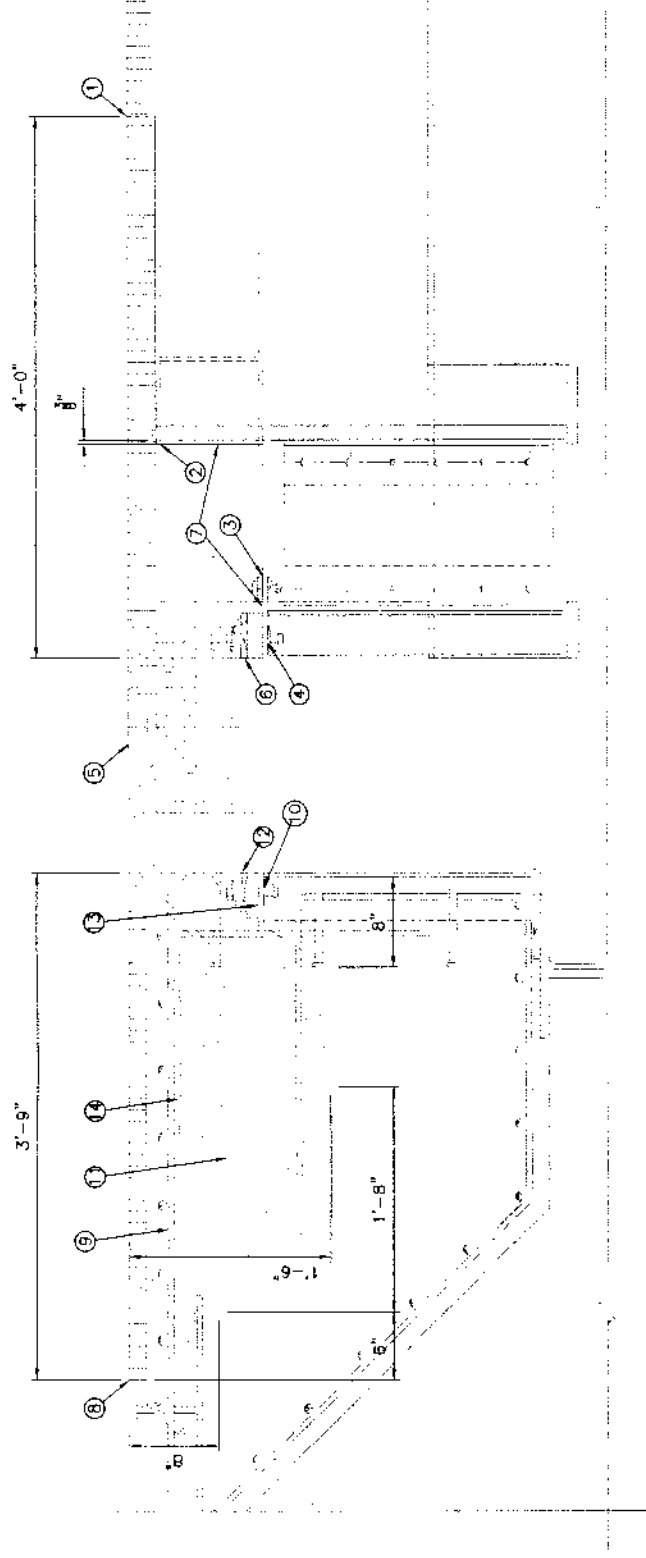


SECTION "B-B"

SHOWING ITEMS TO BE REMOVED

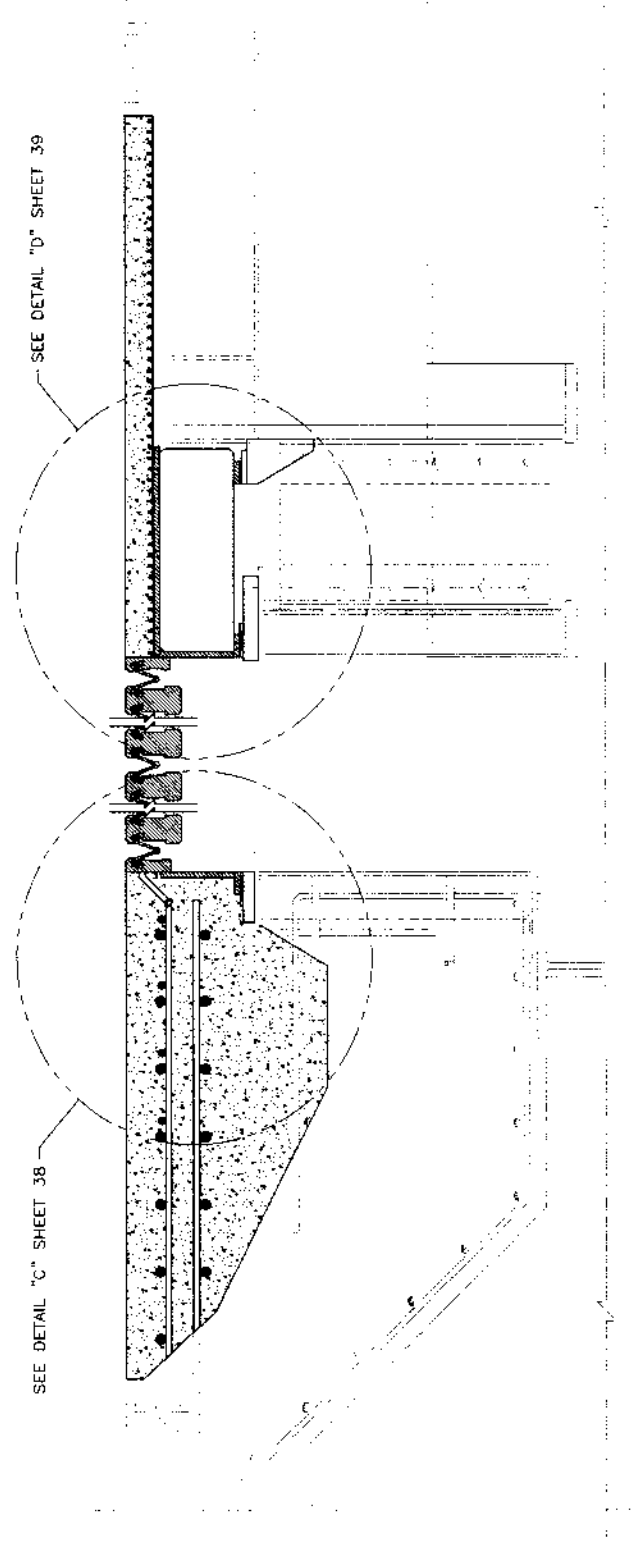


SECTION "B-B"

SHOWING ITEMS TO BE ADDED

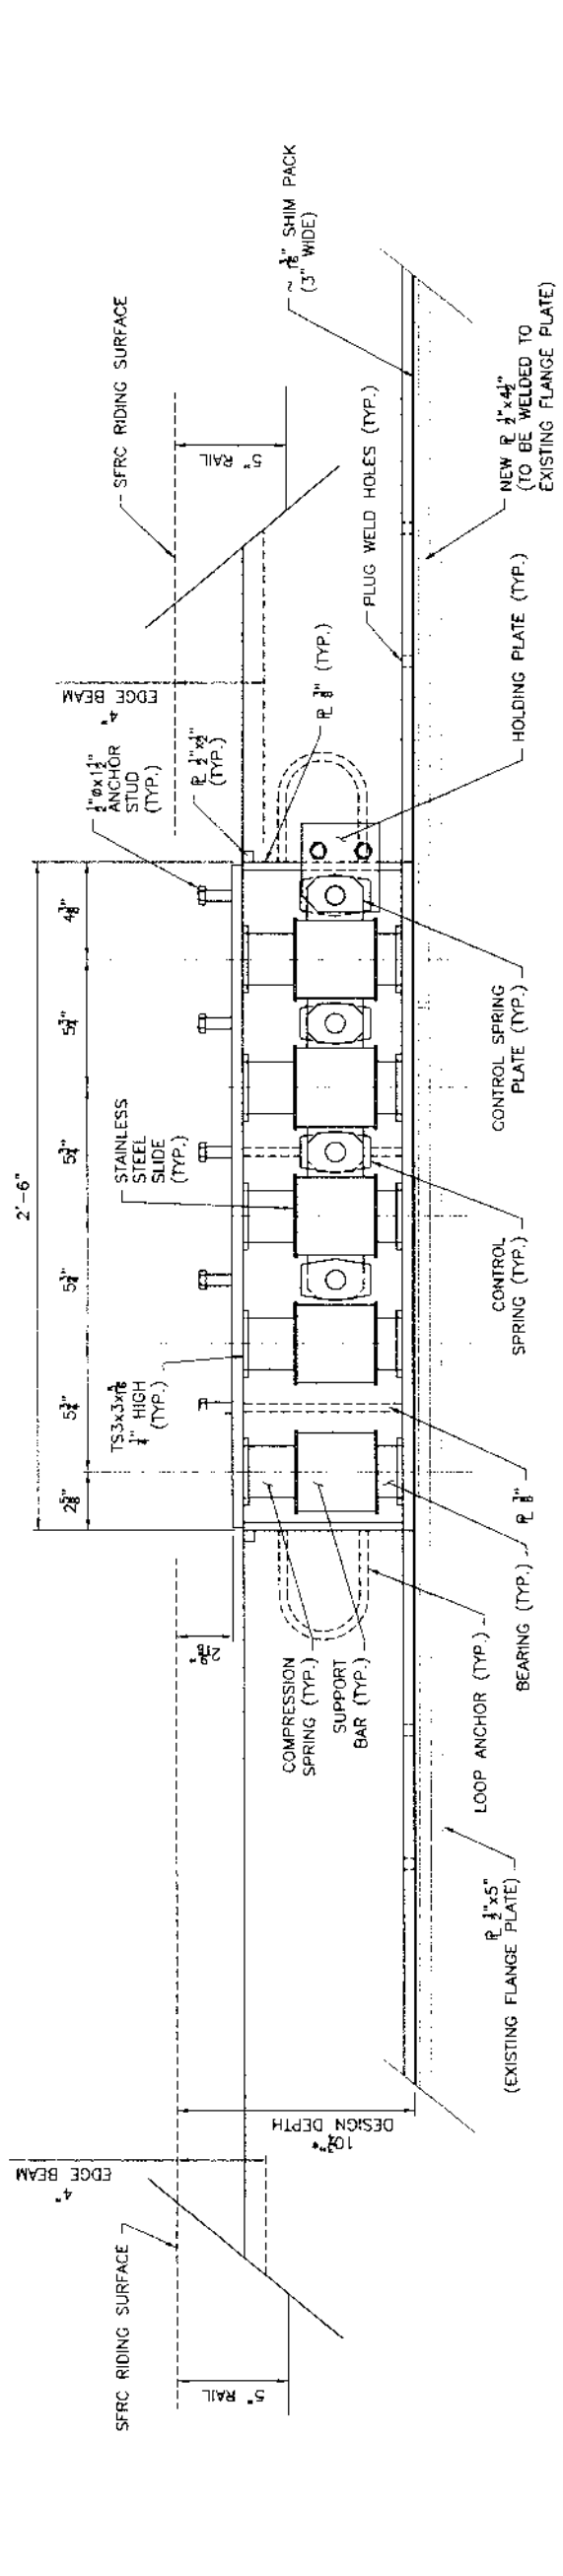

SPECIAL NOTE:
EXISTING 1" SPACER PLATE REDUCES IN THICKNESS IN OUTSIDE PORTION OF APPROACH SIDE ROADWAY BEAM. OUTSIDE 5/8" + OF NEW 1/2"x4/8" SPACER PLATE FOR BOTH SIDES OF BRIDGE APPROACH SIDE (SOUTHBOUND & NORTHBOUND) TO BE LIKEWISE REDUCED IN THICKNESS AS REQUIRED TO ALLOW USE OF 3" WIDE SHIM PACK. CONTRACTOR TO FIELD SURVEY & PROVIDE SIZES AND MAXIMUM CONTINUOUS LENGTHS OF NEW SPACER PLATES AS POSSIBLE.

SECTION "C-C"
FACING APPROACH SIDE

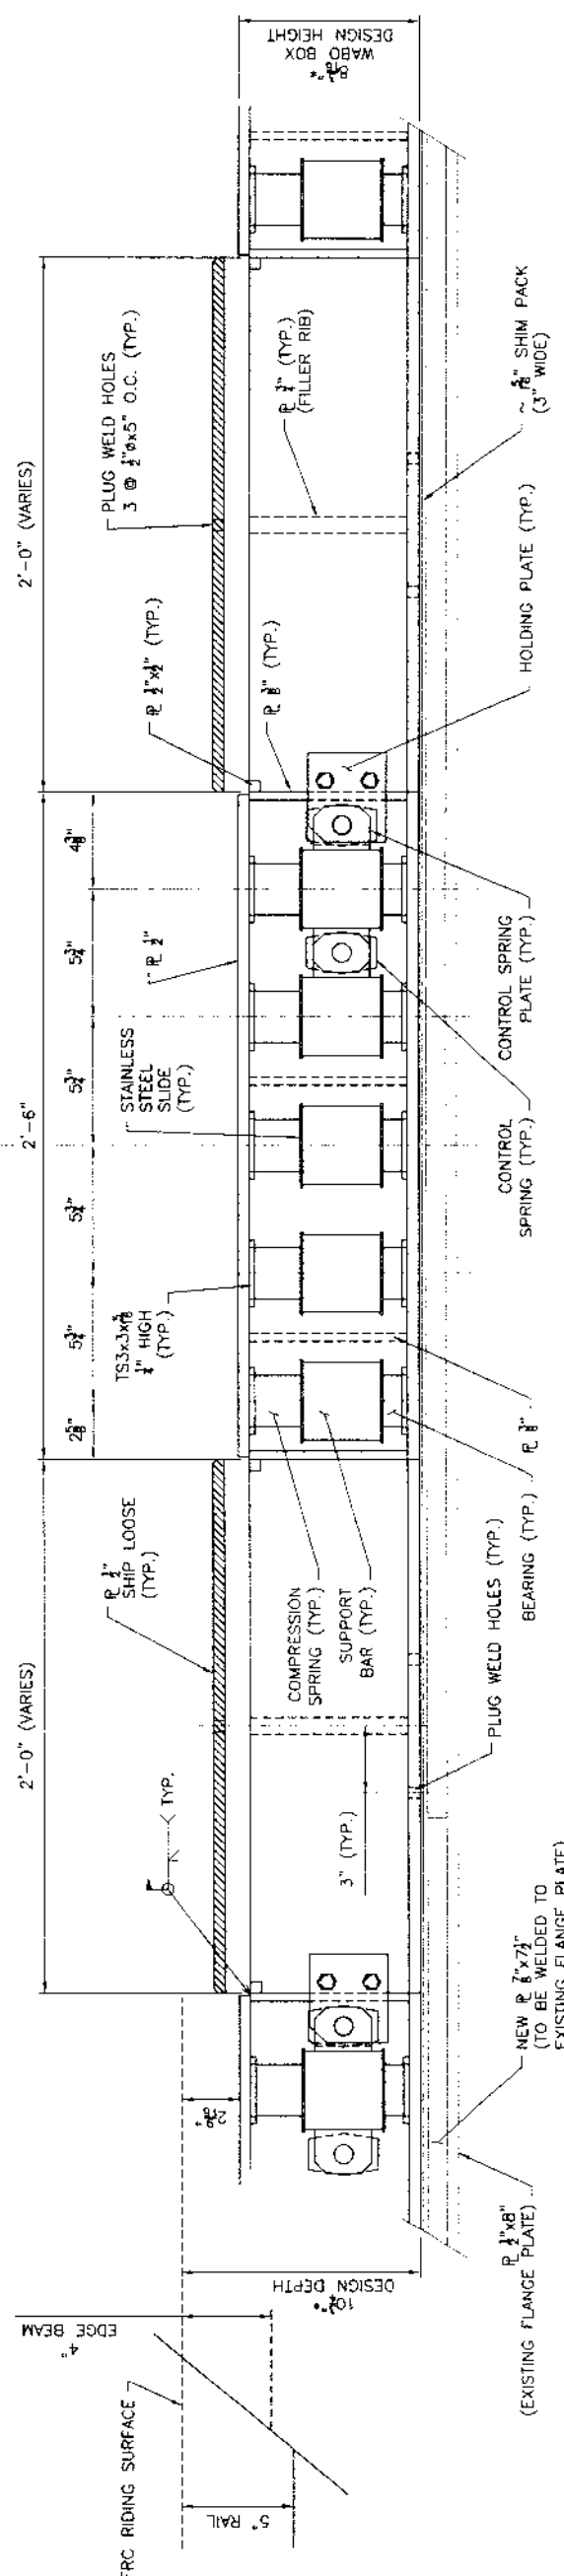

SPECIAL NOTE:
CONTRACTOR TO FIELD SURVEY ACTUAL THICKNESS OF EXISTING SPACER PLATE AND ADJUST NEW SPACER PLATE THICKNESS AS REQUIRED TO MAINTAIN 3" WIDE (SEE SHEET 39) SHIM PACK USE. NEW SPACER PLATE LENGTHS TO BE MAXIMIZED AS MUCH AS PRACTICAL.

SECTION "D-D"
FACING BRIDGE SIDE

***GENERAL NOTE:**
EXPANSION JOINT SUPPORT ASSEMBLY DIMENSIONS SUBJECT TO FINAL DESIGN AND APPROVAL FROM WATSON BOWMAN.



David H. H. H.
2/25/04







NO.	DATE	REVISION DESCRIPTION	BY
		DESIGNED	CHECKED
		DETAILD	CHECKED
		DATE	SCALE
		01-26-04	6"=1'-0"
		STATE	PROJECT
		4502(509)	450-37-0020
		PARISH	ST. CHARLES
		38	SHEET NUMBER




David Pittman
2/25/04

LEGEND:

	ADDED TRANSVERSE #6's
	ADDED TRANSVERSE #3's
	WATSON BOWMAN SUPPLIED

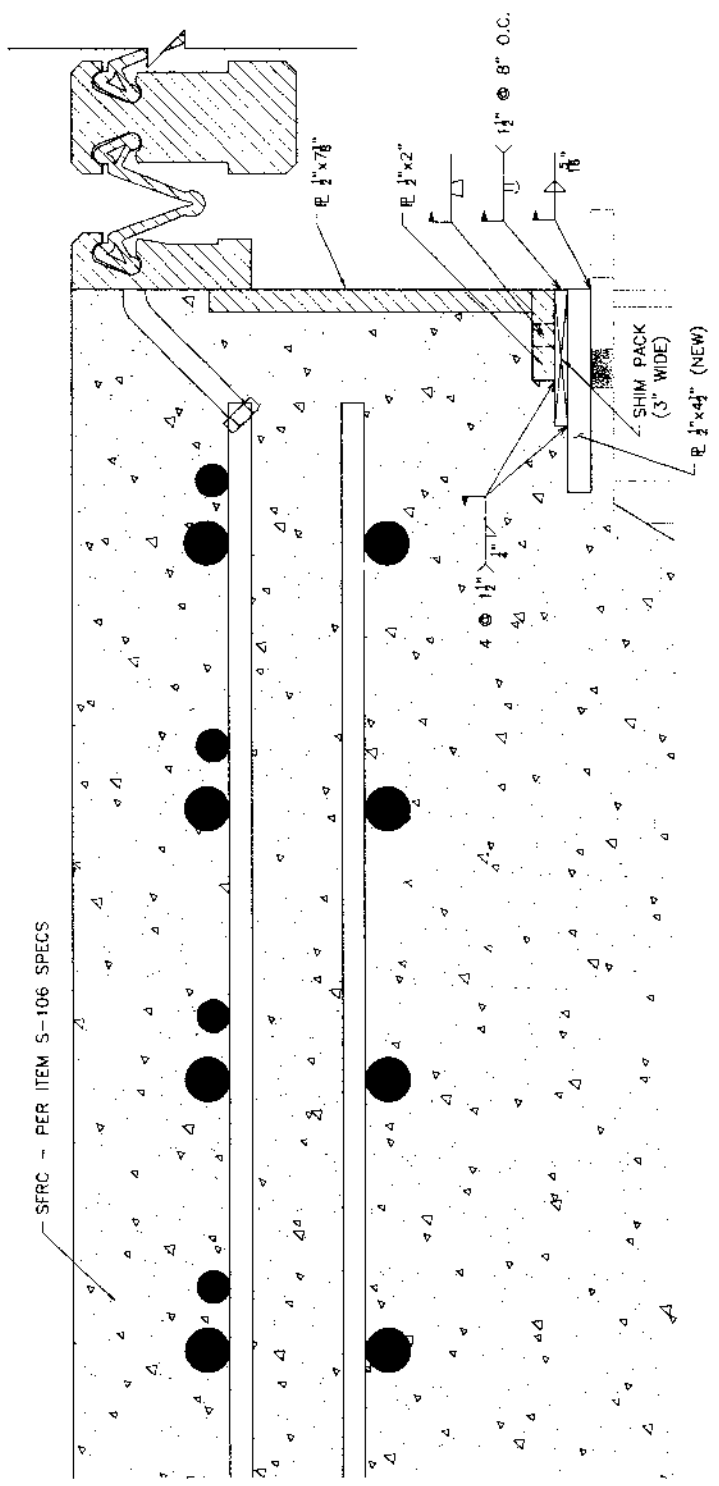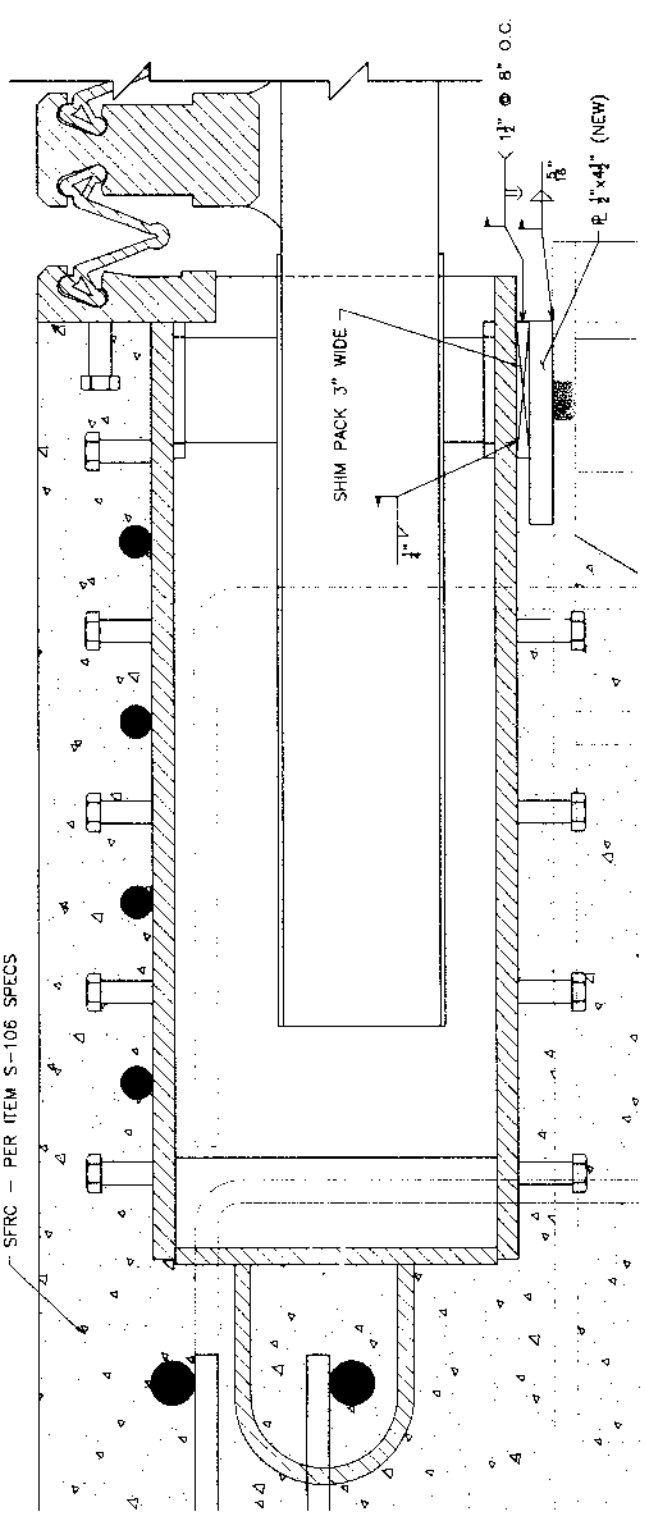

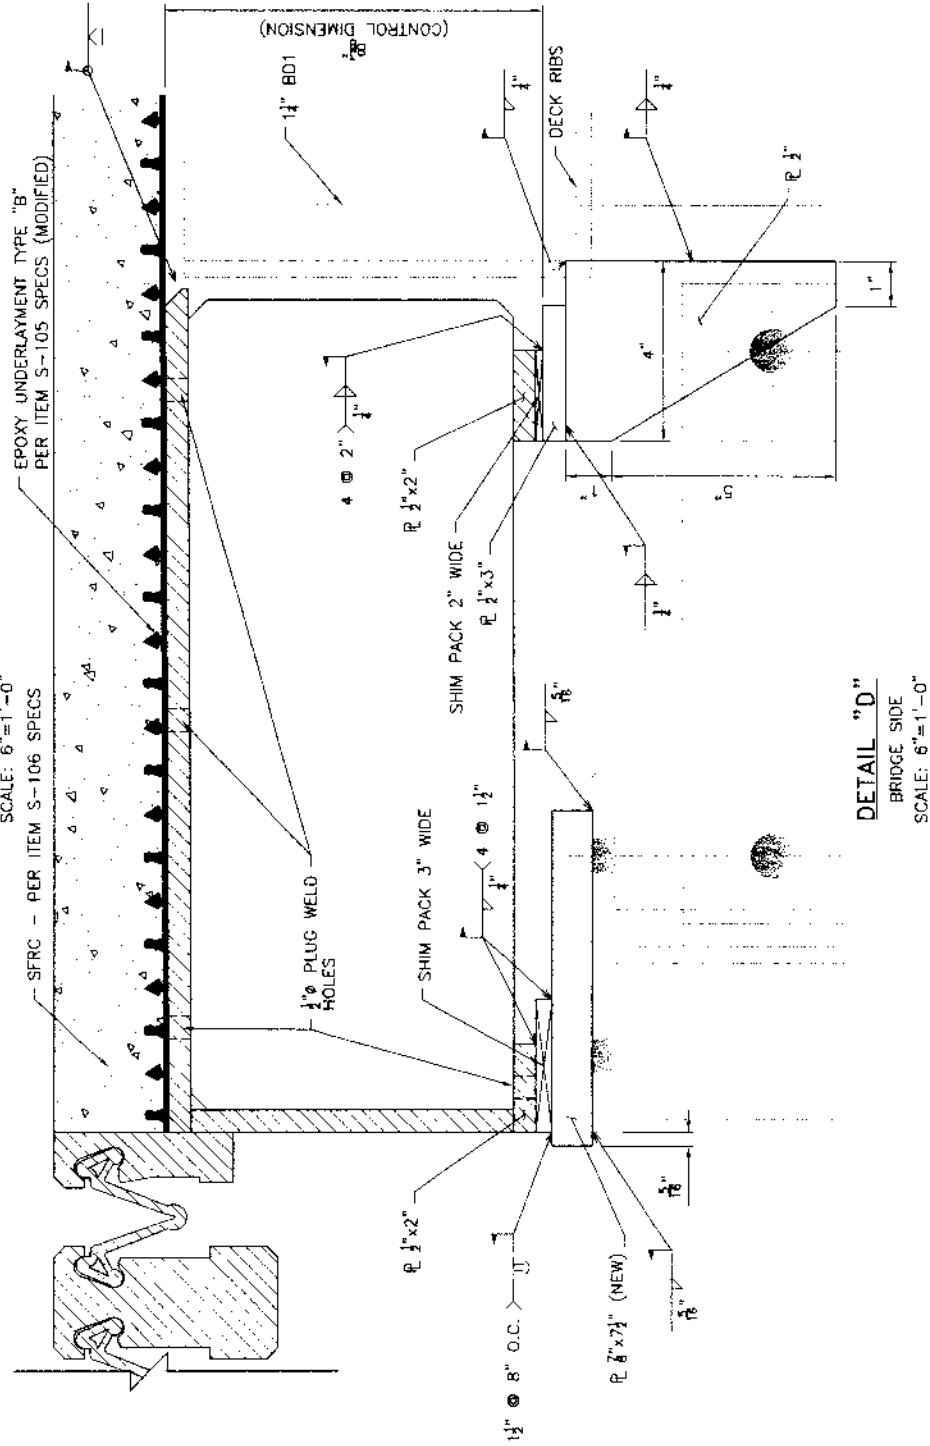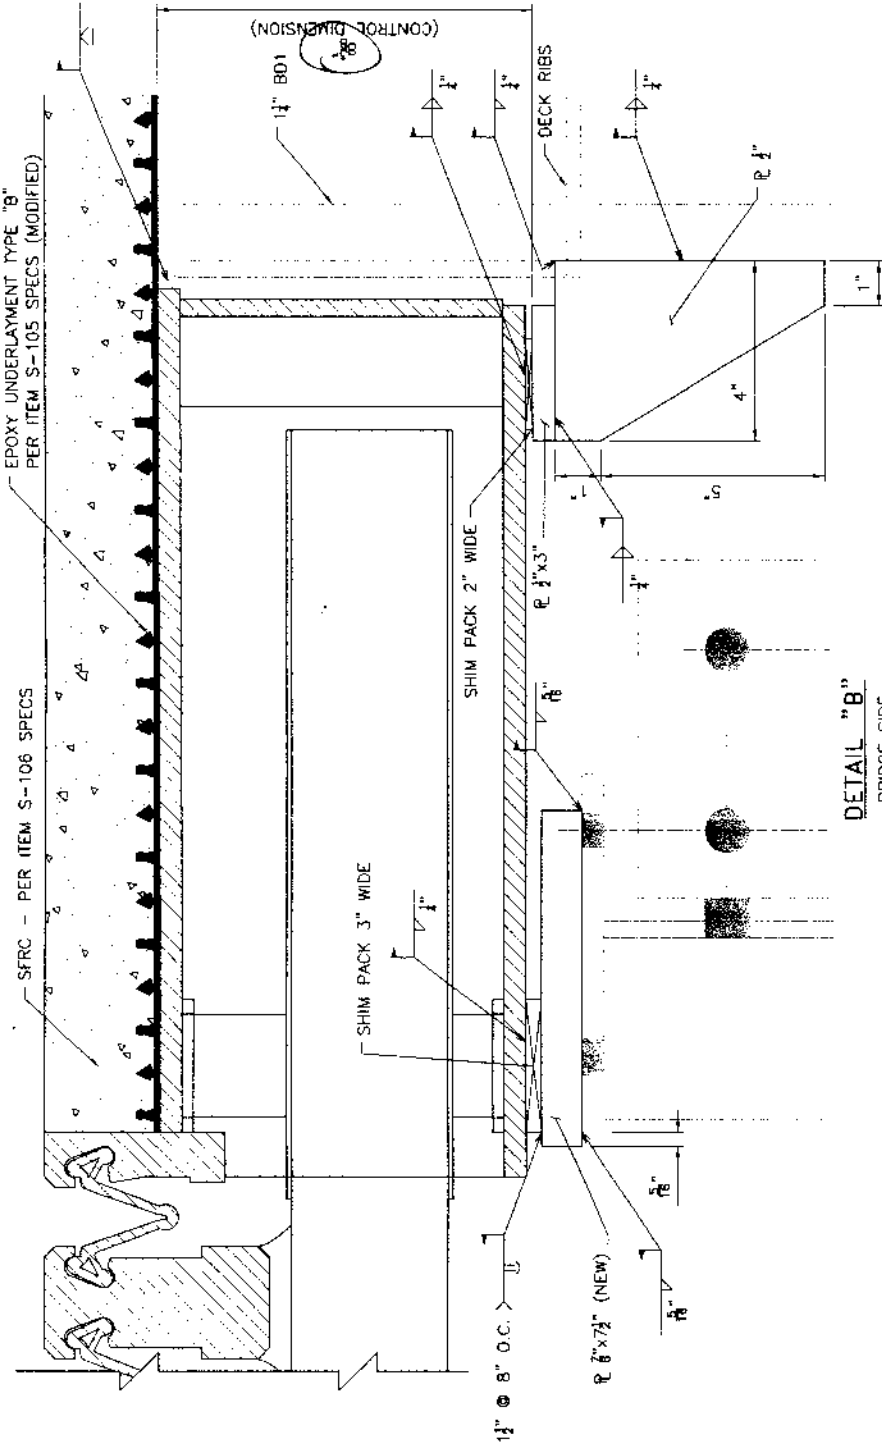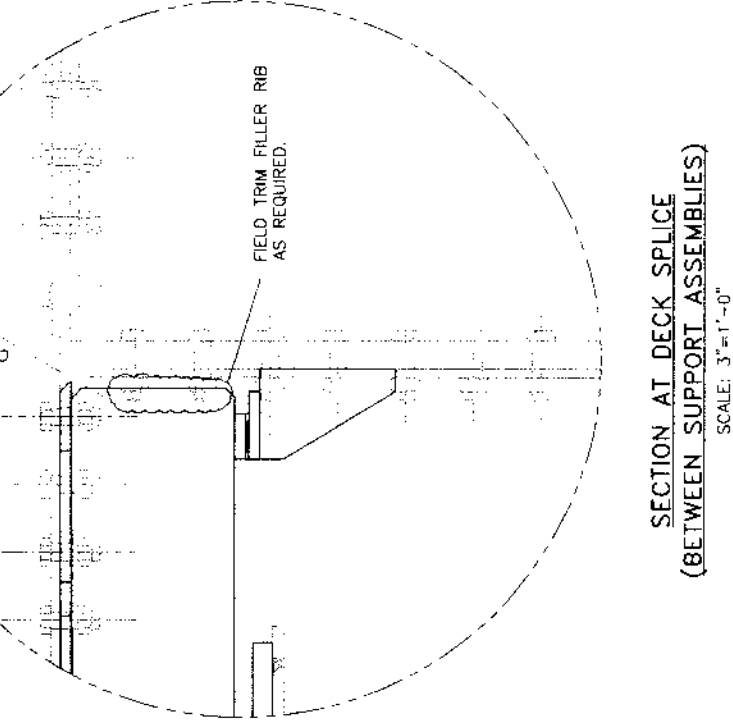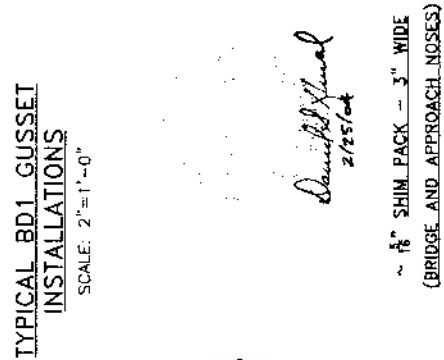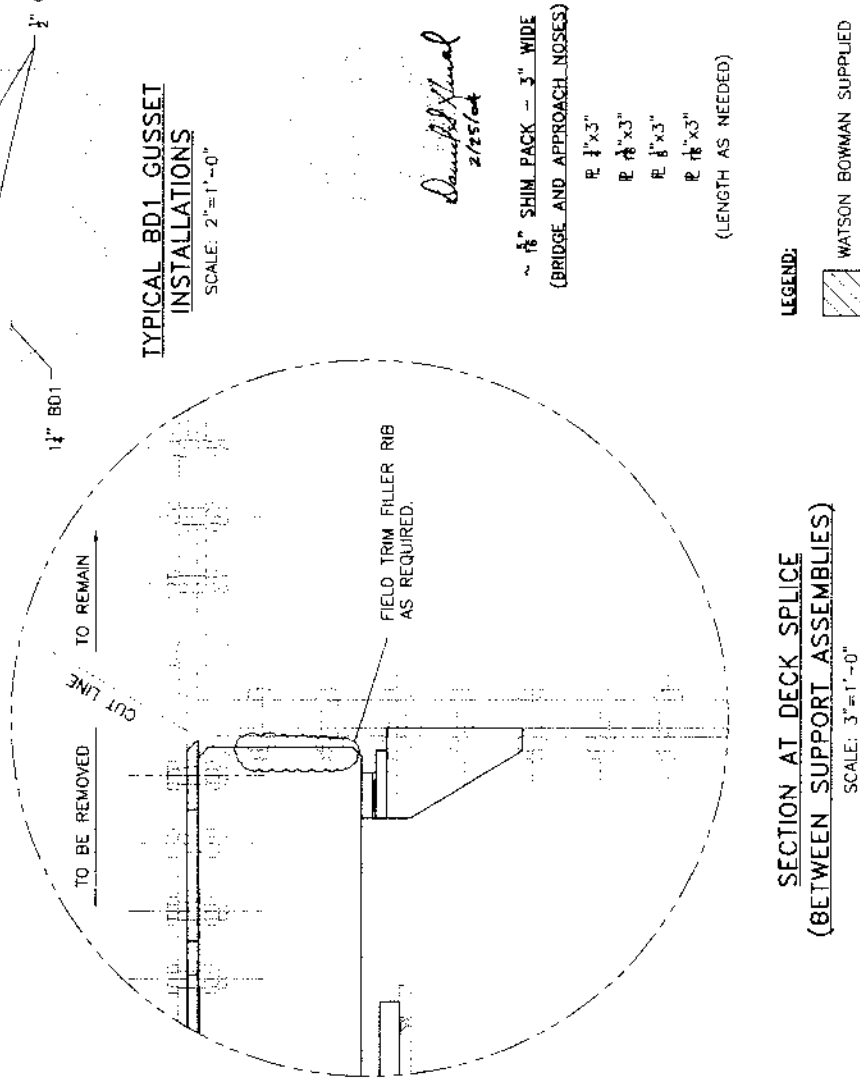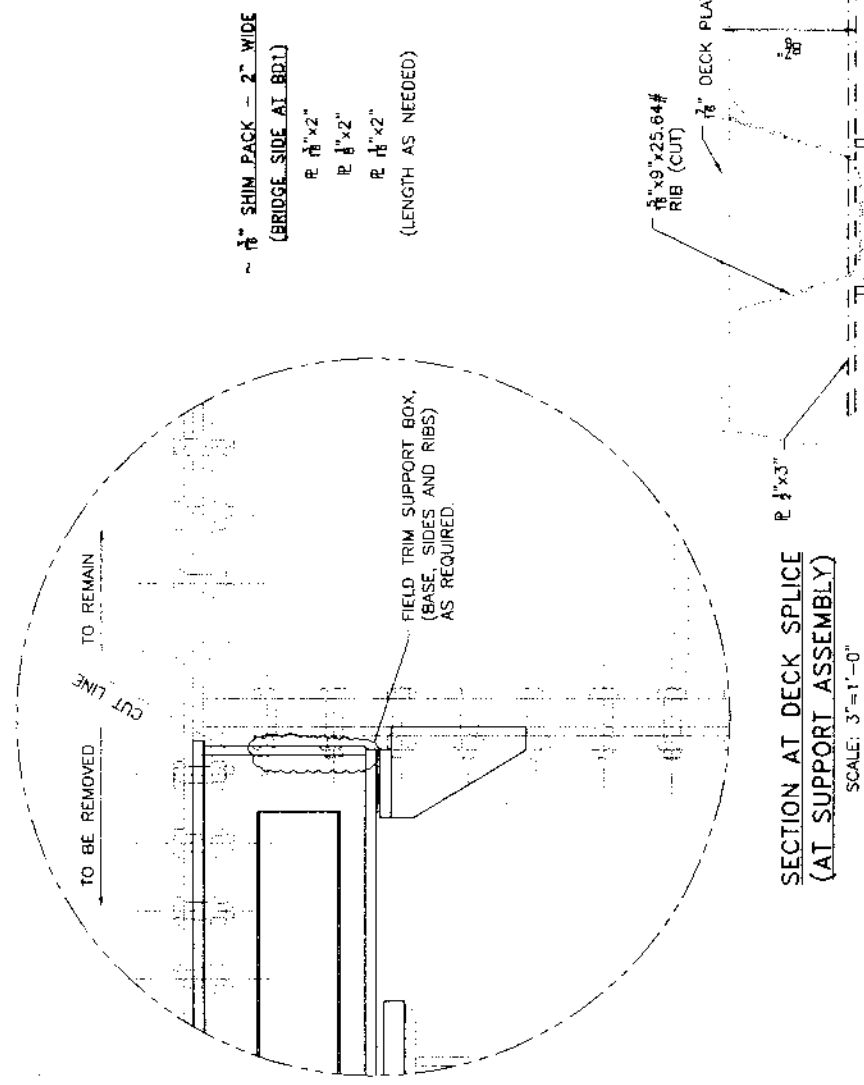

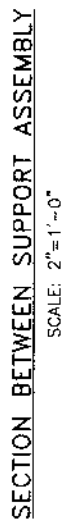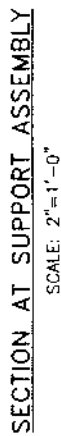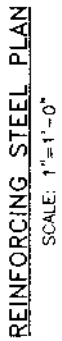

2/25/64
David B. Lewis

SOUTHBOUND BRIDGE (INSIDE LANE)*				
REINFORCING STEEL SCHEDULE				
BAR	NO.	UNIT LENGTH	TOTAL LENGTH	LOCATION
301	4	17'-3"⊙	69'-0"	SLAB
TOTAL NO. 3 BARS = 26.0 lbs.				
401	20	3'-0"	60'-0"	SLAB
TOTAL NO. 4 BARS = 41.0 lbs.				
601	7	18'-3"⊗	127'-9"	SLAB
602	10	1'-2"	11'-8"	SLAB
603	10	2'-0"	20'-0"	SLAB
604	10	2'-9"	27'-6"	SLAB
TOTAL NO. 6 BARS = 280.0 lbs.				

* REQUIRED TO BE CONSTRUCTED FIRST
⊙ INCLUDES LAP SPLICE OF 1'-0"
⊗ INCLUDES LAP SPLICE OF 2'-0"

NORTHBOUND BRIDGE (INSIDE LANE)*				
REINFORCING STEEL SCHEDULE				
BAR	NO.	UNIT LENGTH	TOTAL LENGTH	LOCATION
301	4	19'-6"⊙	77'-8"	SLAB
TOTAL NO. 3 BARS = 30.0 lbs.				
401	24	3'-0"	72'-0"	SLAB
TOTAL NO. 4 BARS = 49.0 lbs.				
601	7	20'-8"⊗	143'-6"	SLAB
602	12	1'-2"	14'-0"	SLAB
603	12	2'-0"	28'-0"	SLAB
604	12	2'-9"	33'-0"	SLAB
TOTAL NO. 6 BARS = 328.0 lbs.				

* CONTRACTOR PERMITTED TO CONSTRUCT INSIDE OR OUTSIDE FIRST.
REINFORCING STEEL SCHEDULE IS BASED ON INSIDE CONSTRUCTION FIRST.
⊙ INCLUDES LAP SPLICE OF 1'-0"
⊗ INCLUDES LAP SPLICE OF 2'-0"

SOUTHBOUND BRIDGE (OUTSIDE LANE)*				
REINFORCING STEEL SCHEDULE				
BAR	NO.	UNIT LENGTH	TOTAL LENGTH	LOCATION
301	4	21'-8"	86'-8"	SLAB
TOTAL NO. 3 BARS = 33.0 lbs.				
401	20	3'-0"	60'-0"	SLAB
TOTAL NO. 4 BARS = 41.0 lbs.				
601	7	21'-8"	151'-8"	SLAB
602	10	1'-2"	11'-8"	SLAB
603	10	2'-0"	20'-0"	SLAB
604	10	2'-9"	27'-6"	SLAB
TOTAL NO. 6 BARS = 316.0 lbs.				


* REQUIRED TO BE CONSTRUCTED SECOND

NORTHBOUND BRIDGE (OUTSIDE LANE)*				
REINFORCING STEEL SCHEDULE				
BAR	NO.	UNIT LENGTH	TOTAL LENGTH	LOCATION
301	4	29'-9"	119'-0"	SLAB
TOTAL NO. 3 BARS = 45.0 lbs.				
401	28	3'-0"	84'-0"	SLAB
TOTAL NO. 4 BARS = 57.0 lbs.				
601	7	29'-9"	208'-3"	SLAB
602	14	1'-2"	16'-4"	SLAB
603	14	2'-0"	28'-0"	SLAB
604	14	2'-9"	36'-6"	SLAB
TOTAL NO. 6 BARS = 437.0 lbs.				


* CONTRACTOR PERMITTED TO CONSTRUCT INSIDE OR OUTSIDE FIRST.
REINFORCING STEEL SCHEDULE IS BASED ON INSIDE CONSTRUCTION FIRST.

David H. Huval
2/25/04

TOTAL REINFORCING STEEL FOR
NORTHBOUND AND SOUTHBOUND = 1,883.0 lbs.
(NO DIRECT PAYMENT)
TOTAL SFRC SOUTHBOUND = 6.35 CU. YDS.
TOTAL SFRC NORTHBOUND = 8.02 CU. YDS.
TOTAL = 14.37 CU. YDS.
(NO DIRECT PAYMENT)

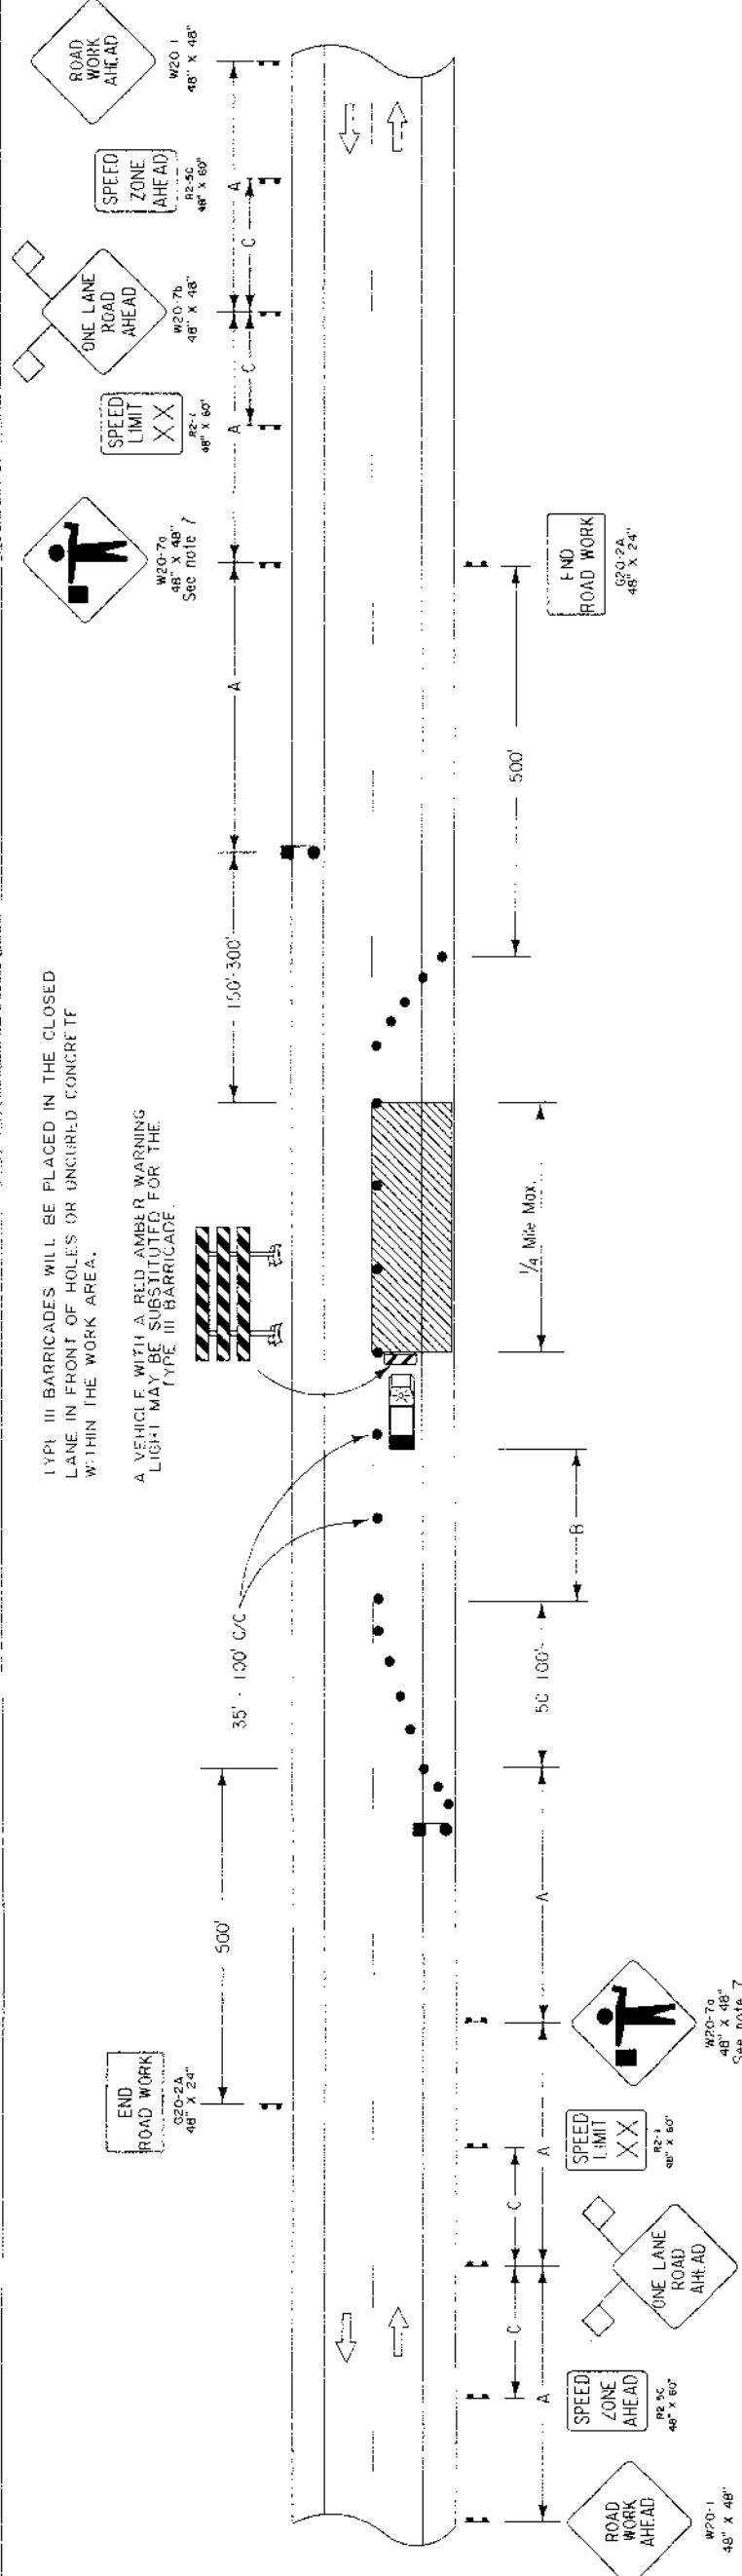


FLAGGERS
WHEN UTILIZED, A FLAGGER SHALL USE A MINIMUM 6' STOP/SLOW PADDOLE AND WEAR ANSI CLASS 3 LIME GREEN COLORED VEST. IN ALL FLAGGING OPERATIONS, THE FLAGGER MUST BE VISIBLE FROM FLAGGER'S SIGN. FLAGGERS SHALL BE PROPERLY TRAINED.

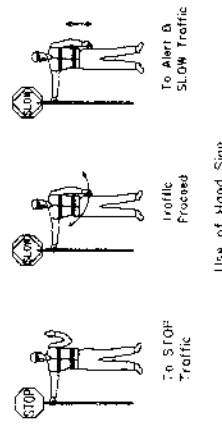


SPEED LIMIT (See note 5)	Approximate Sign Spacing		
	"A"	"B"	"C"
35 mph	500'	100'-200'	N/A
45 mph	1000'	100'-200'	500'
55 mph	1500'	200'-300'	800'

SIGN SPACING TO BE ADJUSTED
FOR HORIZONTAL & VERTICAL CURVES.

- # NOTES
1. CONDITIONS REPRESENTED ARE FOR WORK WHICH REQUIRES CLOSING TRAFFIC LANES DURING DAYLIGHT HOURS ONLY. PORTABLE SIGNS MAY BE USED FOR WORK LASTING LESS THAN 3 DAYS.
 2. WHEN A WORK AREA HAS BEEN ESTABLISHED ON ONE SIDE OF THE ROADWAY ONLY, THERE SHALL BE NO CONTRACTOR PARKING ON THE OPPOSITE SHOULDER WITHIN 500 FEET OF THE WORK AREA.
 3. CHANNELIZING DEVICES MAY BE PLACED UP TO 2' BEYOND CENTER LINE ONLY AT SPECIFIC LOCATIONS WHERE ACTUAL WORK ACTIVITY IS TAKING PLACE. TRAVELED LANE IS NEVER TO BE REDUCED BELOW A 10' WIDTH. CHANNELIZING DEVICES SHALL BE RETURNED TO THE CENTERLINE WHEN THE WORK ACTIVITY HAS PASSED.
 4. SPACING OF CHANNELIZING DEVICES IN THE TAPER SHOULD BE NO MORE THAN 20'. A MINIMUM OF 5 CHANNELIZING DEVICES ARE TO BE USED IN THE TAPER.
 5. SPEED LIMIT REFERS TO THE LEGALLY ESTABLISHED SPEED LIMIT BEFORE CONSTRUCTION.
 6. TO PREVENT VEHICLES FROM ENTERING THE WORK AREA AGAINST THE FLOW OF TRAFFIC, AN ADDITIONAL FLAGGER SHALL BE STATIONED AT EACH INTERSECTION, MAJOR DRIVEWAY, RAILROAD CROSSING OR CROSSING WITHIN THE WORK AREA.
 7. VISUAL OR RADIO CONTACT SHALL BE REQUIRED BETWEEN THE FLAGGERS AT ALL TIMES.

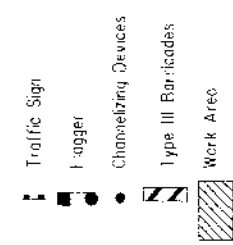
F. G. NO.

Charles W. Adams
6/7/03

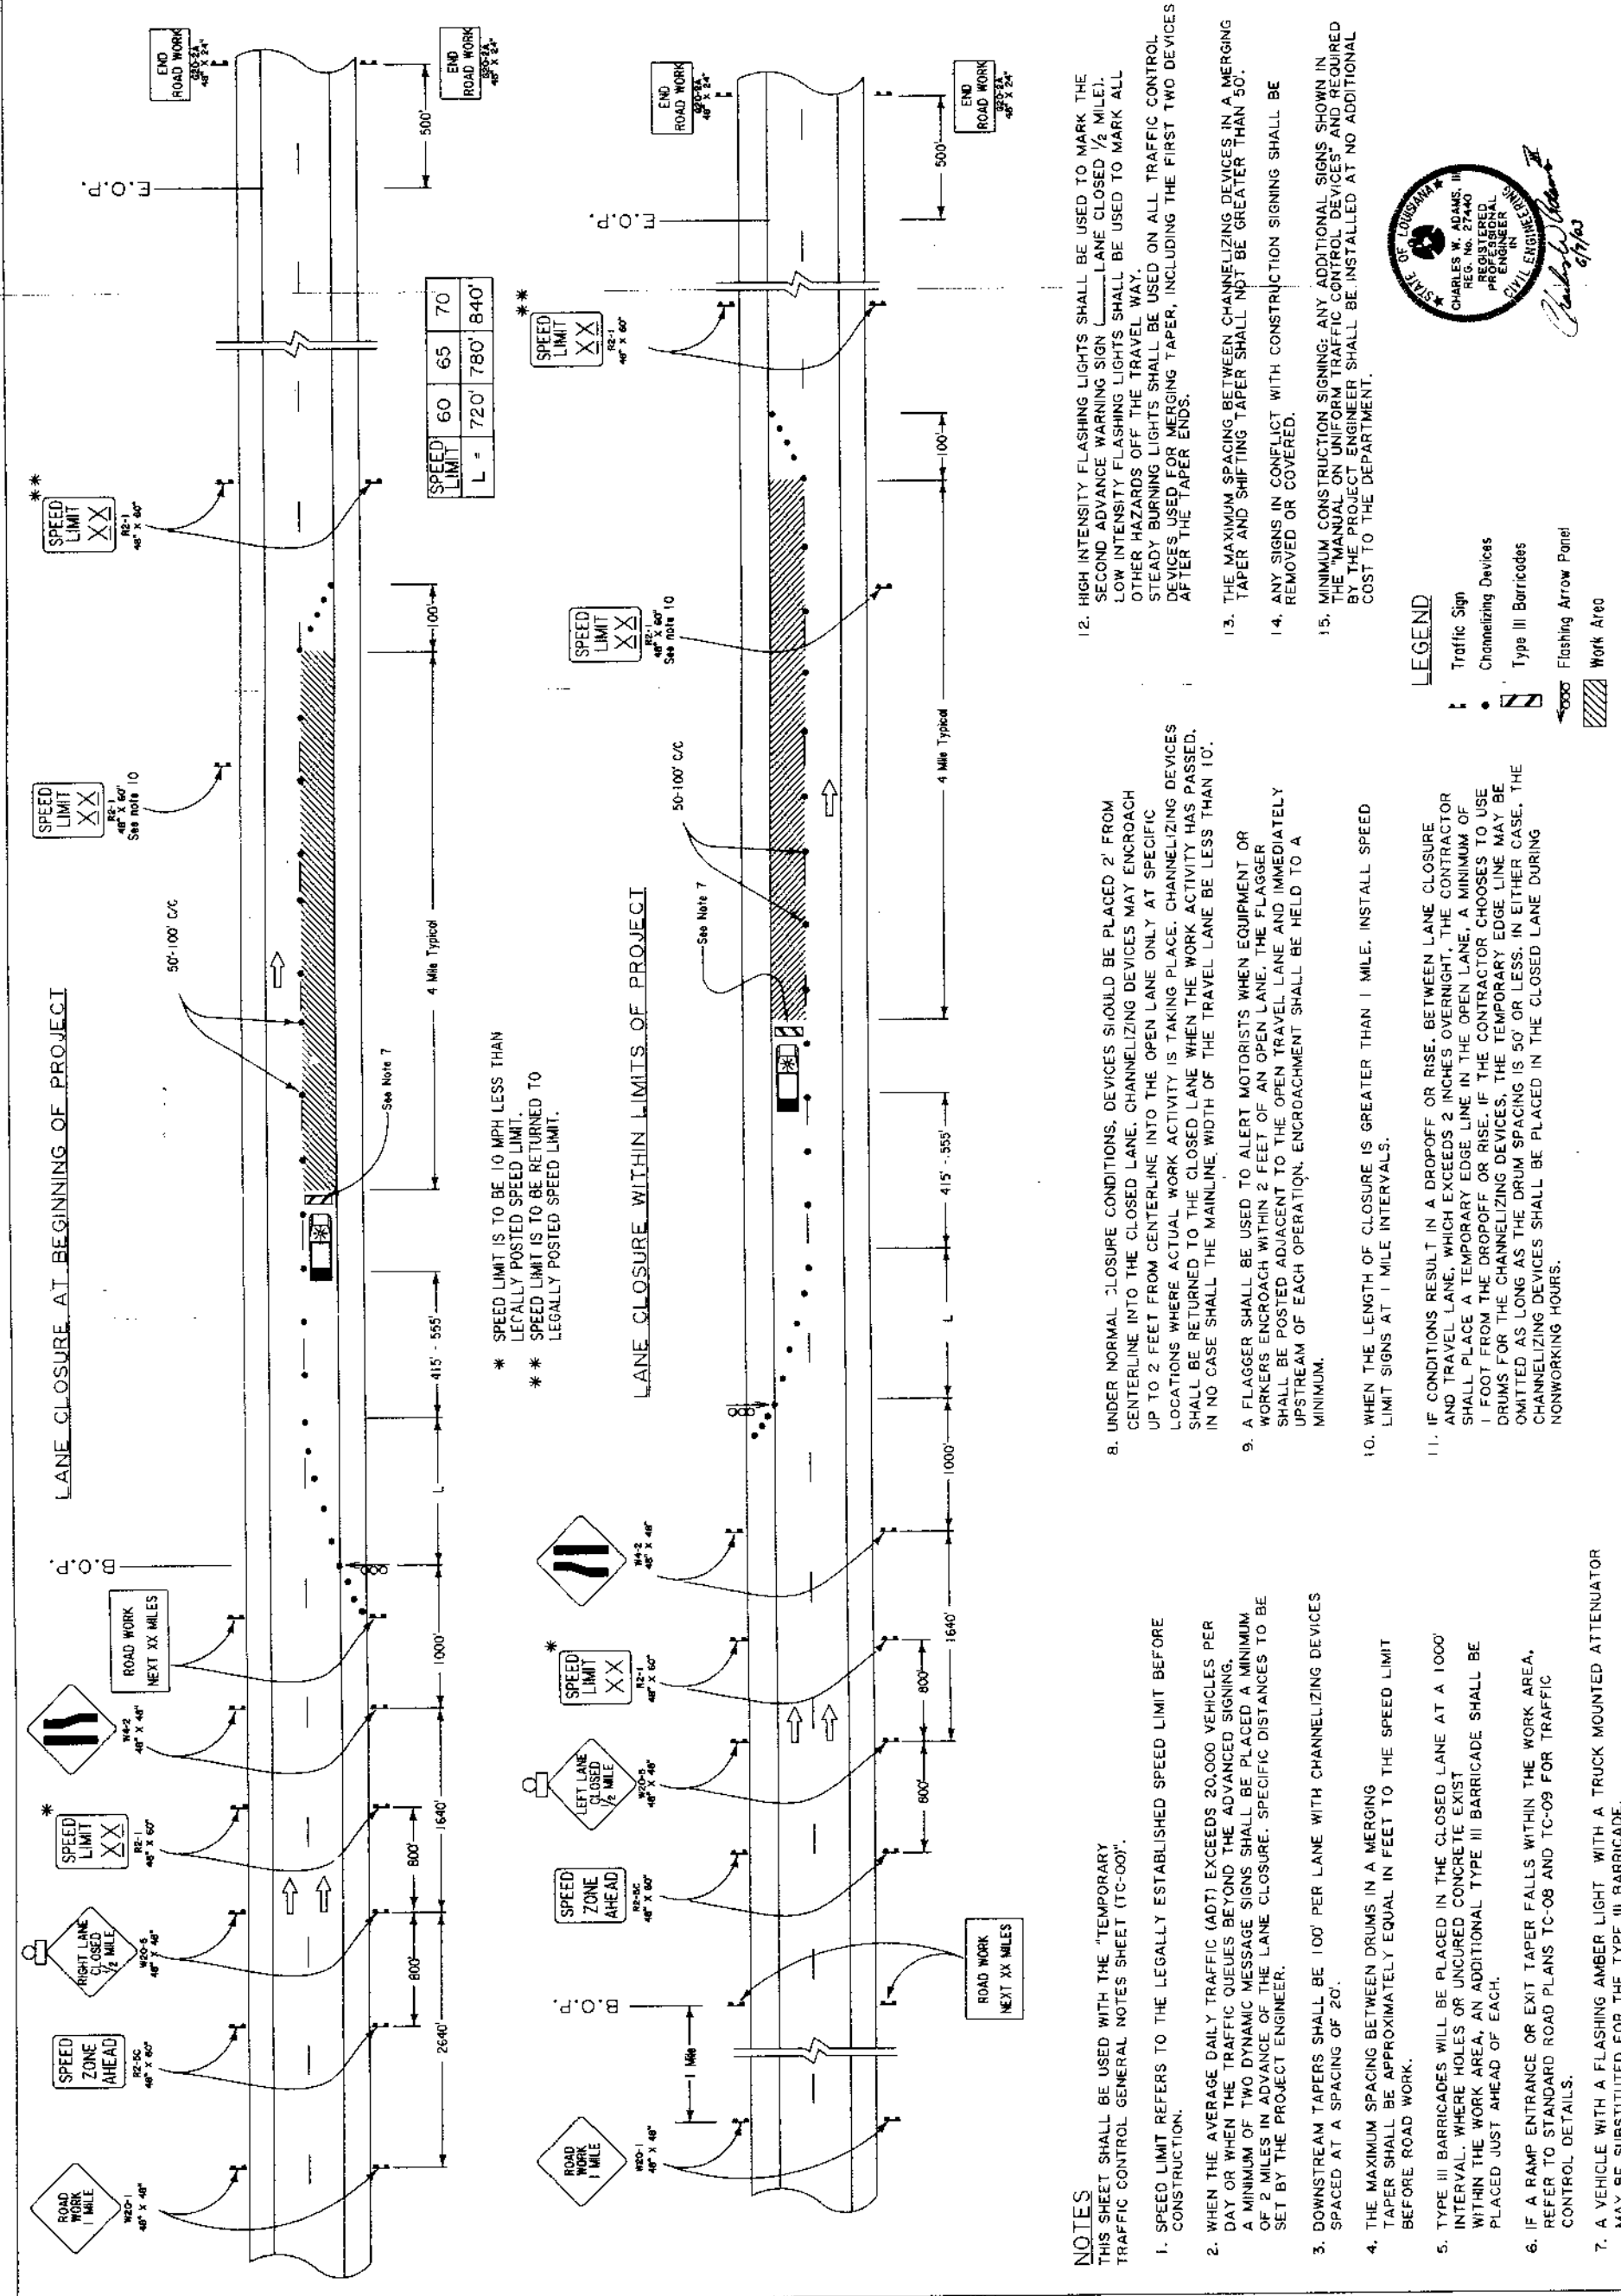


- NOTES
- THIS SHEET SHALL BE USED WITH THE "TEMPORARY TRAFFIC CONTROL GENERAL NOTES SHEET (TC-00)".
- SPEED LIMIT REFERS TO THE LEGALLY ESTABLISHED SPEED LIMIT BEFORE CONSTRUCTION.
 - WHEN THE AVERAGE DAILY TRAFFIC (ADT) EXCEEDS 20,000 VEHICLES PER DAY OR WHEN THE TRAFFIC QUEUES BEYOND THE ADVANCED SIGNING, A MINIMUM OF TWO DYNAMIC MESSAGE SIGNS SHALL BE PLACED A MINIMUM OF 2 MILES IN ADVANCE OF THE LANE CLOSURE. SPECIFIC DISTANCES TO BE SET BY THE PROJECT ENGINEER.
 - DOWNSIDE TAPERS SHALL BE 100' PER LANE WITH CHANNELIZING DEVICES SPACED AT A SPACING OF 20'.
 - THE MAXIMUM SPACING BETWEEN DRUMS IN A MERGING TAPER SHALL BE APPROXIMATELY EQUAL IN FEET TO THE SPEED LIMIT BEFORE ROAD WORK.
 - TYPE III BARRICADES WILL BE PLACED IN THE CLOSED LANE AT A 1000' INTERVAL. WHERE HOLES OR UNCURED CONCRETE EXIST WITHIN THE WORK AREA, AN ADDITIONAL TYPE III BARRICADE SHALL BE PLACED JUST AHEAD OF EACH.
 - IF A RAMP ENTRANCE OR EXIT TAPER FALLS WITHIN THE WORK AREA, REFER TO STANDARD ROAD PLANS TC-08 AND TC-09 FOR TRAFFIC CONTROL DETAILS.
 - A VEHICLE WITH A FLASHING AMBER LIGHT WITH A TRUCK MOUNTED ATTENUATOR MAY BE SUBSTITUTED FOR THE TYPE III BARRICADE.
 - UNDER NORMAL CLOSURE CONDITIONS, DEVICES SHOULD BE PLACED 2' FROM CENTERLINE INTO THE CLOSED LANE. CHANNELIZING DEVICES MAY ENCROACH UP TO 2 FEET FROM CENTERLINE INTO THE OPEN LANE ONLY AT SPECIFIC LOCATIONS WHERE ACTUAL WORK ACTIVITY IS TAKING PLACE. CHANNELIZING DEVICES SHALL BE RETURNED TO THE CLOSED LANE WHEN THE WORK ACTIVITY HAS PASSED. IN NO CASE SHALL THE MAINLINE WIDTH OF THE TRAVEL LANE BE LESS THAN 10'.
 - A FLAGGER SHALL BE USED TO ALERT MOTORISTS WHEN EQUIPMENT OR WORKERS ENCROACH WITHIN 2 FEET OF AN OPEN LANE. THE FLAGGER SHALL BE POSTED ADJACENT TO THE OPEN TRAVEL LANE AND IMMEDIATELY UPSTREAM OF EACH OPERATION. ENCROACHMENT SHALL BE HELD TO A MINIMUM.
 - WHEN THE LENGTH OF CLOSURE IS GREATER THAN 1 MILE, INSTALL SPEED LIMIT SIGNS AT 1 MILE INTERVALS.
 - IF CONDITIONS RESULT IN A DROPOFF OR RISE, BETWEEN LANE CLOSURE AND TRAVEL LANE, WHICH EXCEEDS 2 INCHES OVERNIGHT, THE CONTRACTOR SHALL PLACE A TEMPORARY EDGE LINE IN THE OPEN LANE. A MINIMUM OF 1 FOOT FROM THE DROPOFF OR RISE. IF THE CONTRACTOR CHOOSES TO USE DRUMS FOR THE CHANNELIZING DEVICES, THE TEMPORARY EDGE LINE MAY BE OMITTED AS LONG AS THE DRUM SPACING IS 50' OR LESS. IN EITHER CASE, THE CHANNELIZING DEVICES SHALL BE PLACED IN THE CLOSED LANE DURING NONWORKING HOURS.
 - MINIMUM CONSTRUCTION SIGNING: ANY ADDITIONAL SIGNS SHOWN IN THE "MANUAL OF UNIFORM TRAFFIC CONTROL DEVICES" AND REQUIRED BY THE PROJECT ENGINEER SHALL BE INSTALLED AT NO ADDITIONAL COST TO THE DEPARTMENT.
 - ANY SIGNS IN CONFLICT WITH CONSTRUCTION SIGNING SHALL BE REMOVED OR COVERED.
 - THE MAXIMUM SPACING BETWEEN CHANNELIZING DEVICES IN A MERGING TAPER AND SHIFTING TAPER SHALL NOT BE GREATER THAN 50'.
 - HIGH INTENSITY FLASHING LIGHTS SHALL BE USED TO MARK THE SECOND ADVANCE WARNING SIGN (LANE CLOSED 1/2 MILE). LOW INTENSITY FLASHING LIGHTS SHALL BE USED TO MARK ALL OTHER HAZARDS OFF THE TRAVEL WAY. STEADY BURNING LIGHTS SHALL BE USED ON ALL TRAFFIC CONTROL DEVICES USED FOR MERGING TAPER, INCLUDING THE FIRST TWO DEVICES AFTER THE TAPER ENDS.

FREEWAY ENTRANCE WITH RIGHT LANE CLOSED

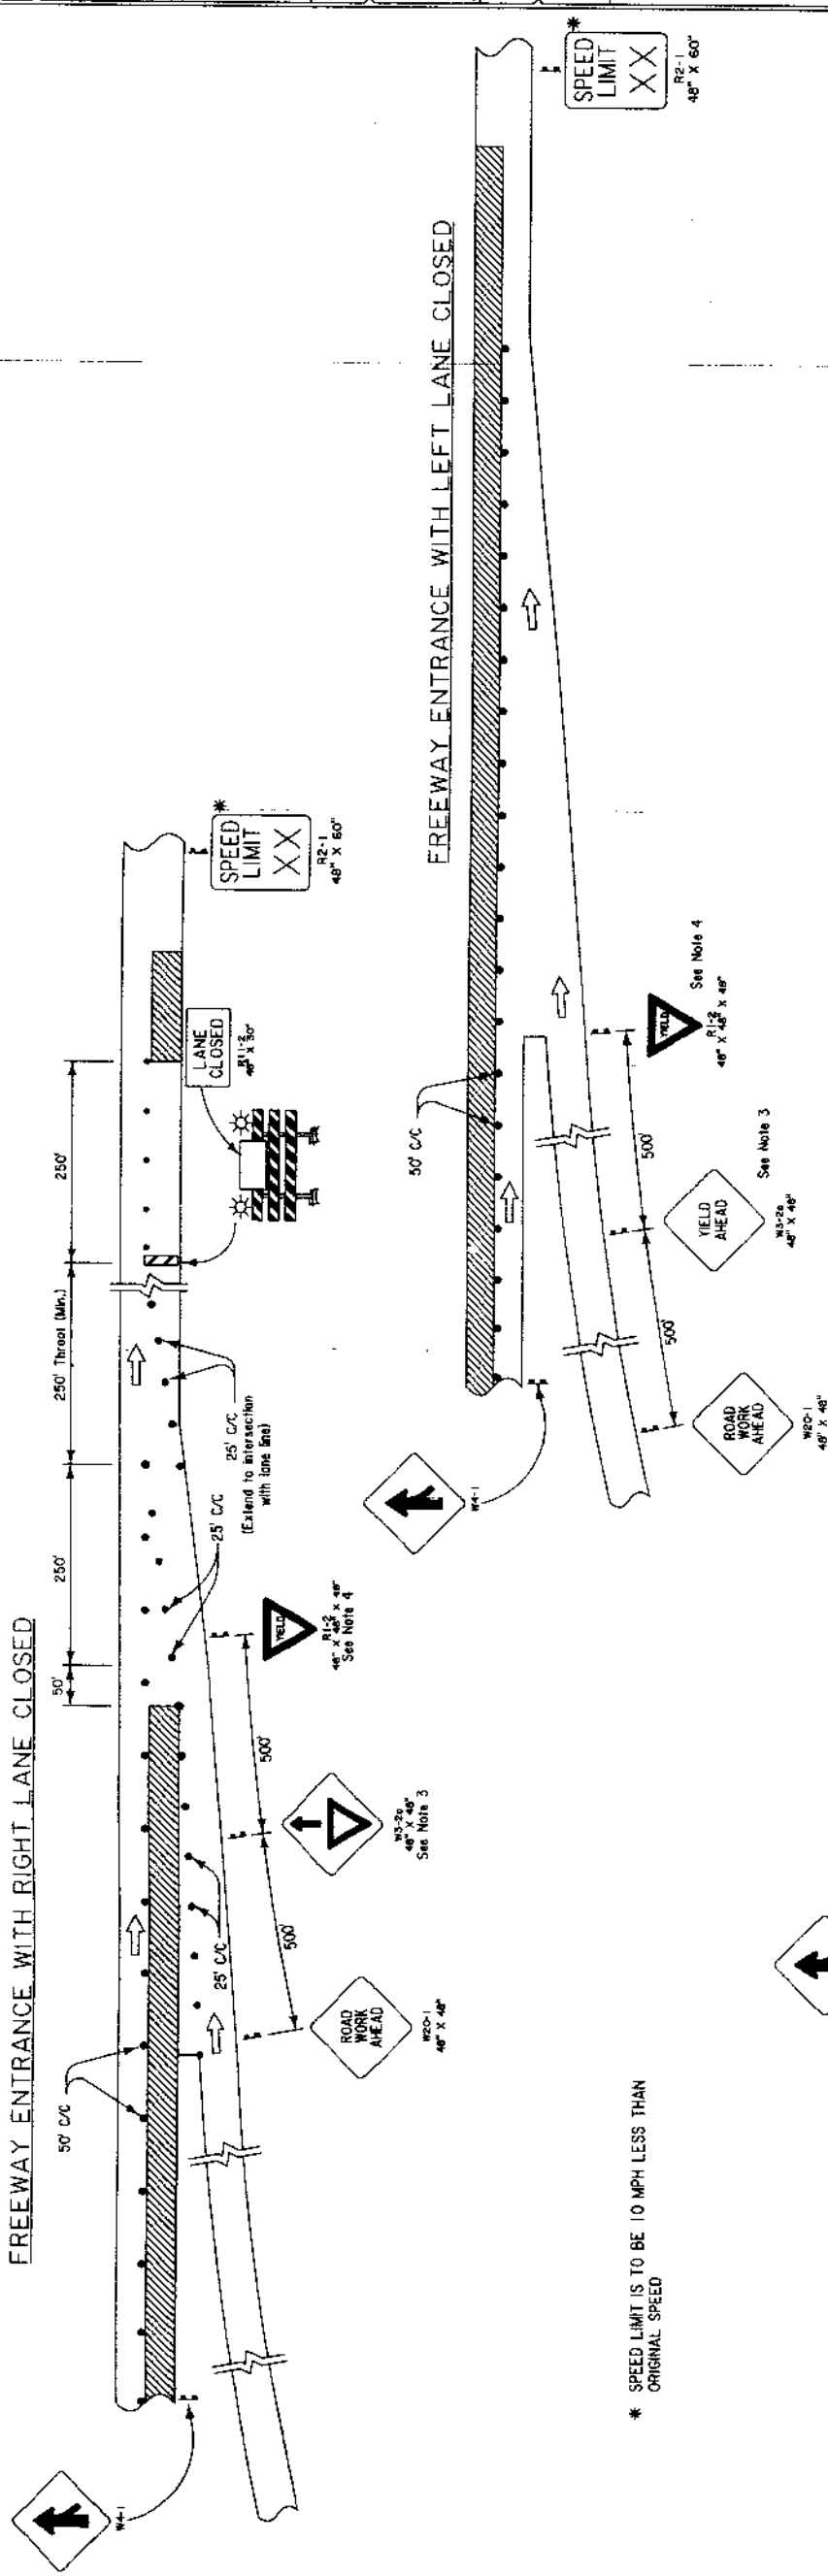

* SPEED LIMIT IS TO BE 10 MPH LESS THAN ORIGINAL SPEED

FREEWAY ENTRANCE VIA MEDIAN CROSSOVER

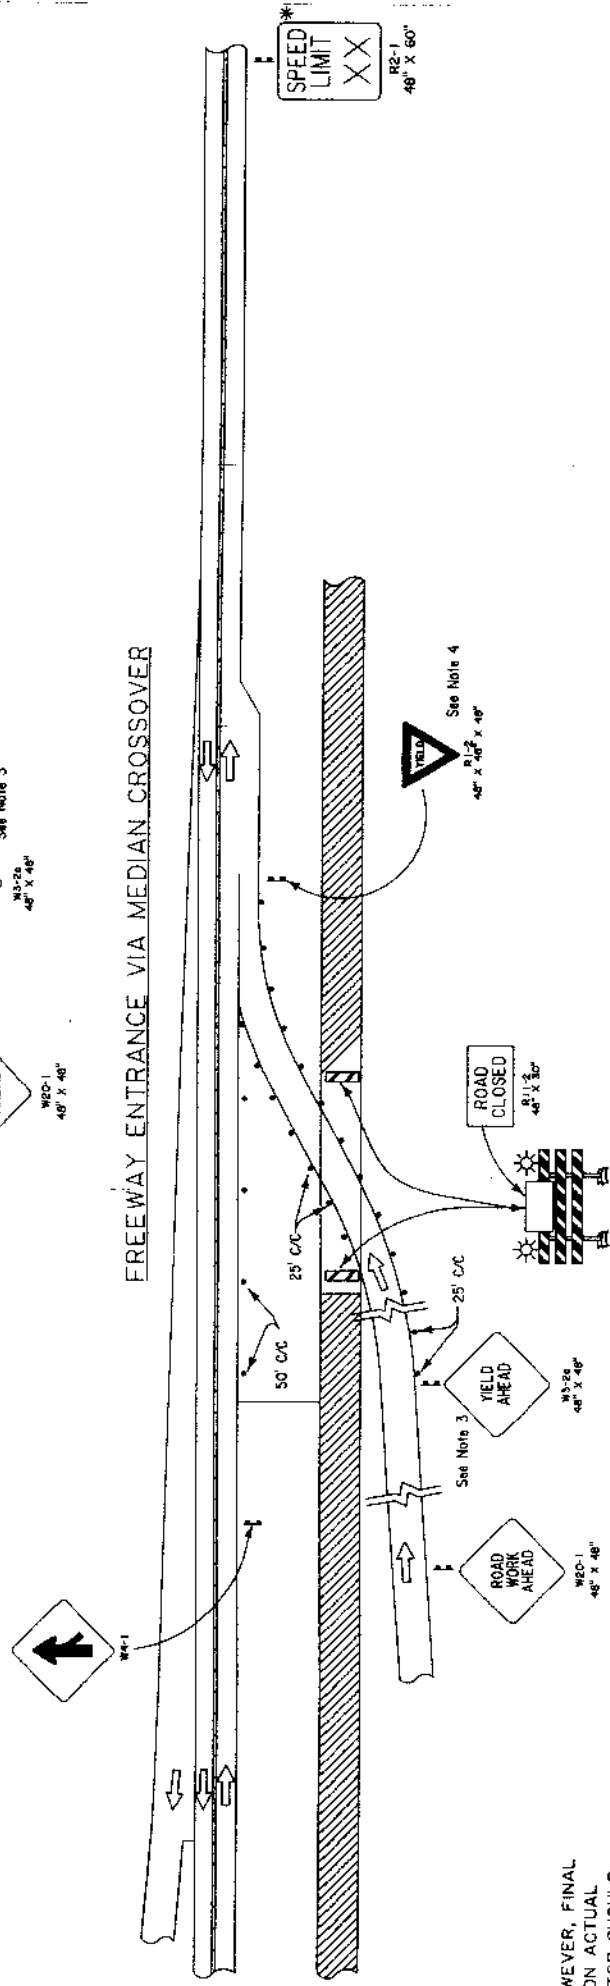

NOTE

TYPICAL APPLICATIONS, HOWEVER, FINAL DESIGN SHOULD BE BASED ON ACTUAL GEOMETRICS. THE CONTRACTOR SHOULD CONSULT WITH THE PROJECT ENGINEER.

LEGEND

- Traffic Sign
- Channelizing Devices
- Type III Barricades
- Work Area

NOTES

- THIS SHEET SHALL BE USED WITH THE "TEMPORARY TRAFFIC CONTROL GENERAL NOTES SHEET (TC-00)".
- FOR MAINLINE LANE CLOSURES SEE OTHER SHEETS.
- CHANNELIZING DEVICES ON THE LANE LINE SHALL BE OF THE SAME TYPE. CHANNELIZING DEVICES IN EACH TAPER SHALL BE OF THE SAME TYPE.
- THE "YIELD AHEAD" SIGN IS REQUIRED EXCEPT FOR SHORT TERM MAINTENANCE OPERATIONS WHERE ITS USE MAY BE AN OPTION AS DETERMINED BY THE PROJECT ENGINEER.

- USE EXISTING "YIELD" SIGN IF PRESENT, OTHERWISE FURNISH "YIELD" SIGN. WHERE INADEQUATE ACCELERATION DISTANCE EXISTS FOR THE TEMPORARY ENTRANCE, THE YIELD SIGN SHALL BE REPLACED WITH STOP SIGNS (ONE ON EACH SIDE OF THE APPROACH), AND STOP AHEAD SIGNS SHALL REPLACE THE YIELD AHEAD SIGNS.
- LOCATION OF CHANNELIZING DEVICES WITHIN THE GORE AREA TO BE BASED ON DRIVER SIGHT DISTANCE. TO BE DETERMINED BY THE DISTRICT TRAFFIC OPERATIONS ENGINEER.
- ANY SIGNS IN CONFLICT WITH CONSTRUCTION SIGNING SHALL BE REMOVED OR COVERED.

7. MINIMUM CONSTRUCTION SIGNING: ANY ADDITIONAL SIGNS SHOWN IN THE "MANUAL ON UNIFORM TRAFFIC CONTROL DEVICES" AND REQUIRED BY THE PROJECT ENGINEER SHALL BE INSTALLED AT NO ADDITIONAL COST TO THE DEPARTMENT.







TRAFFIC CONTROL LAYOUT
FOR WORK AREA THROUGH
RAMP ENTRANCE TAPER
TC-08



TRAFFIC
ENGINEERING

PROJECT: ST. CHARLES
SHEET: 46
DATE: 06/02/03
DESIGNED: C. ADAMS
CHECKED: C. ADAMS
PROJECT: 4503(509)
STATE: 450-37-0020

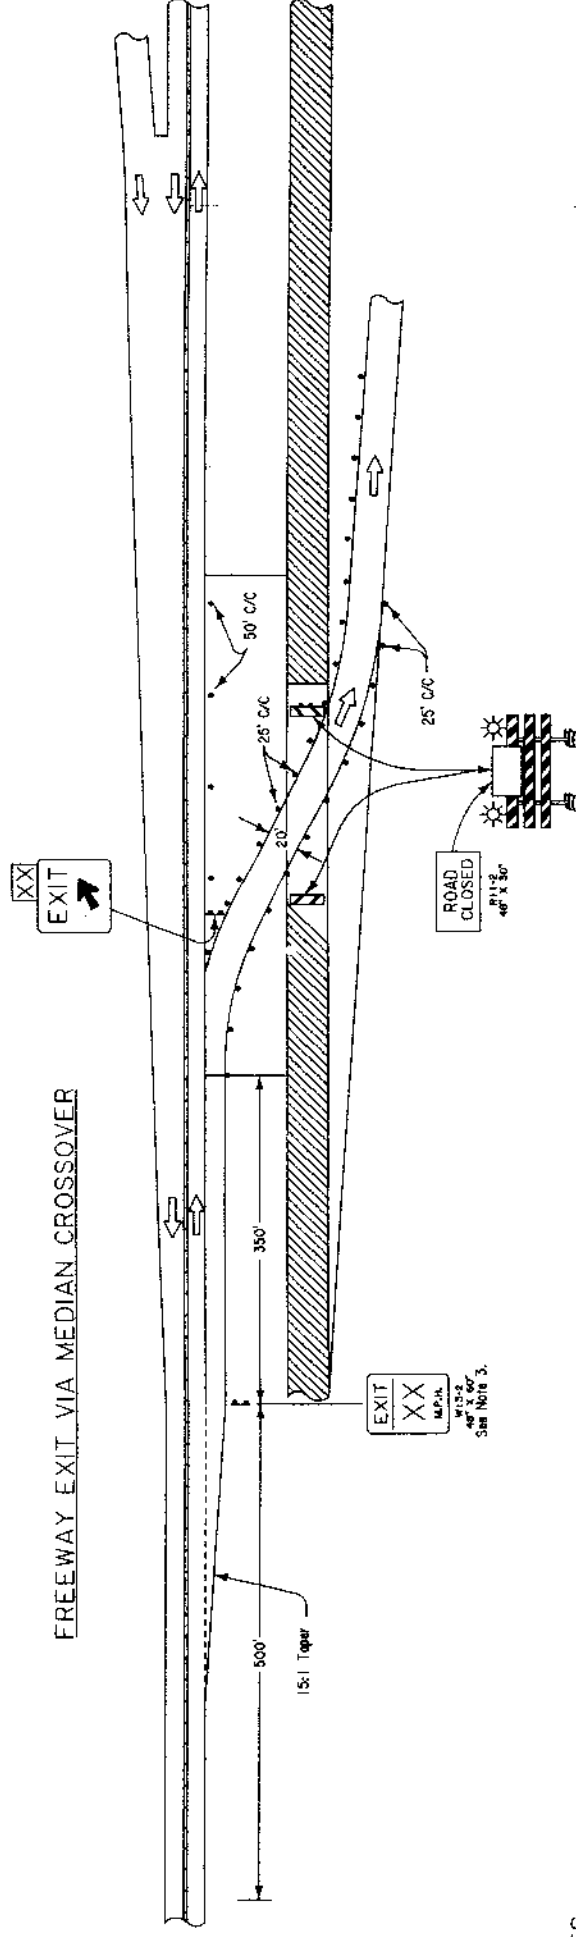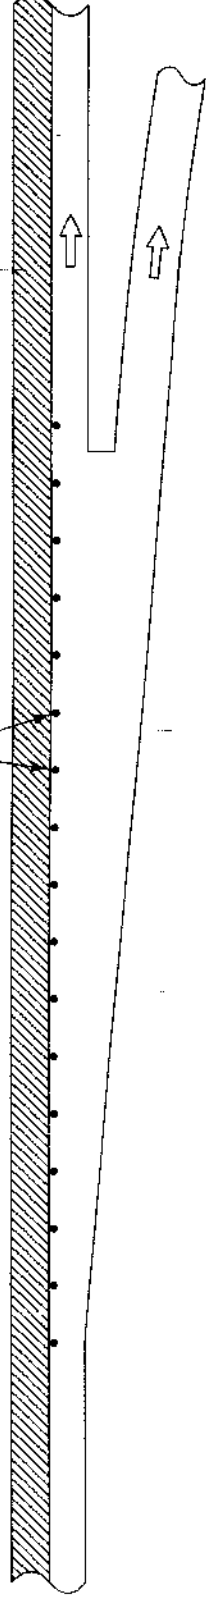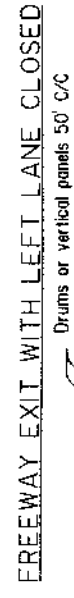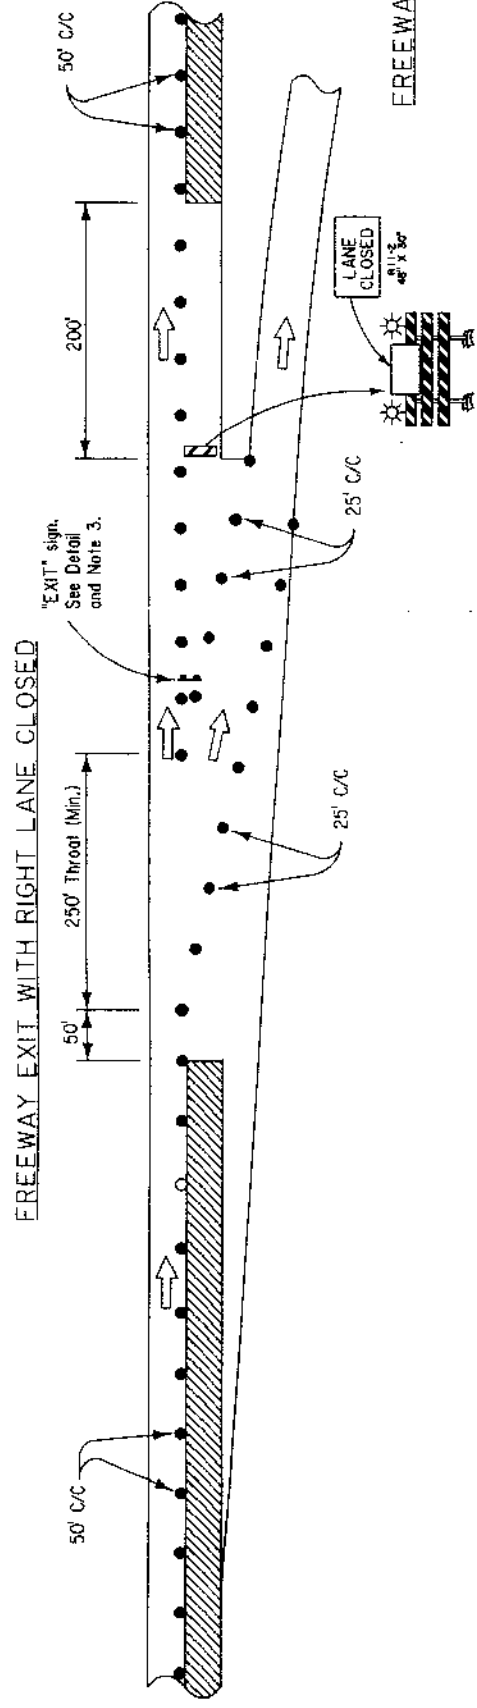

NOTES


THIS SHEET SHALL BE USED WITH THE "TEMPORARY TRAFFIC CONTROL GENERAL NOTES SHEET (TC-00)".

1. FOR MAINLINE LANE CLOSURES SEE OTHER SHEETS.
2. CHANNELIZING DEVICES ON THE LANE LINE SHALL BE OF THE SAME TYPE. CHANNELIZING DEVICES IN EACH TAPER SHALL BE OF THE SAME TYPE.
3. THE MOUNTING HEIGHT OF THE TEMPORARY "EXIT" SIGN SHALL BE A MINIMUM OF 7 FEET FROM THE PAVEMENT SURFACE TO THE BOTTOM OF THE SIGN. THE EXISTING GREEN AND WHITE "EXIT" SIGN SHALL BE COVERED. IF THE TEMPORARY "EXIT" SIGN WILL BE IN PLACE FOR MORE THAN ONE DAY, AN "EXIT NUMBER PANEL" DISPLAYING THE PROPER EXIT NUMBER SHALL BE PLACED ABOVE THE TEMPORARY "EXIT" SIGN.
5. ANY SIGNS IN CONFLICT WITH CONSTRUCTION SIGNING SHALL BE REMOVED OR COVERED.
6. MINIMUM CONSTRUCTION SIGNING: ANY ADDITIONAL SIGNS SHOWN IN THE "MANUAL ON UNIFORM TRAFFIC CONTROL DEVICES" AND REQUIRED BY THE PROJECT ENGINEER SHALL BE INSTALLED AT NO ADDITIONAL COST TO THE DEPARTMENT.

4. EXIT SPEED TO BE SET ACCORDING TO DESIGN CRITERIA FOR THE CROSSOVER.

STATE OF LOUISIANA
 CHARLES W. ADAMS, III
 REG. NO. 27440
 REGISTERED PROFESSIONAL ENGINEER
 MECHANICAL ENGINEERING

Charles W. Roberts
6/7/03

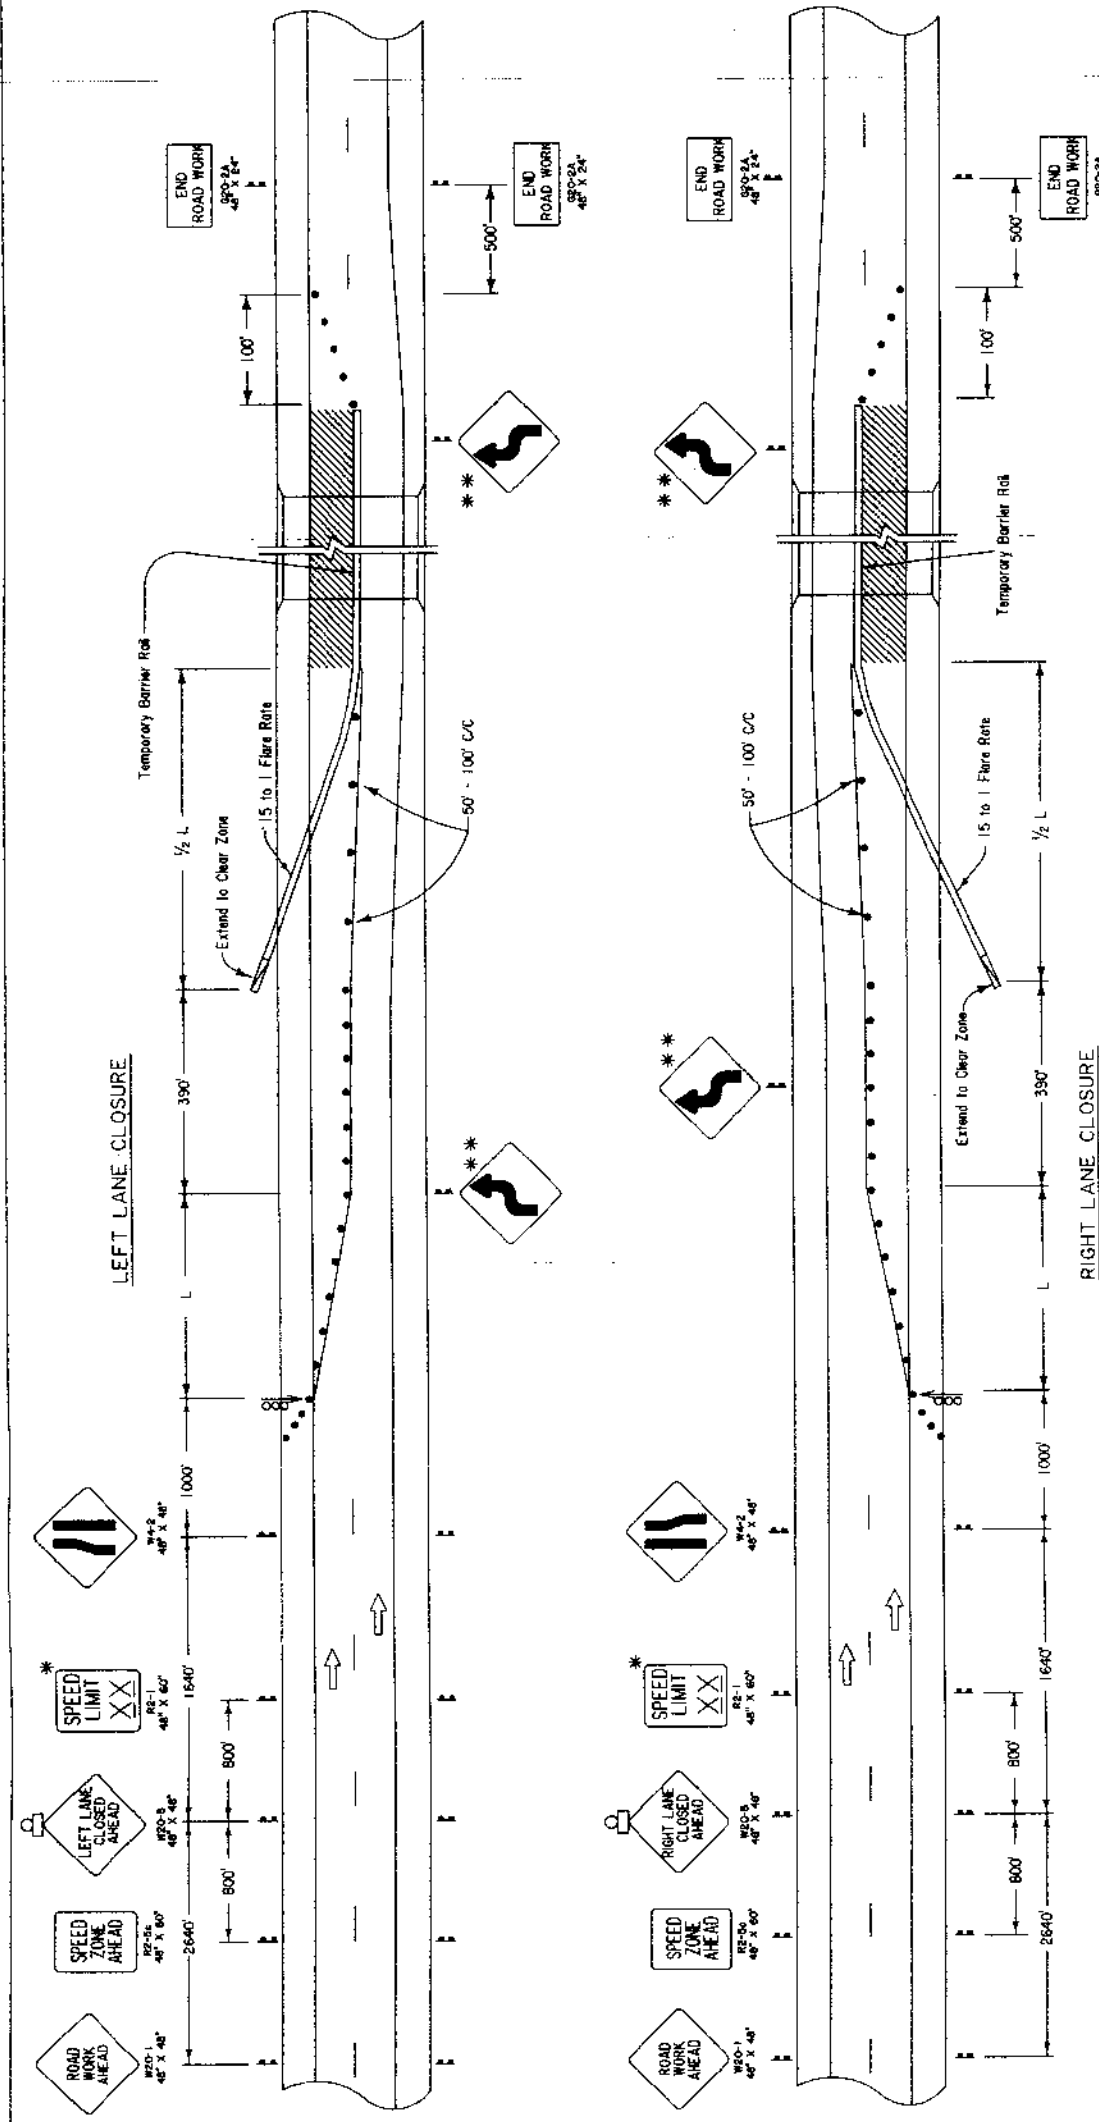

SPEED LIMIT	55	60	65	70
L =	660'	720'	780'	840'

LEGEND

- Traffic Sign
- Channelizing Devices
- Flashing Arrow Panel (Type 'C')
- Work Area
- Type B Light


NOTES

THIS SHEET SHALL BE USED WITH THE "TEMPORARY TRAFFIC CONTROL GENERAL NOTES SHEET (TC-00)".


- THE MAXIMUM SPACING BETWEEN CHANNELIZING DEVICES IN A MERGING TAPER SHALL BE APPROXIMATELY EQUAL IN FEET TO THE SPEED LIMIT.
- CHANNELIZING DEVICES ON THE LANE LINE SHALL BE OF THE SAME TYPE.
- IF A RAMP ENTRANCE OR EXIT TAPER FALLS WITHIN THE WORK AREA, REFER TO STANDARD ROAD PLAN TC-08 AND TC-09 FOR TRAFFIC CONTROL DETAILS.
- DOWNSIDE TAPERS SHALL CONTAIN A MINIMUM OF 4 CHANNELIZING DEVICES.
- BROKEN LANE LINE SHALL BE REMOVED IN AREA OF TAPER.
- REFLECTORS SHALL BE MOUNTED BACK-TO-BACK ON EACH SECTION OF TEMPORARY BARRIER RAIL. REFLECTORS SHALL FACE ONCOMING TRAFFIC AS INDICATED.
- PARKING OF VEHICLES OR UNATTENDED EQUIPMENT, OR STORAGE OF MATERIALS, WITHIN THE CLEAR ZONE SHALL NOT BE PERMITTED UNLESS PROTECTED BY FUNCTIONING BARRIER RAIL.
- ANY SIGNS IN CONFLICT WITH CONSTRUCTION SIGNING SHALL BE REMOVED OR COVERED.
- MINIMUM CONSTRUCTION SIGNING: ANY ADDITIONAL SIGNS SHOWN IN THE "MANUAL ON UNIFORM TRAFFIC CONTROL DEVICES" AND REQUIRED BY THE PROJECT ENGINEER SHALL BE INSTALLED AT NO ADDITIONAL COST TO THE DEPARTMENT.

* SPEED LIMIT IS TO BE 10 MPH LESS THAN ORIGINAL SPEED

** TO BE USED ONLY WHEN A LANE SHIFT IS UTILIZED

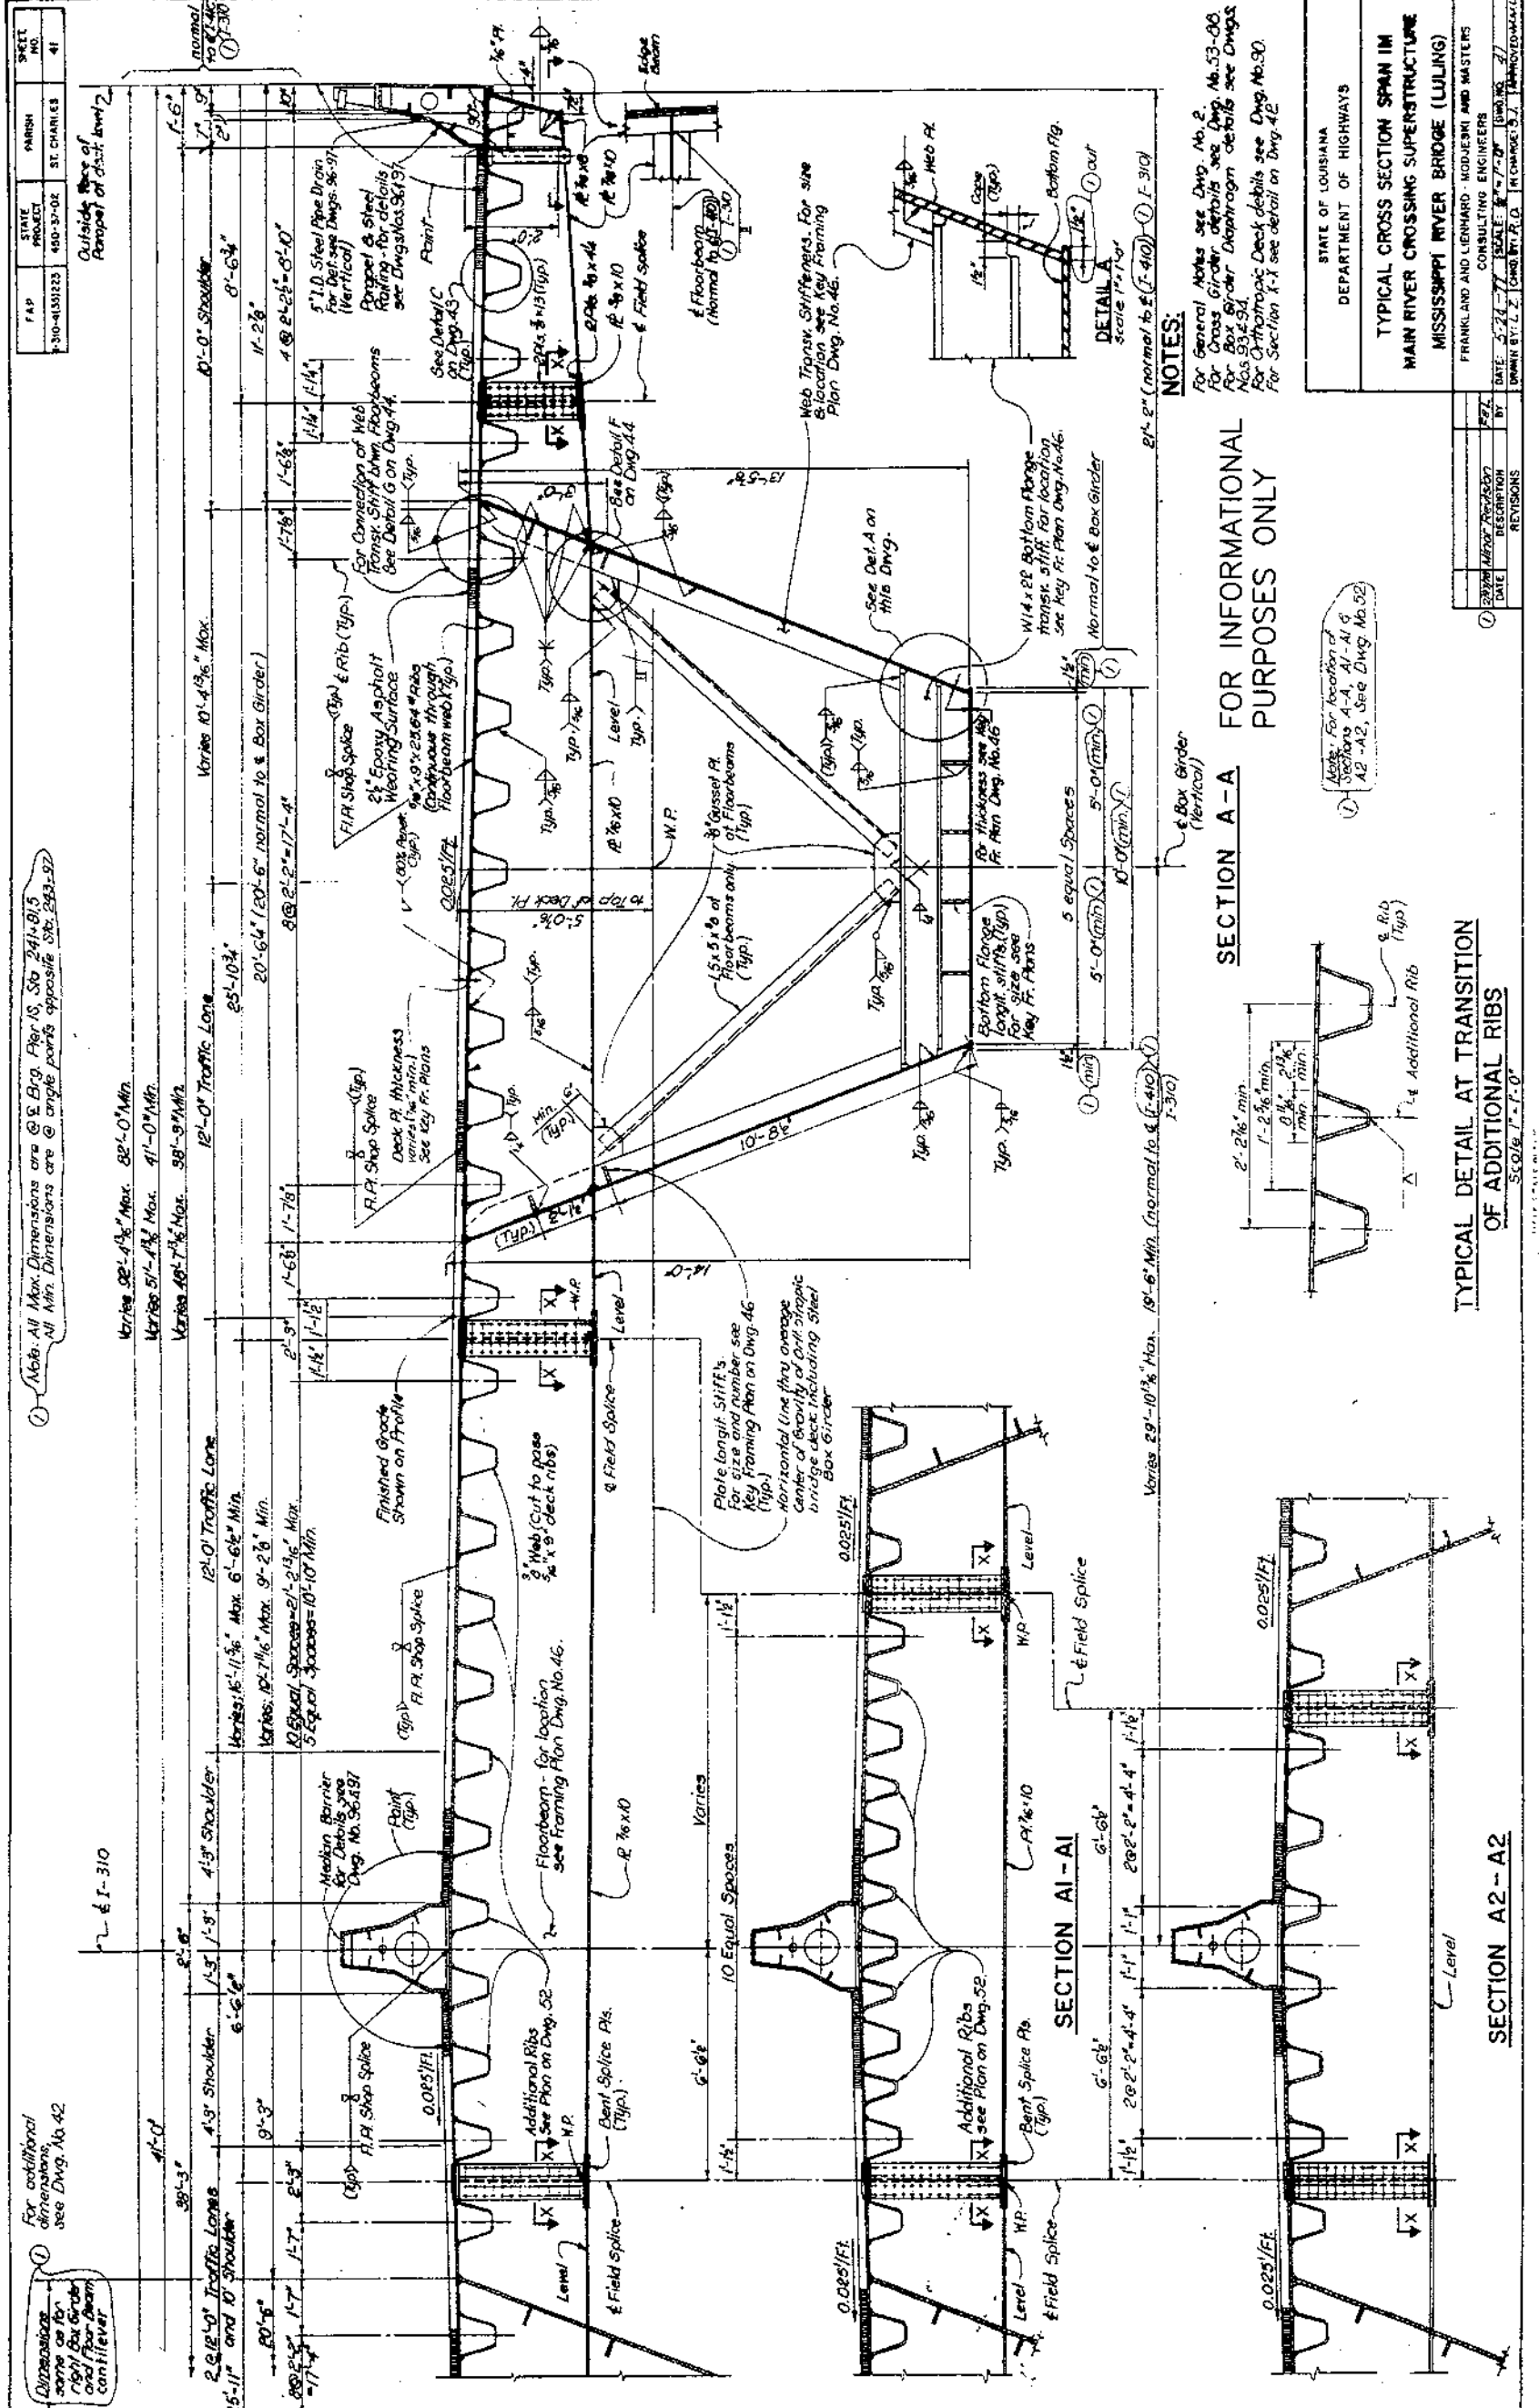


SECTION A-A FOR INFORMATIONAL PURPOSES ONLY

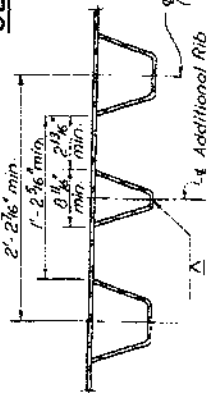

SECTION A1-A1

SECTION A2-A2

NOTES:
For General Notes see Dwg. No. 2.
For Cross Girder details see Dwg. No. 53-08.
For Box Girder Diaphragm details see Dwg. No. 53-09.
For Diaphragm Deck details see Dwg. No. 53-10.
For Section A-1 see detail on Dwg. 42.

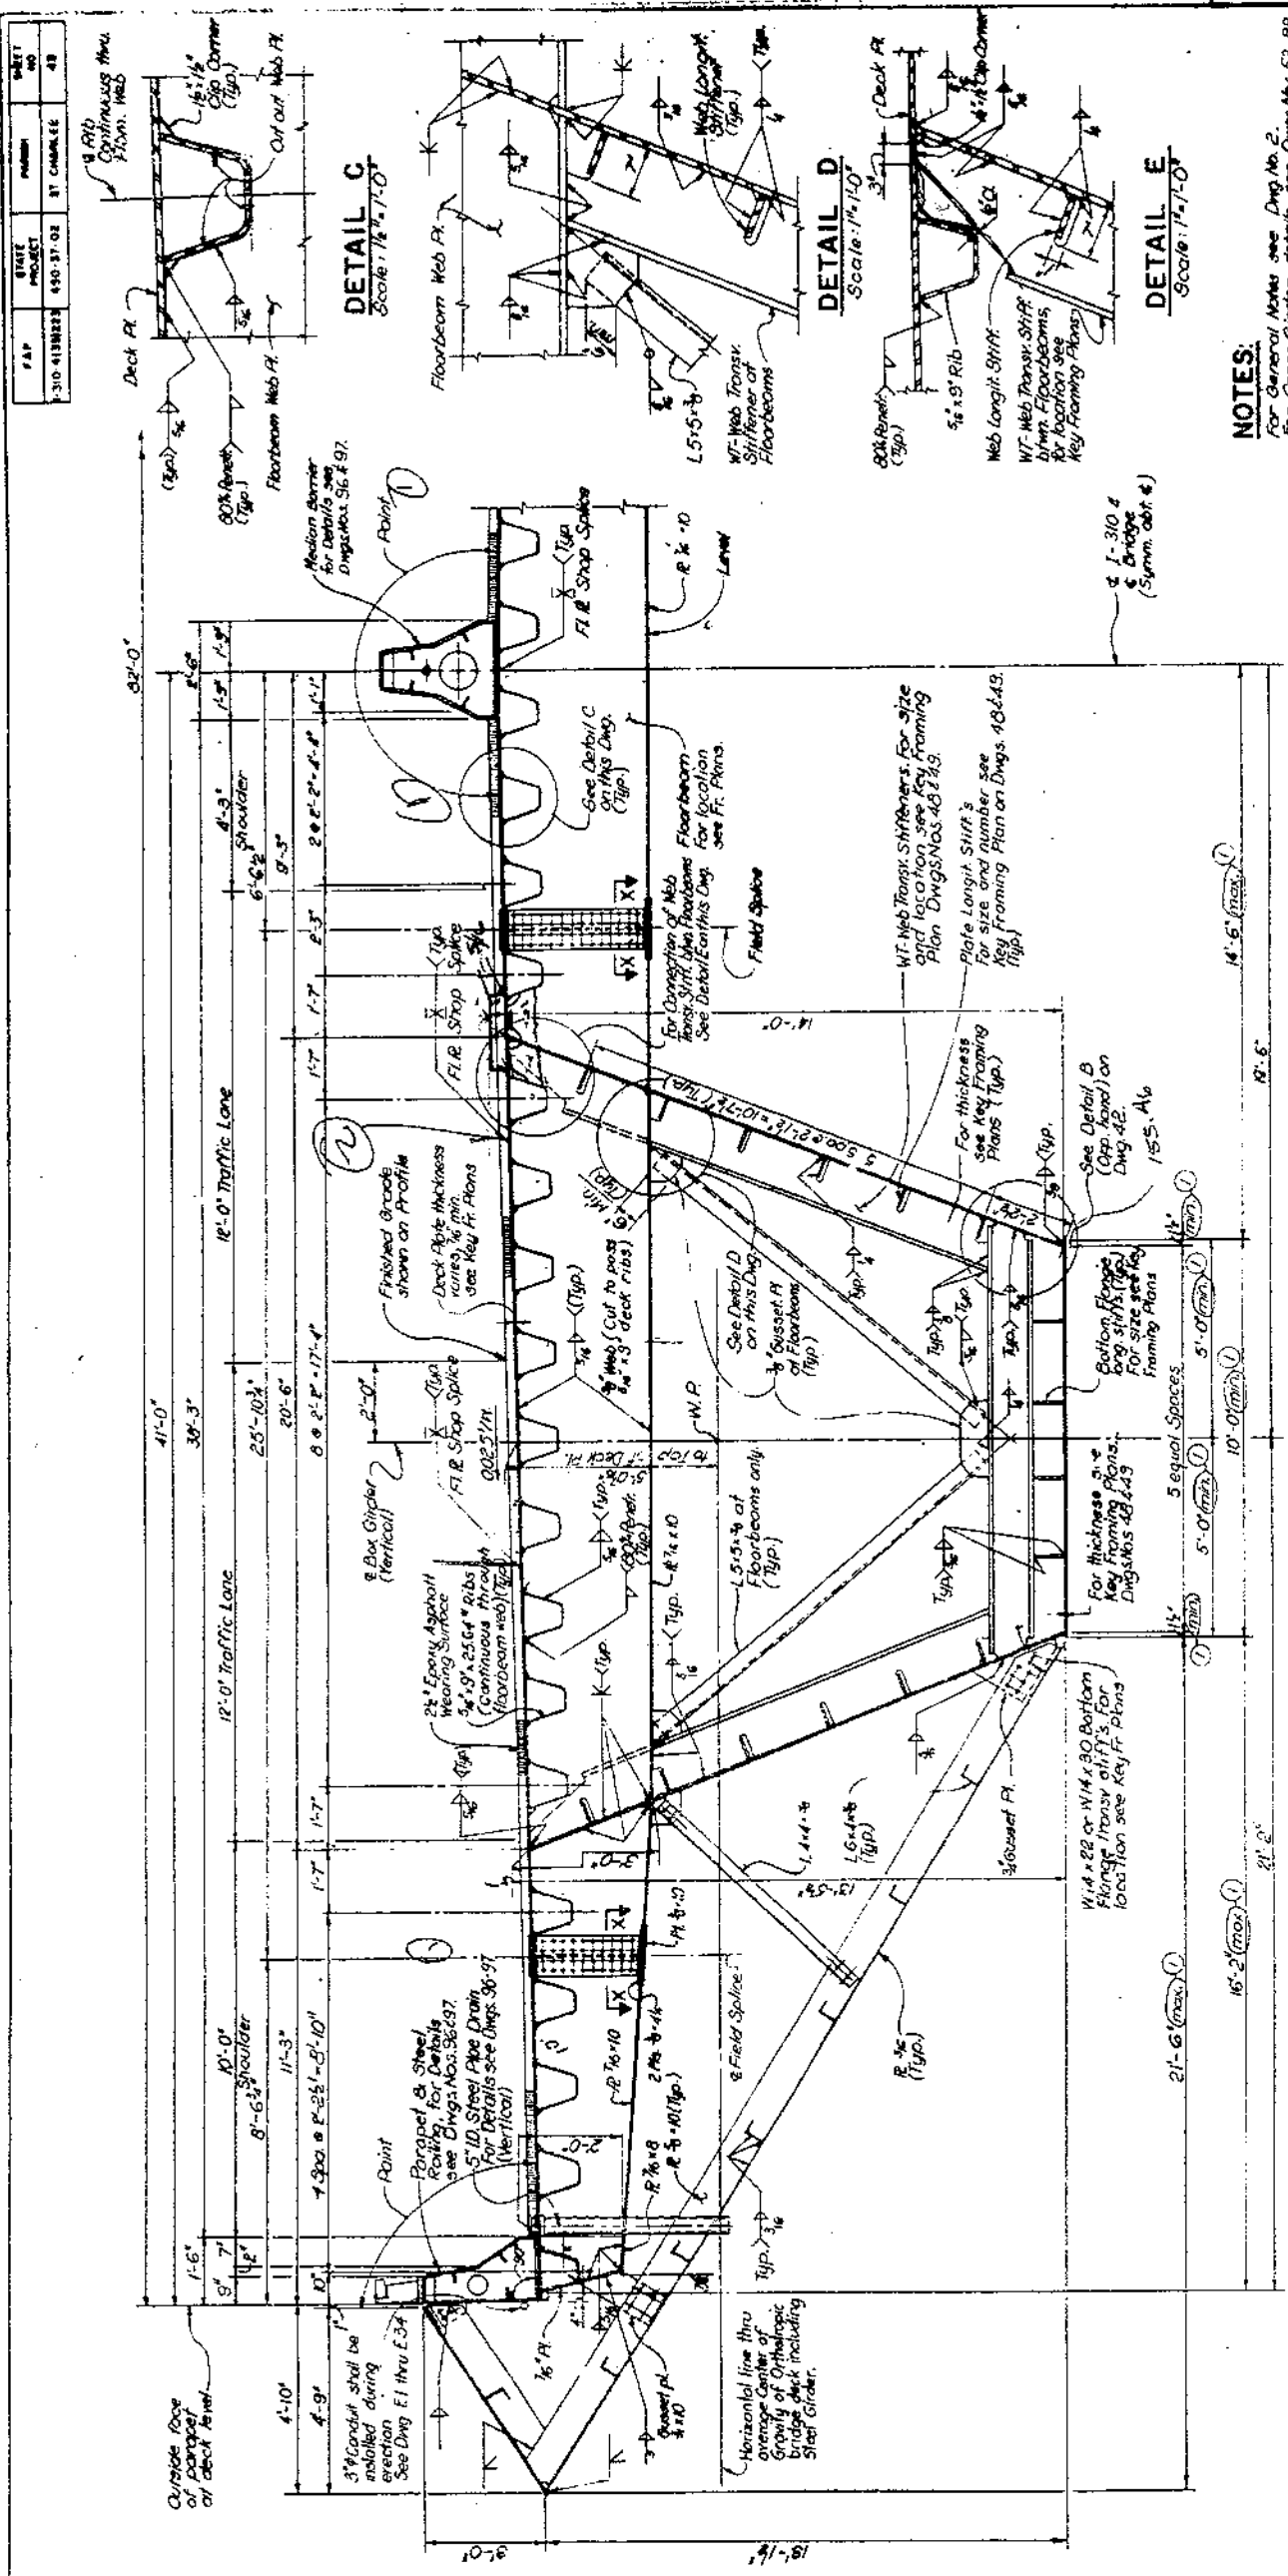

NOTES:
For General
For Cross G
For Box G
Drops/Was. S
For Orthom
For Section

STATE OF LOUISIANA
DEPARTMENT OF HIGHWAYS

TYPICAL CROSS SECTION SPAN 3M
MAIN RIVER CROSSING WATERSTRUCTURES
MISSISSIPPI RIVER BRIDGE (LUL 1461)


FRAMES AND LEMNISCATE TABLES AND DRAWING

— CORONA TYPE CHANGERS —

DATE 5-24-77
DRAWN BY A.C. [signature] BY [signature]
CHECKED BY [signature] BY [signature]

FOR INFORMATIONAL
PURPOSES ONLY

SECTION C-C

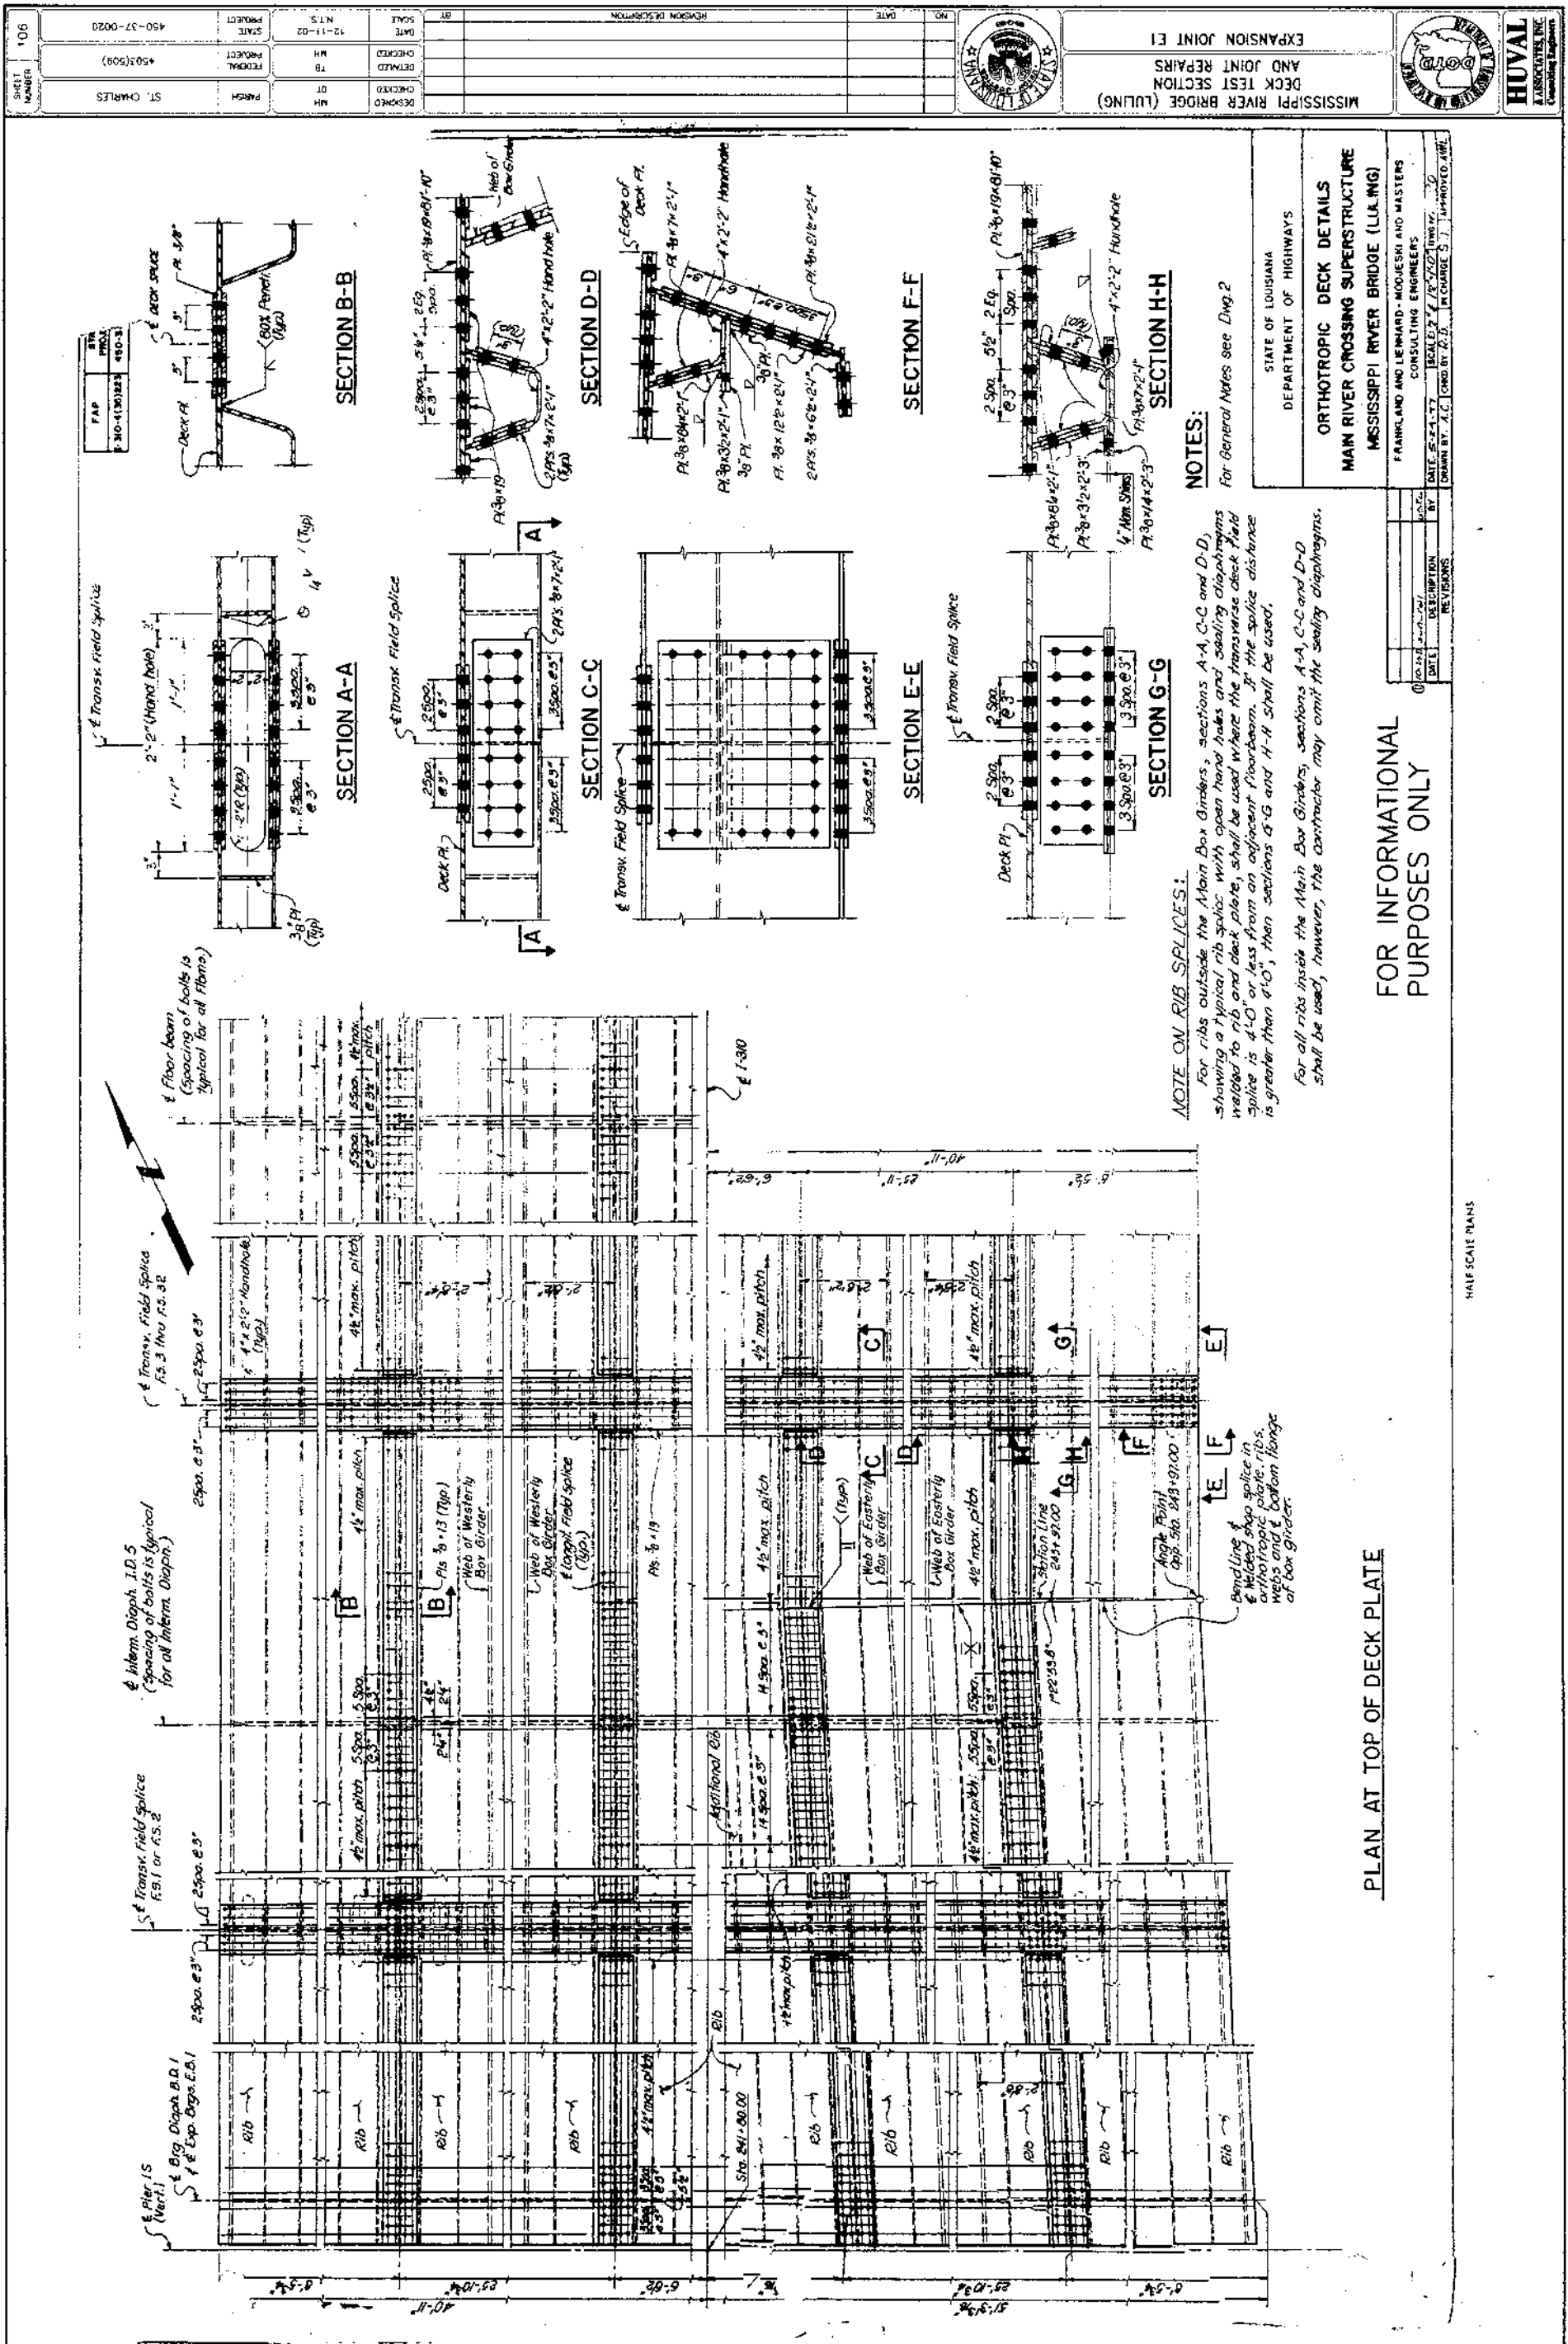

PLAN AT TOP OF DECK PLATE

HALF SCALE PLANS

NOTE ON RIB SPLICES:
For ribs outside the Main Box Binders, sections A-A, C-C and D-D, showing a typical rib splice with open hand holes and sealing diaphragms welded to rib and deck plate, shall be used where the transverse deck field splice is 4'-0" or less from an adjacent floorbeam. If the splice distance is greater than 4'-0", then sections G-G and H-H shall be used.
For all ribs inside the Main Box Binders, sections A-A, C-C and D-D shall be used, however, the contractor may omit the sealing diaphragms.

NOTES:
For General Notes see Div. 2

FOR INFORMATIONAL
PURPOSES ONLY

STATE OF LOUISIANA
DEPARTMENT OF HIGHWAYS
ORTHOTROPIC DECK DETAILS
MAIN RIVER CROSSING SUPERSTRUCTURE
MISSISSIPPI RIVER BRIDGE (LULUNG)

FRANKLAND AND LEONARD MOORE AND ASSOCIATES
CONSULTING ENGINEERS
DATE: 6-24-77
LOCAL: 6-24-77
DRAWN BY: A.C. (CND BY: D.D.)
IN CHARGE: S.J. (APPROVED: JRL)

MISSISSIPPI RIVER BRIDGE (LULUNG)
DECK TEST SECTION
AND JOINT REPAIRS
EXPANSION JOINT E1



NO.	DATE	REVISION DESCRIPTION
1	12-11-02	12-11-02
2	12-11-02	12-11-02
MISSISSIPPI RIVER BRIDGE (TULING)
DECK TEST SECTION
AND JOINT REPAIRS
EXPANSION JOINT E2 REPLACEMENT
NORTH END OF BRIDGE



NO.	DATE

[illegible]

DATE	SCALE
12-11-02	N.T.S.

PARISH
FEDERAL
STATE
PROJECT

ST. CHARLES	4503(509)	450-37-0020
-------------	-----------	-------------



FOR INFORMATIONAL PURPOSES ONLY



STATE OF LOUISIANA
DEPARTMENT OF HIGHWAYS

EXPANSION JOINT E2
MAIN RIVER CROSSING SUPERSTRUCTURE
MESSISIPPI RIVER BRIDGE (LL14140)



FRANK AND LEMMAHO - MOD-VISIT AND MASTERS
CONSULTING ENGINEERS

1. The first step in the process is to identify the problem or issue that needs to be addressed. This involves gathering information and understanding the context of the problem.

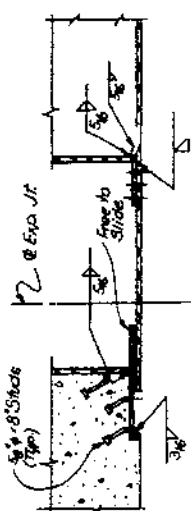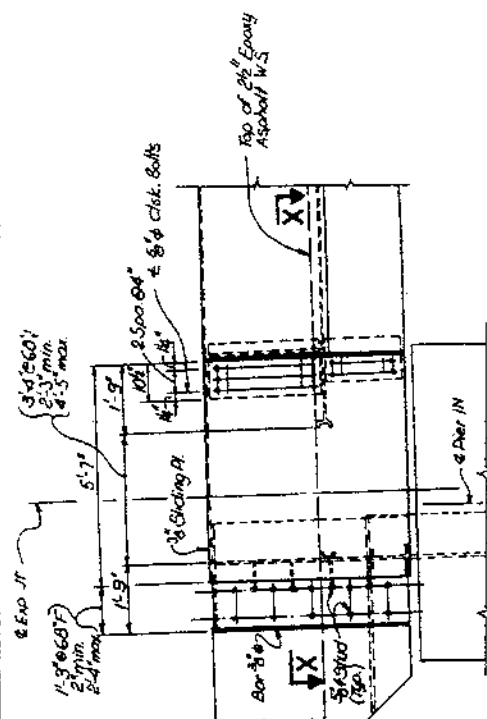

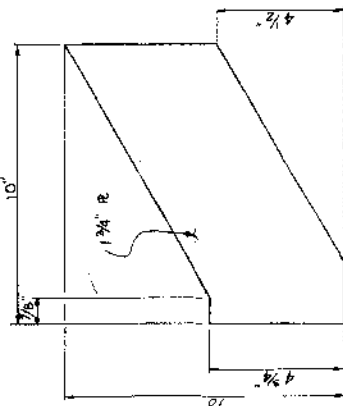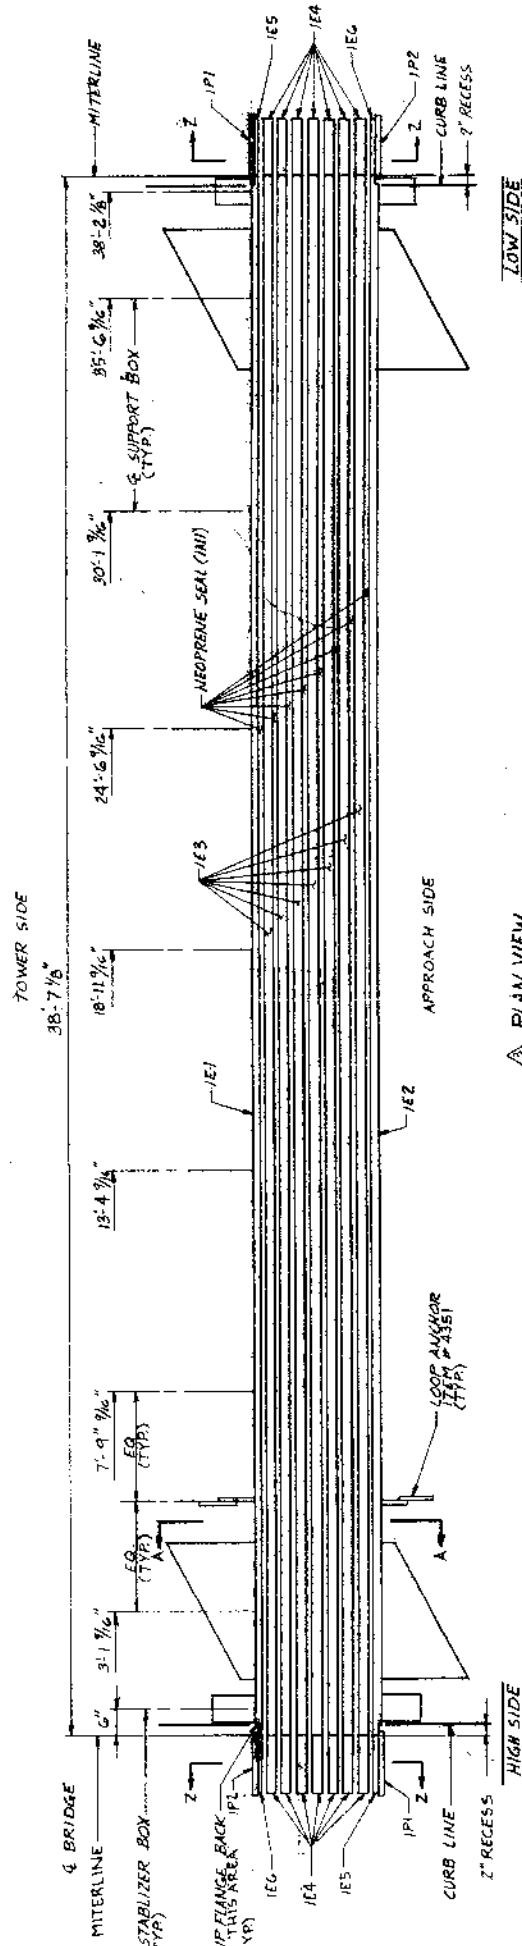


TEMP ADJUSTMENT CHART													
	0°	10°	20°	30°	40°	50°	60°	70°	80°	90°	100°	110°	120°
3:5%	3:5%	3:1%	3:1%	3:0%	2:10%	2:8%	2:6%	2:5%	2:3%	2:1%	1:11%	1:10%	1:8%

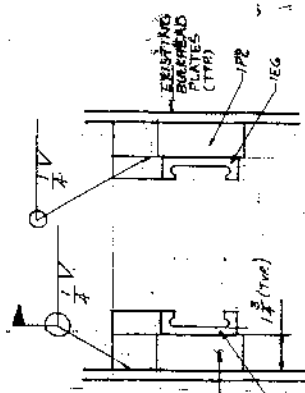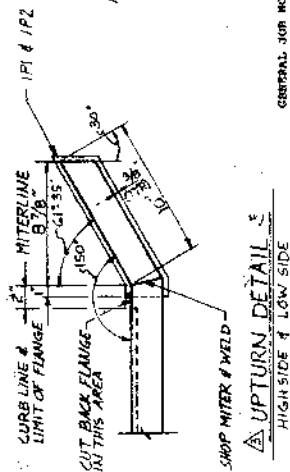

1. The contractor shall verify all dimensions prior to
2. Fabrication and materials shall comply with the 1992 Louisiana Dept. of Transportation Standard Specifications for Roads and Bridges as amended by the contract special
3. Welding shall conform to the AWS Structural Welding Code D1.1-68 as modified by the AASHTO Standard Specifications for Welding of Structural steel Highway Bridges (third edition-1981), and as modified by the contract special
4. All steel surfaces (except stainless steel surfaces and surfaces in contact with the concrete) shall be shop painted with two coats of Valpar AZ-4 Epoxy Zinc Rich Paint. The paint shall be applied to these walls after the concrete
5. The neoprene seals shall be shop installed using the seal installation tools and prima lube adhesive. The prima lube adhesive shall be brush applied to the full perimeter on
6. The ends of the neoprene seals shall be capped using 1/2" x 1/2" x 1/2" neoprene sheet. The sheeting shall be bonded in place using aron alpha adhesive.
7. The neoprene sheet shall be 2'-5' x 2'-5' and shipped

FOR INFORMATIONAL
PURPOSES ONLY

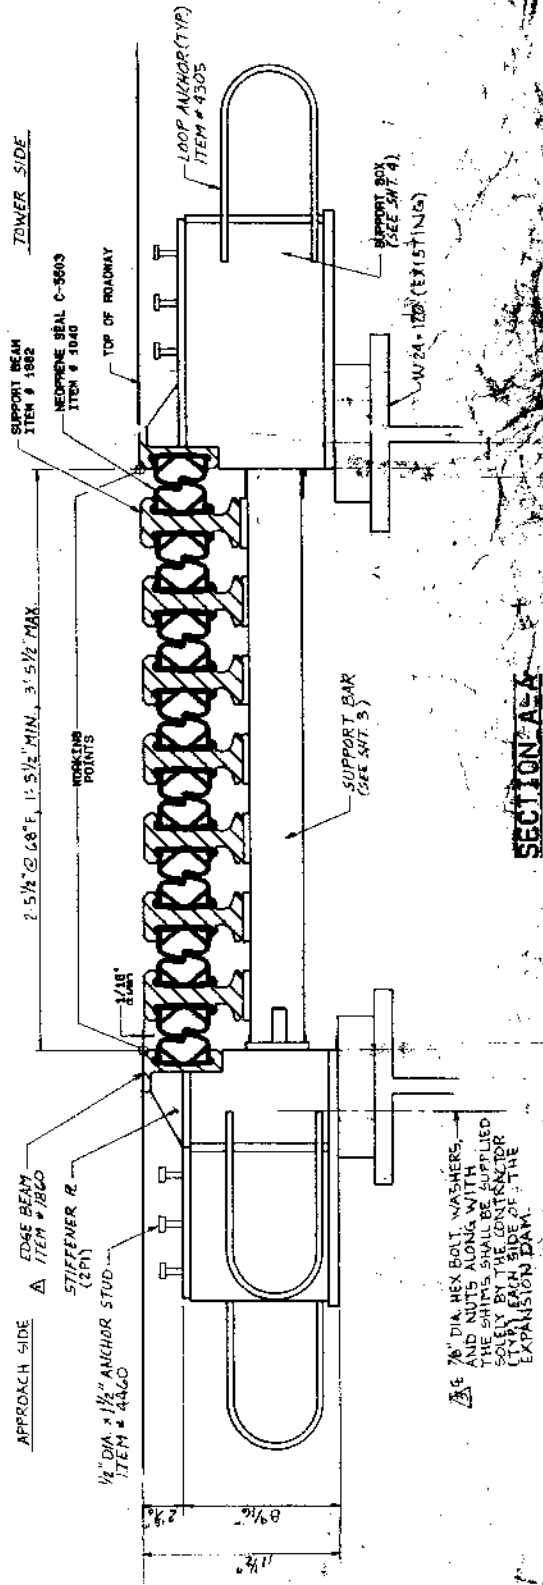


CONTRACTOR: PROFESSIONAL
CONSTRUCTION SERVICES
STATE: LOUISIANA
ST. CHARLES PARISH
F.A.P. NO.: IR-310-4100
STATE PROJECT NO.: 450-2-12
PRODUCT NO.: MODERN
JOINT LOCATION: PIER #1 & FOUNDATION

[illegible]

SECTION A-A

3/4" DIA. HEX BOLT WASHERS,
AND NUTS ALONG WITH
THE SHIMS SHALL BE SUPPLIED
SOLELY BY THE CONTRACTOR
(CLIP EACH SIDE OF THE
EXPANSION DAM.

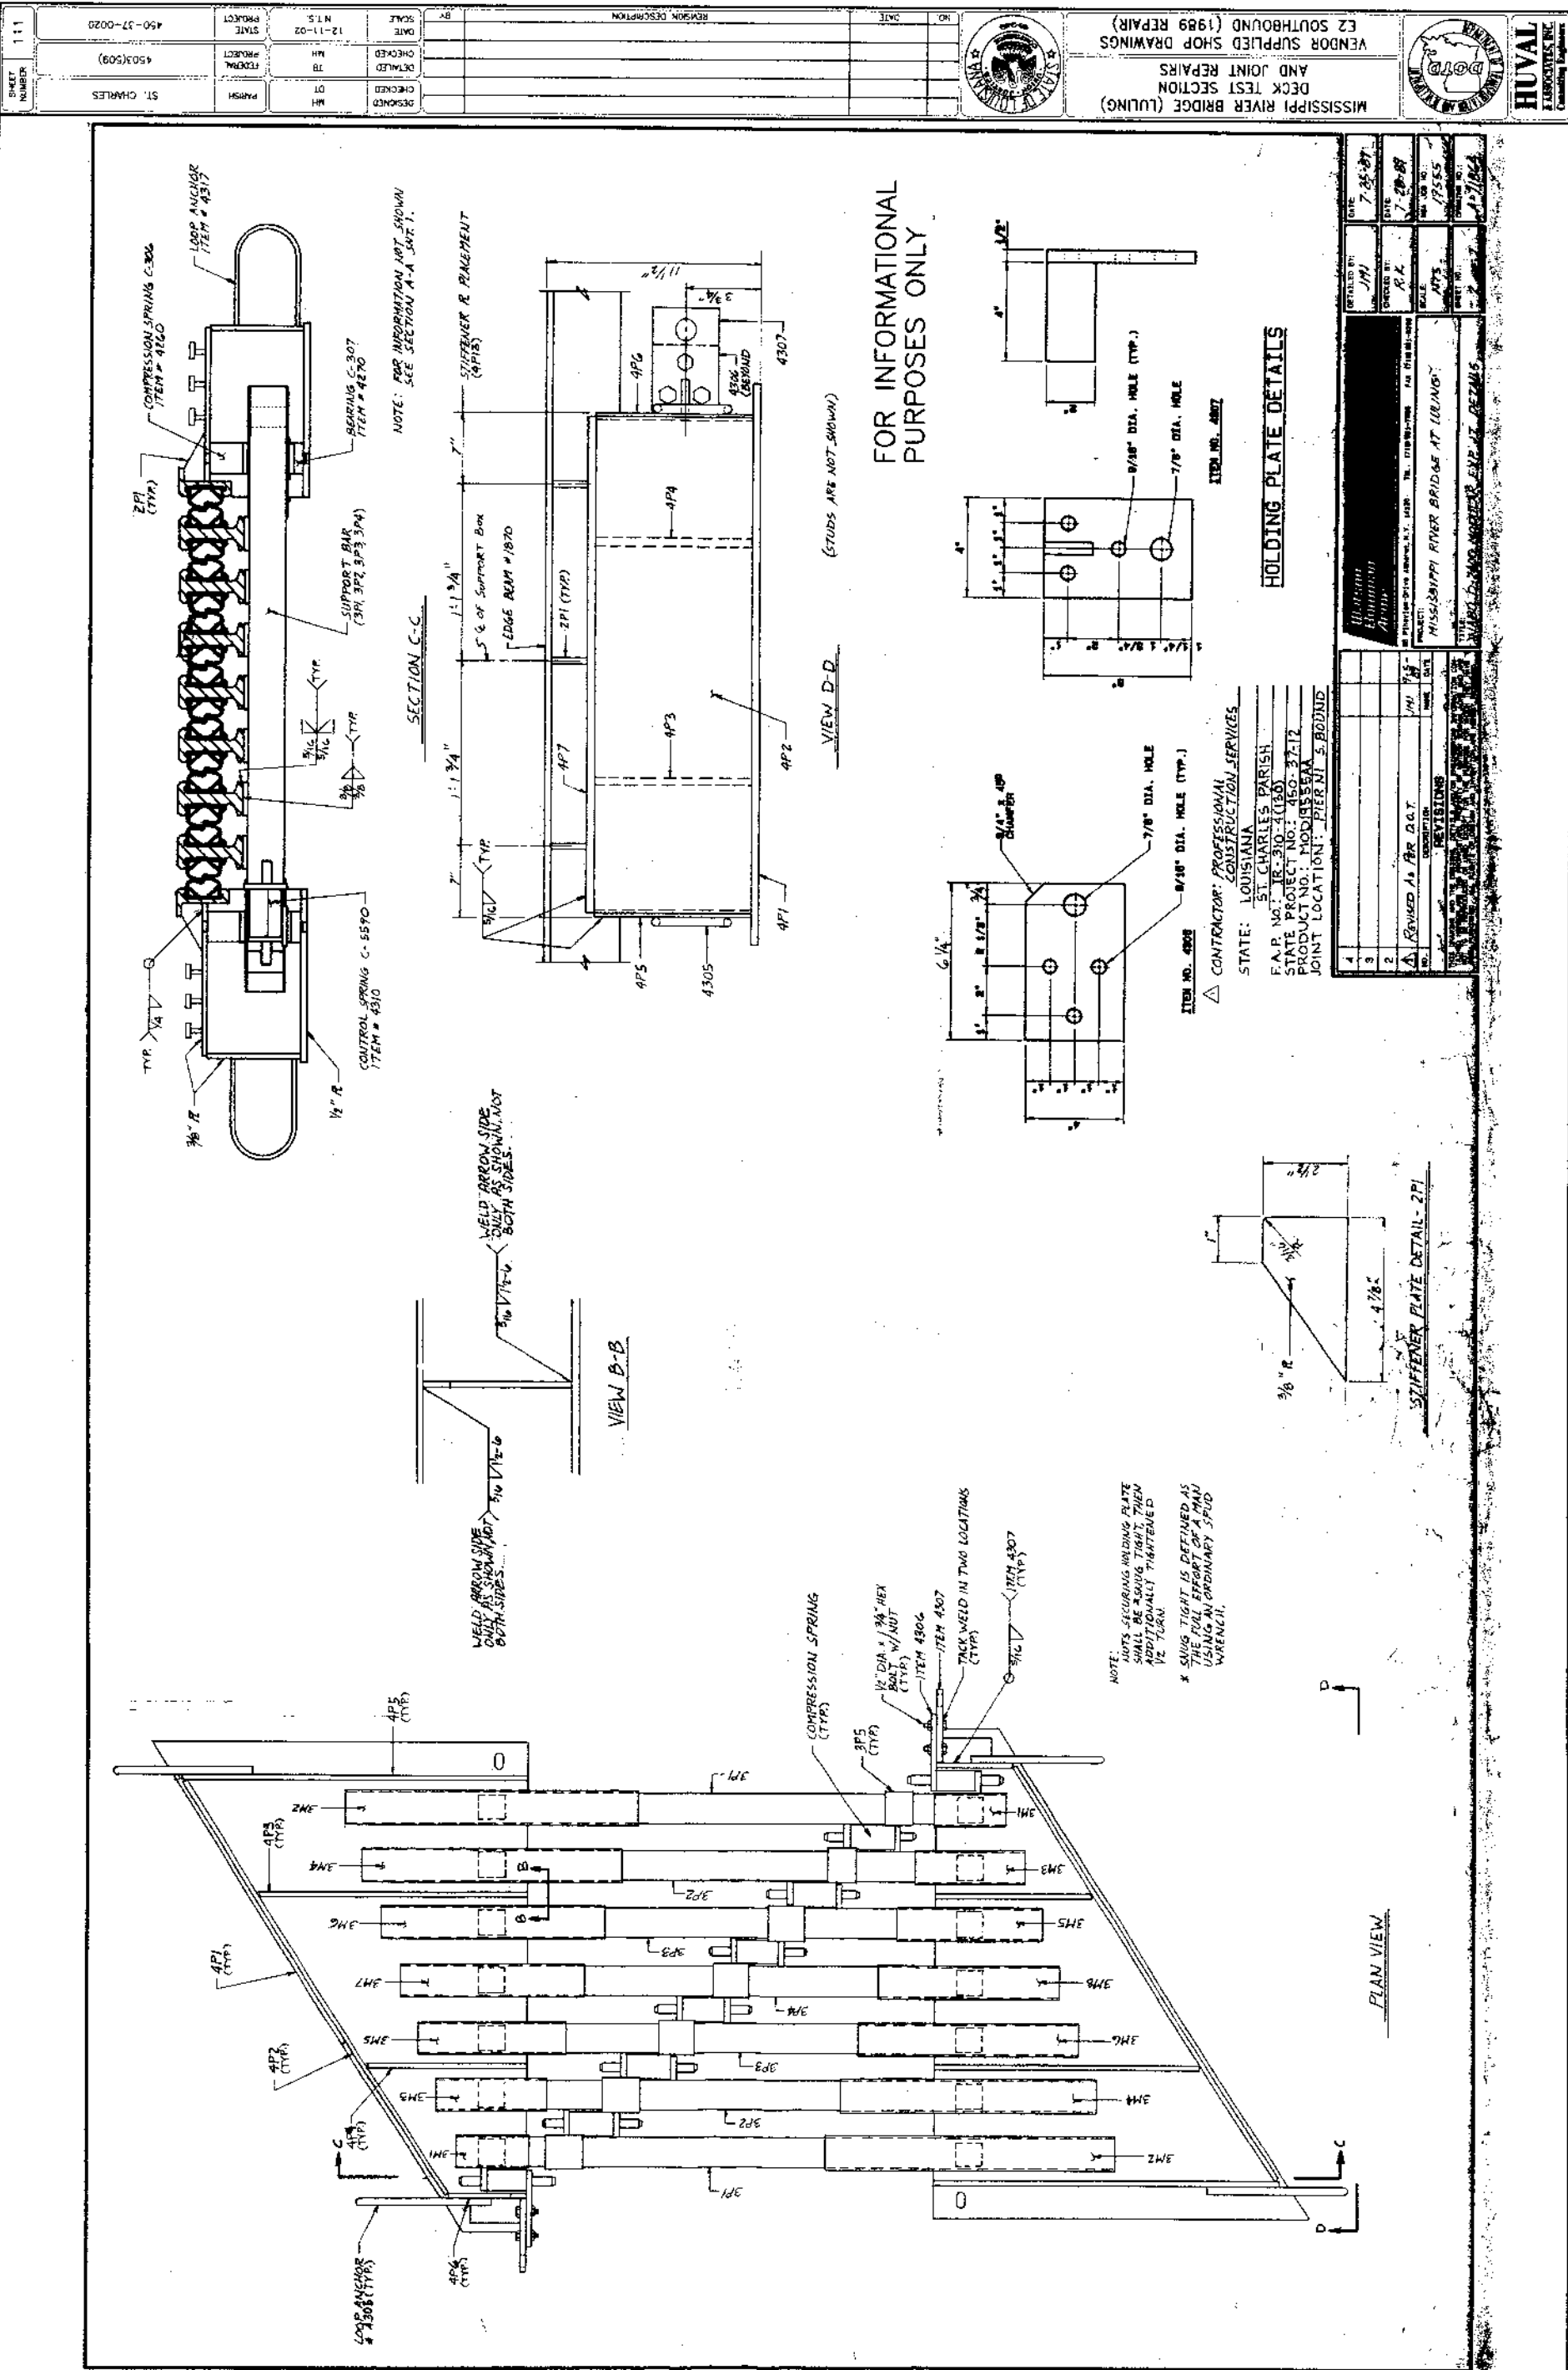

111	450-37-0020	4503(509)	ST. CHARLES	12-11-02	12-11-02	450-37-0020
NO.	DATE	REVISION DESCRIPTION	BY	DATE	NO.	DATE
1					1	
2					2	
3					3	
100					100	

MISSISSIPPI RIVER BRIDGE (LULUNG)
DECK TEST SECTION
AND JOINT REPAIRS
VENDOR SUPPLIED SHOP DRAWINGS
E2 SOUTHBOUND (1989 REPAIR)

ST. CHARLES
12-11-02
12-11-02
450-37-0020

111
4503(509)
ST. CHARLES


DESIGNED	MT	PARISH	ST. CHARLES
CHECKED	JT		
DETAILS	TR		
SCALE	N.T.S.	PROJECT	4503(509)
DATE	12-11-02	STATE	450-37-0020
BY			
REVISION DESCRIPTION			
DATE			
NO			



MISSISSIPPI RIVER BRIDGE (LULING)
DECK TEST SECTION
AND JOINT REPAIRS
VENDOR SUPPLIED SHOP DRAWINGS
E2 SOUTHBOUND (1989 REPAIR)



HUVAL
ENGINEERS
CONSULTING ENGINEERS

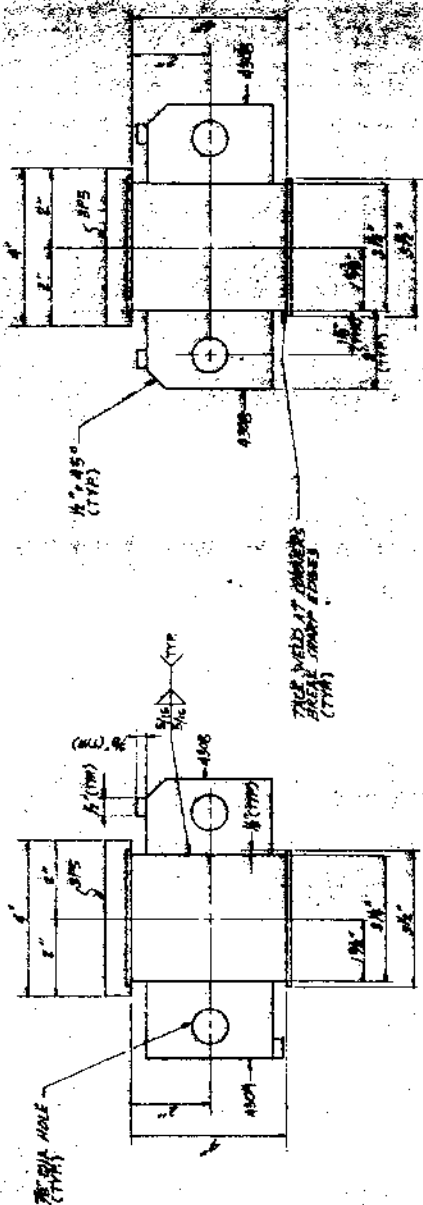


VIEW E-E



VIEW E-E

* FABRICATOR NOTE:
HOLDING OF THIS DIMENSION IS CRITICAL
ADDITIONAL TOLERANCE BUILT UP SHALL
BE DEALT WITH BY SAVING INCREMENTS
OFF PLATE 3/8"


FOR INFORMATIONAL
PURPOSES ONLY









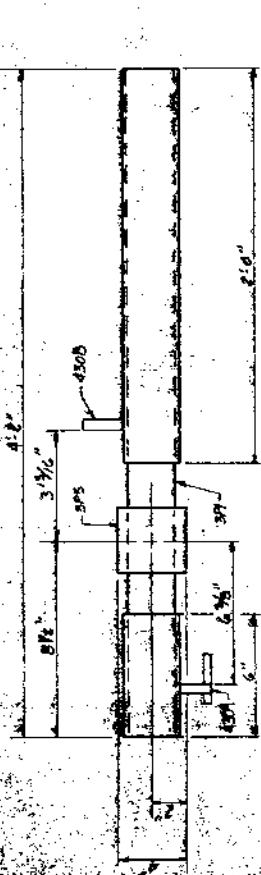


EXTERIOR SUPPORT BAR DETAIL - 301

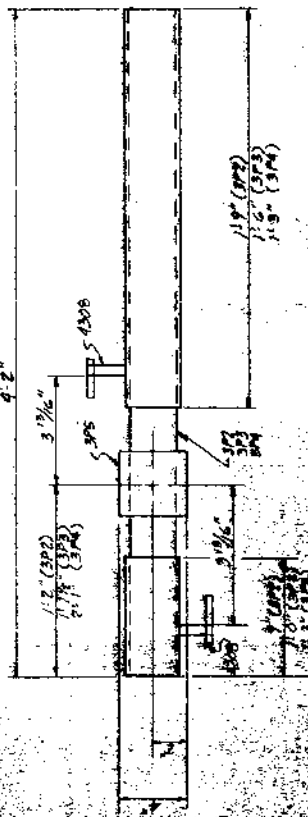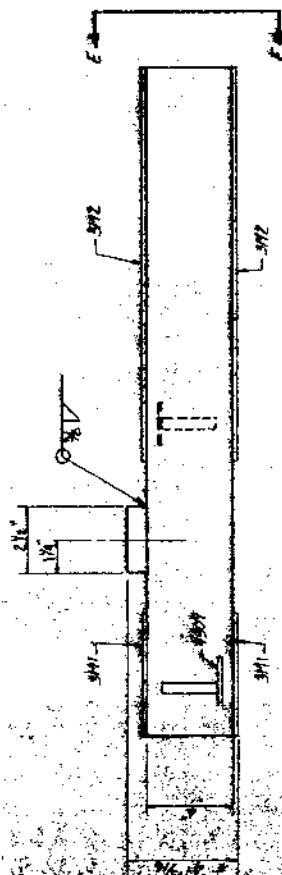

INTERIOR SUPPORT BAR DETAIL - 302

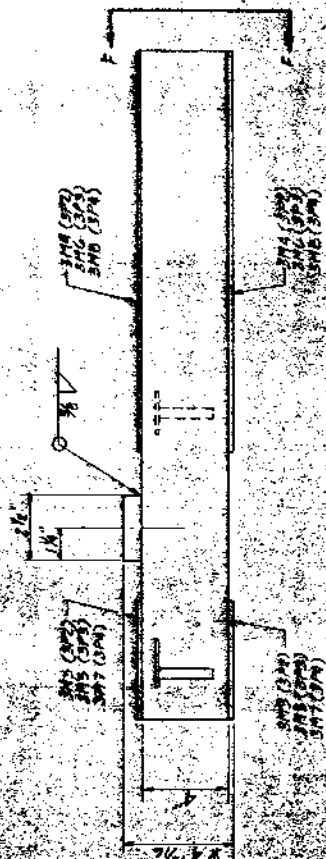

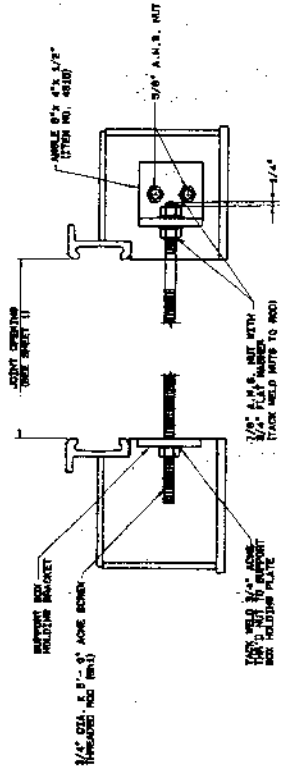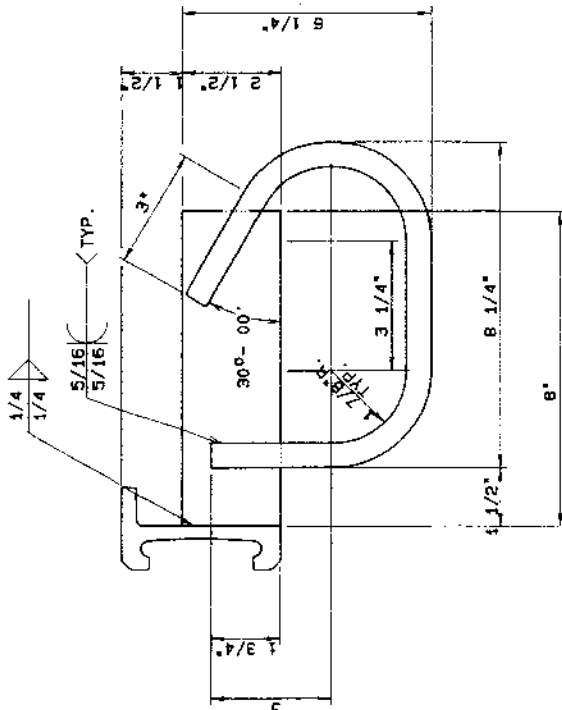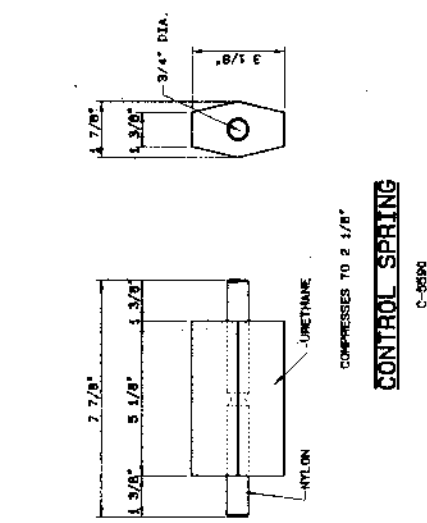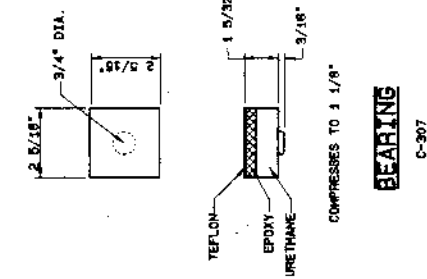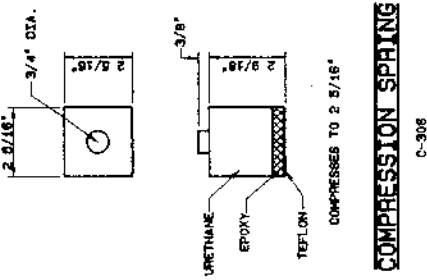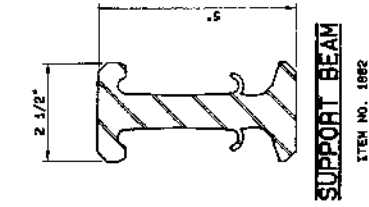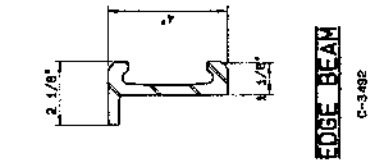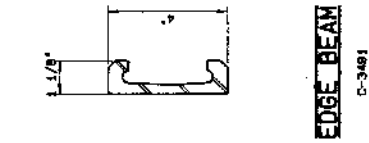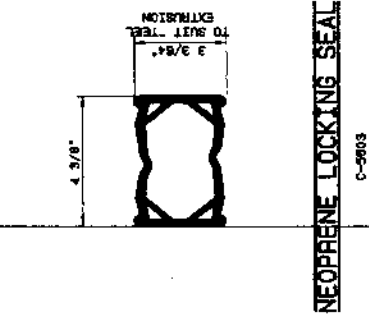

FOR INFORMATIONAL
PURPOSES ONLY

PRESTRESS DEVICE ASSEMBLY

NOTE

1. PRESSURE DEVICES SHALL BE LOCATED AT EVERY SUPPORT BOO.
2. THE PRESSURE DEVICE IS THE PROPERTY OF THE MANUFACTURER, AND IT IS TO BE RETURNED TO SUCH UPON COMPLETION OF INSTALLATION.
3. PRESSURE DEVICES SHALL BE SHIP INSTALLED.
4. MANUFACTURER SHALL OIL AND/OR GREASE BOO TO PREVENT CORROSION AND STAINING OF PAINTED EXPANSION JOINT SYSTEM.


CONTRACTOR: PROFESSIONAL
CONSTRUCTION SERVICES
STATE: LOUISIANA
ST. CHARLES PARISH
F.A.P. NO.: IR-310-4(130)
STATE PROJECT NO.: 450-37-12
PRODUCT NO.: MOD1555AA
JOINT LOCATION: PIER N. S. BOUND

[illegible]

ANCHOR ASSEMBLY DETAIL

ITEM NO. 4351
NTS

[illegible]



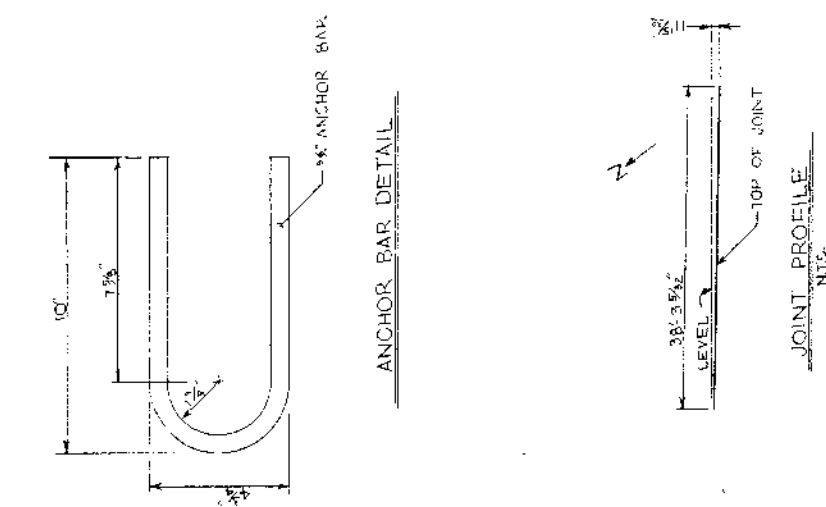


FOR INFORMATIONAL
PURPOSES ONLY

NOTES:	DO ALL CON ST TH PA BE HE CO IS THE SU OR AND	) 38 (B V
--------	--	--------------


CONTRACTOR: WILLIAMS BROTHERS CONST. CO
STATE: LOUISIANA PARISH: ST. CHARLES
PROJECT: # 450-31-02 - NMS/51PPI RIVER BR
TYPE: JOINT: WABO-MAURER D:2600
JOINT LOCATION: DIER LN-NB
PAYLENGTH: LUMF SUM

				120 Thompson Avenue, N. W. 19175	
		ASB. NO. 12-50-37-1		NOTED	
		DATE 1-30-74		DATE	
		CHECKED BY R.L.P.		NAME	
		DATE 1-30-74		DATE	
		DRAWN BY R.L.K.		NAME	
		DATE 1-30-74		DATE	
		CHECKED BY R.L.P.		NAME	
		DATE 1-30-74		DATE	
		DRAWN BY R.L.K.		NAME	
		DATE 1-30-74		DATE	
		CHECKED BY R.L.P			

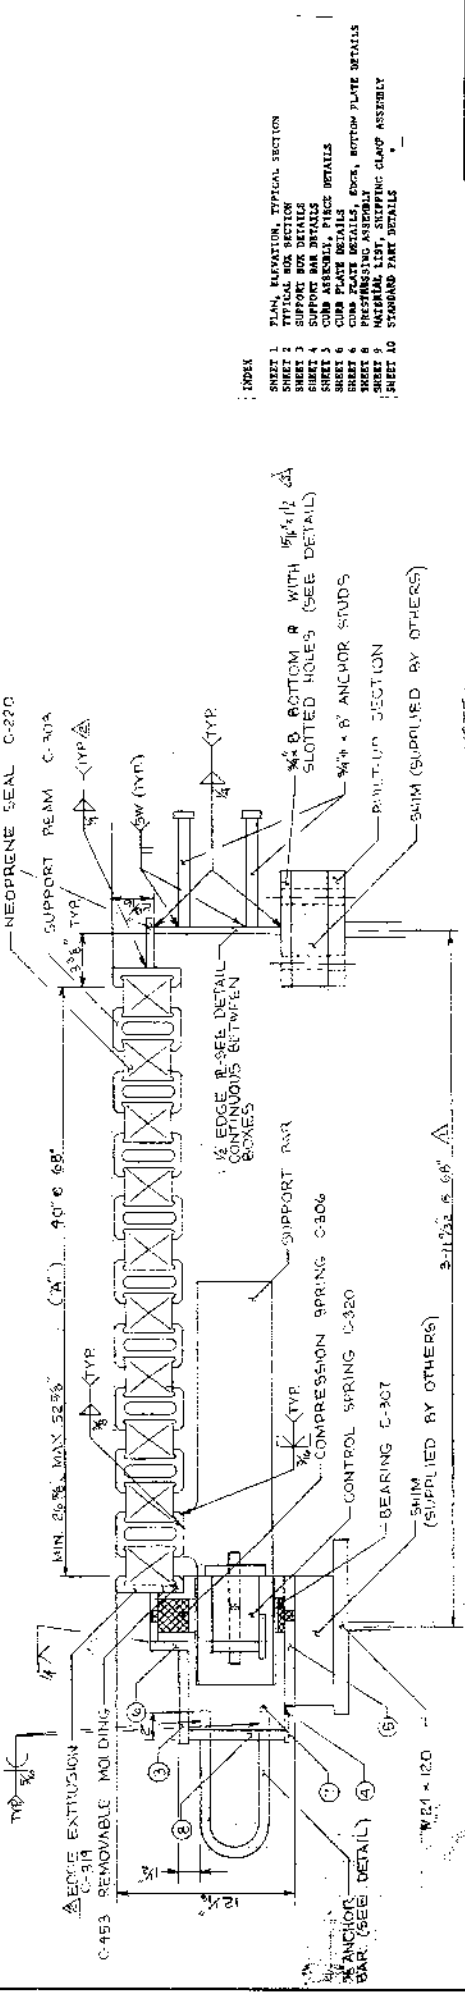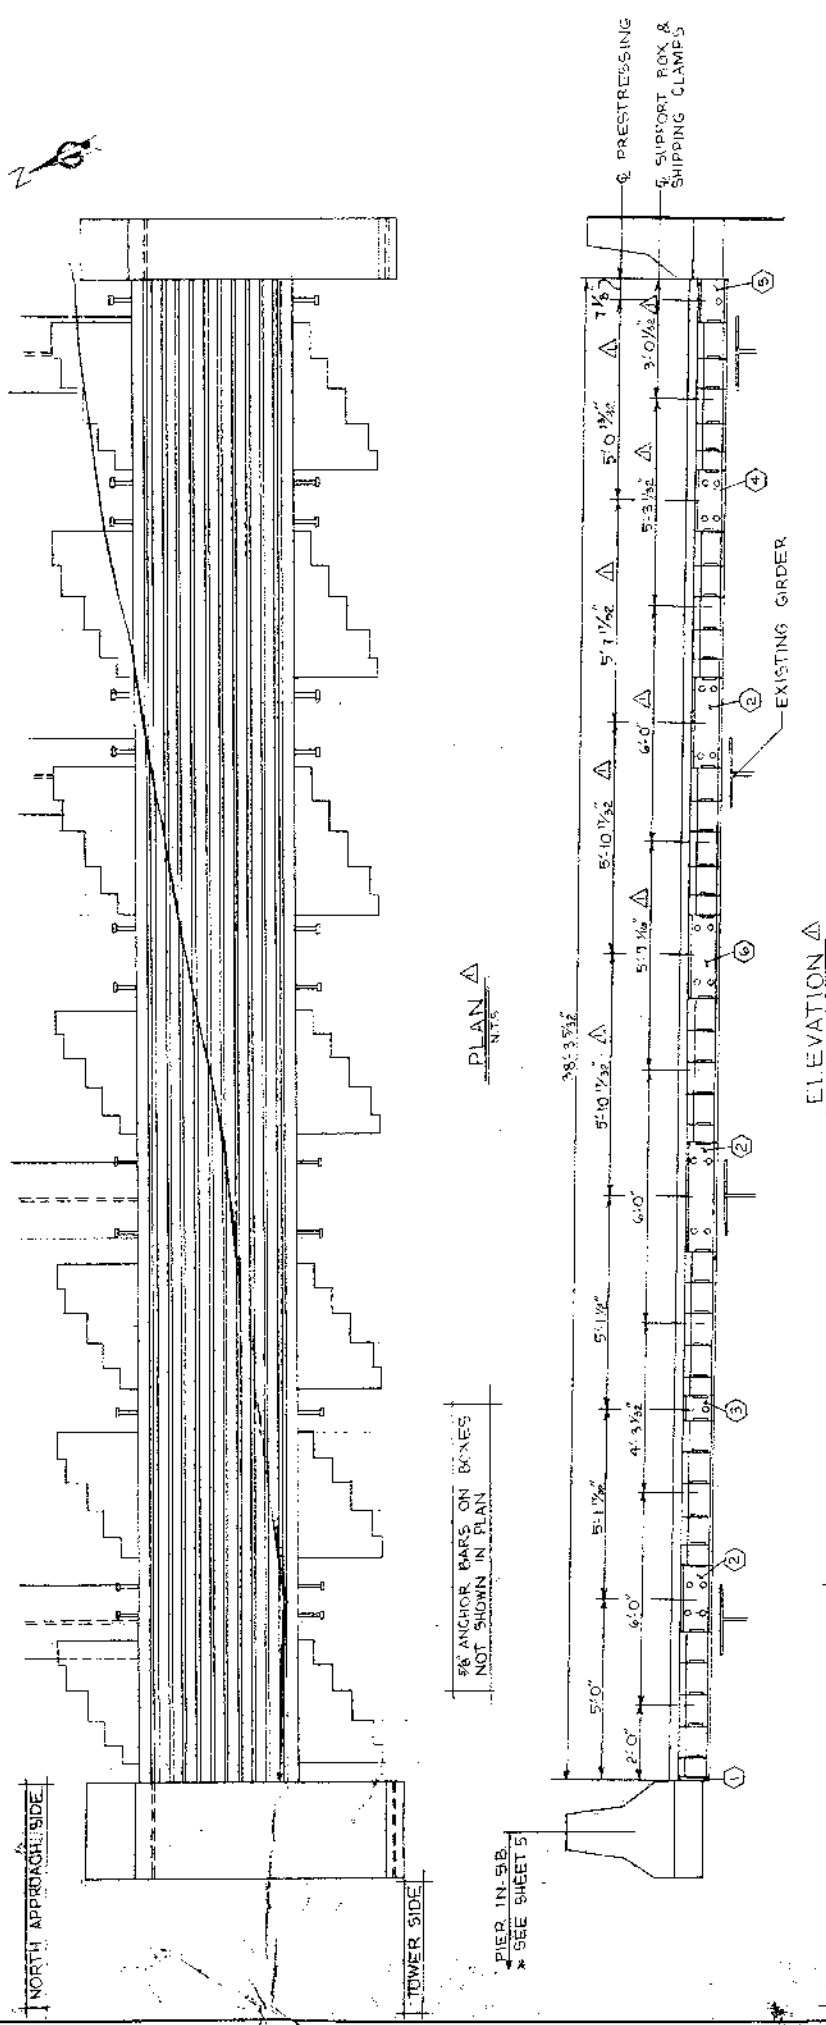 


NOTE: THE DESIGN OF THE TEMPERATURE CHART IS BASED ON A SPAN LENGTH OF 2200' AND A TEMPERATURE RANGE OF 20°F. THROUGH 120°F.

[illegible]

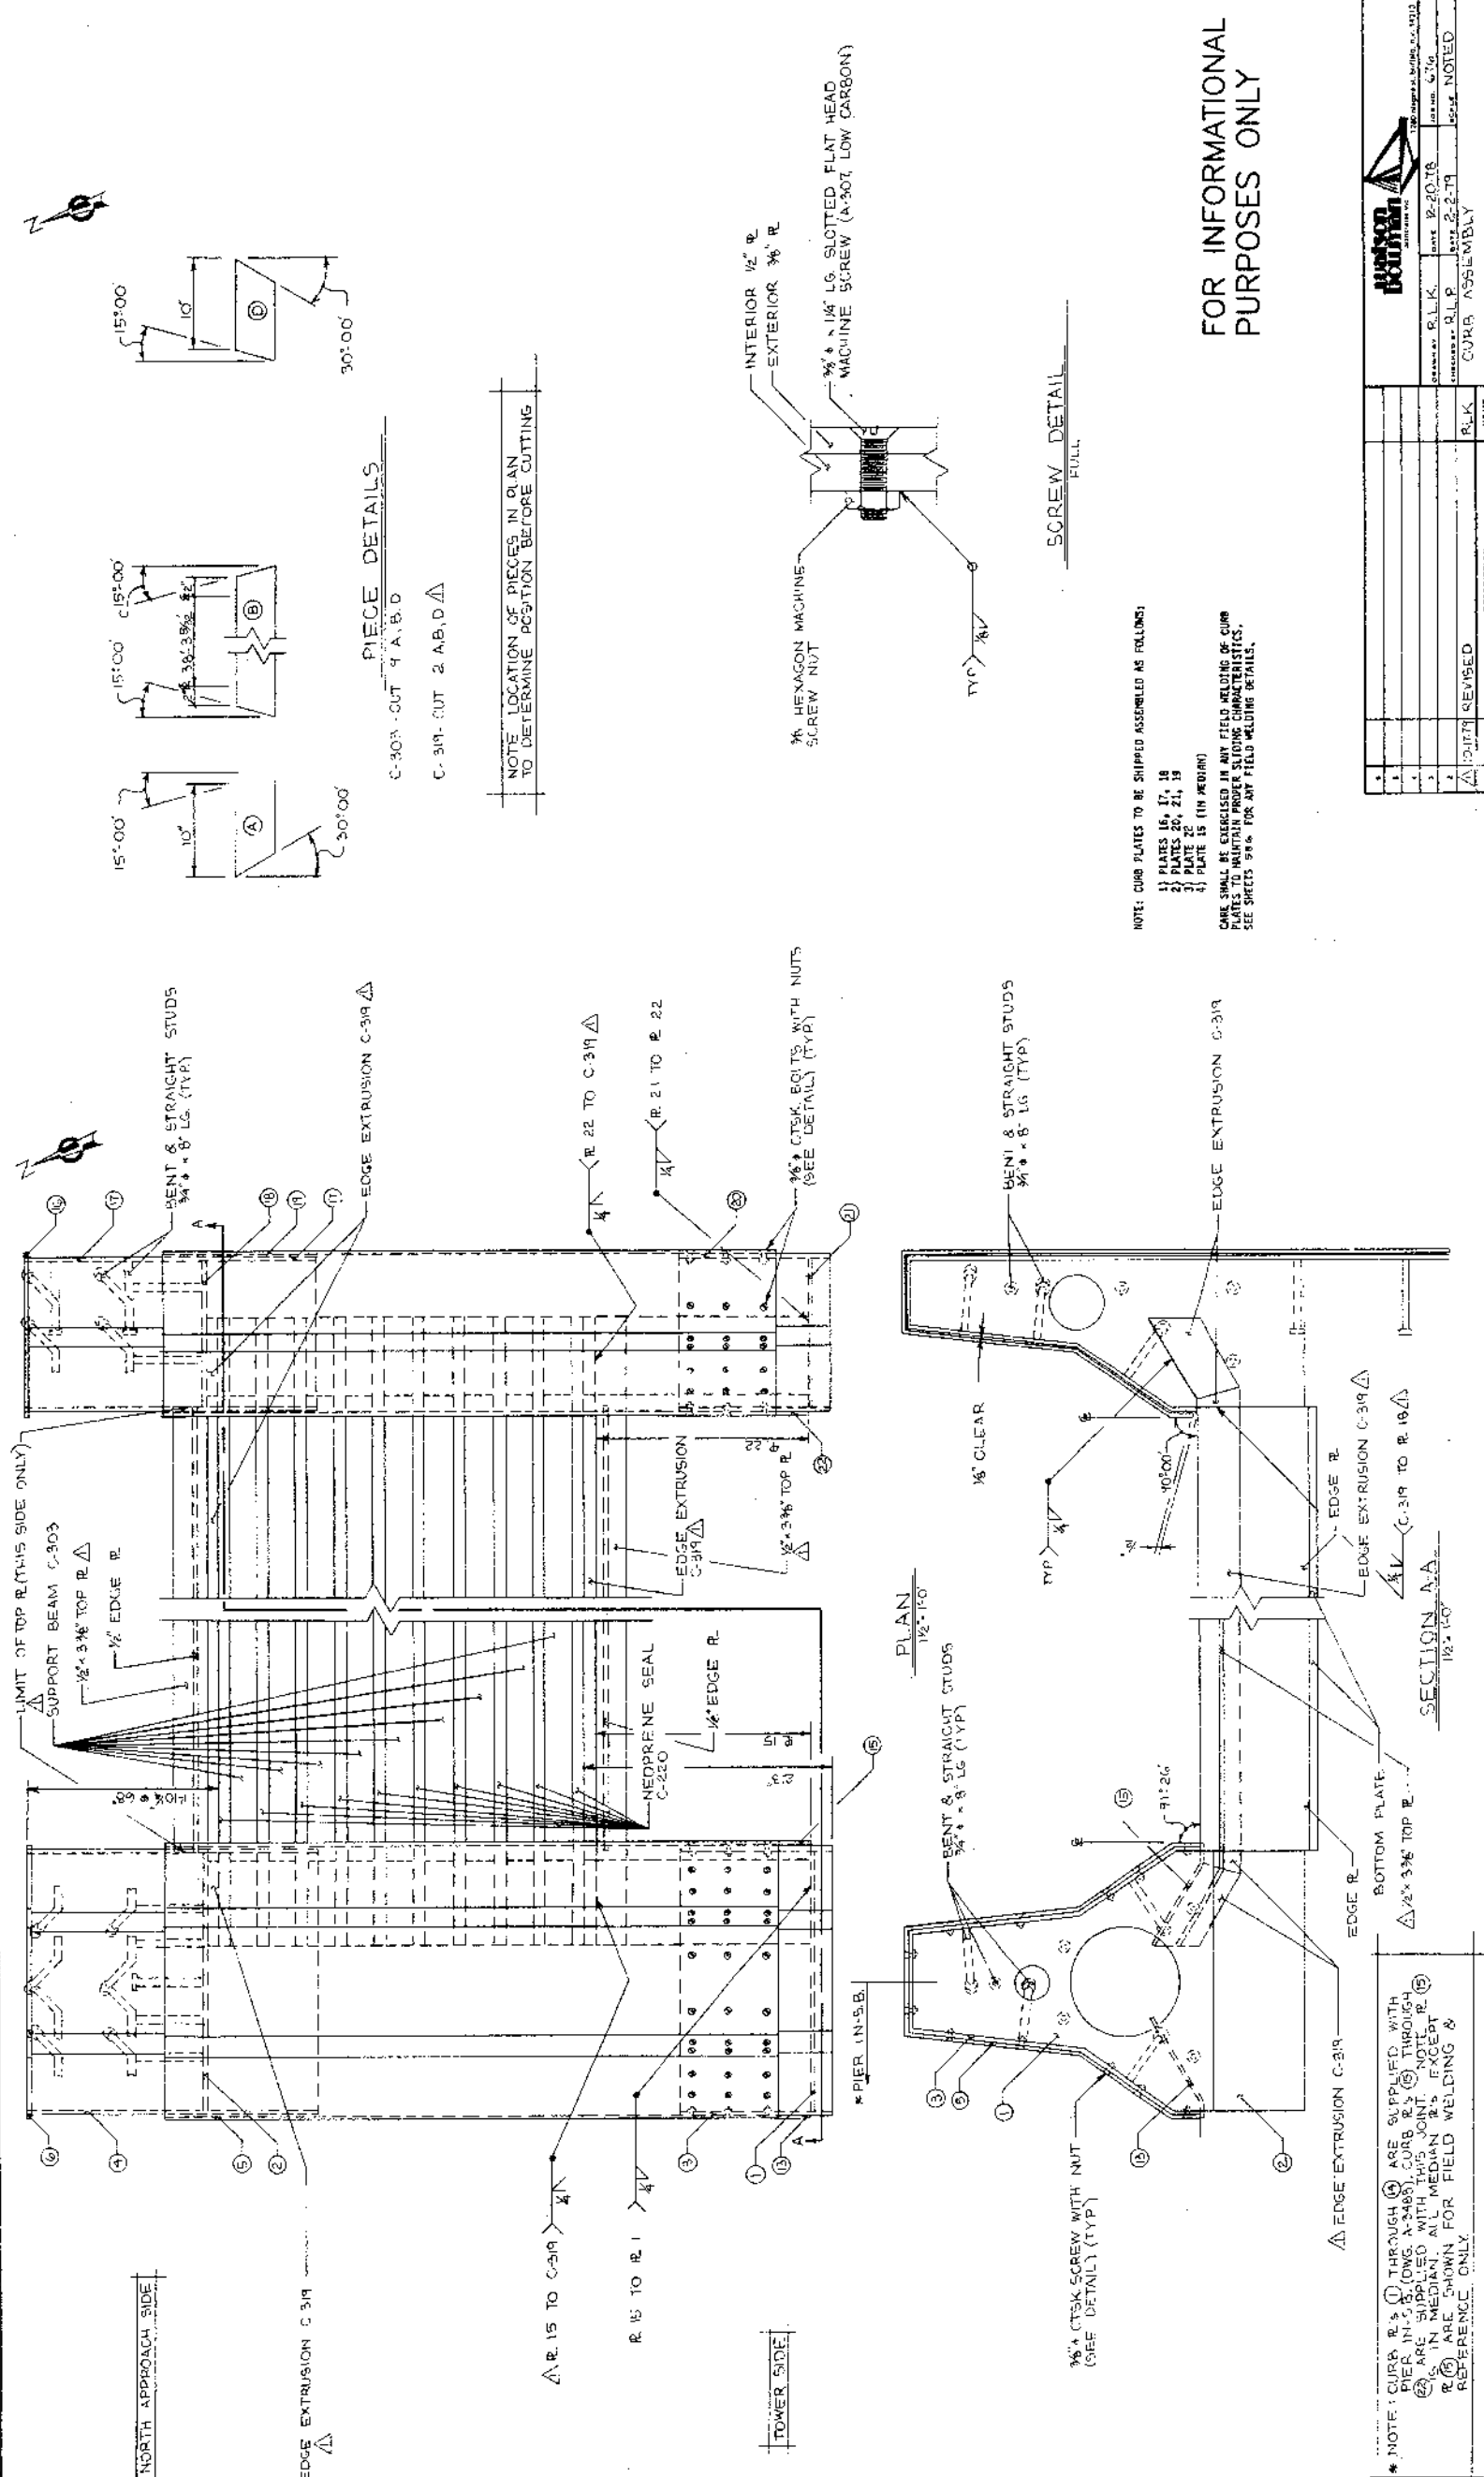

FOR INFORMATIONAL
PURPOSES ONLY

[illegible]






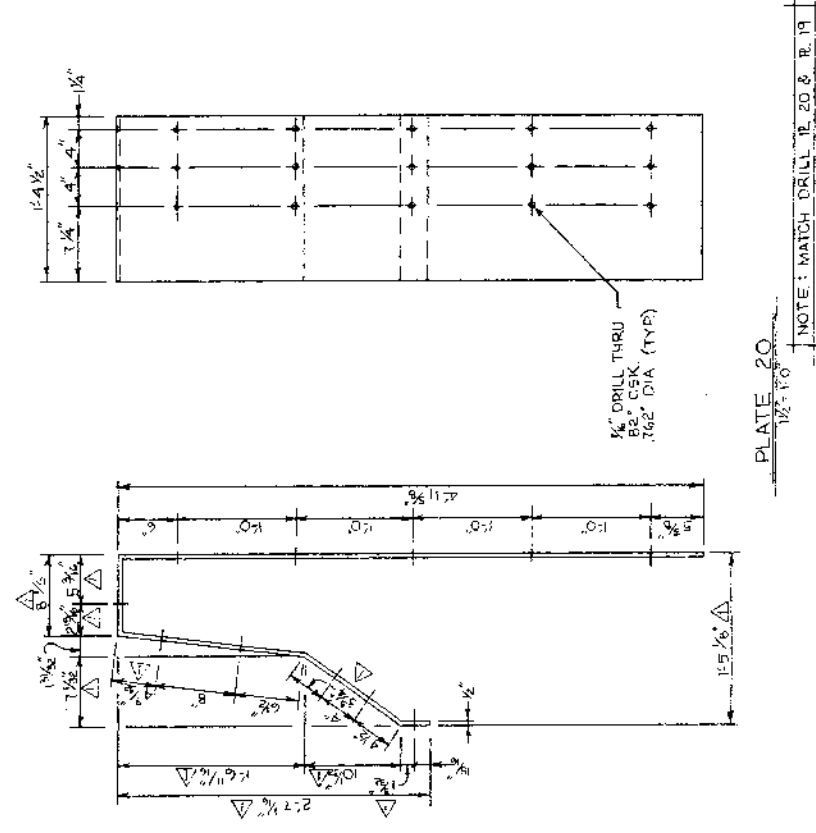


FOR INFORMATIONAL
PURPOSES ONLY


NOTE: GUESS PLATES TO BE SHIPPED ASSEMBLED AS FOLLOWS:

- 1) PLATES 16, 17, 18
- 2) PLATES 20, 21, 19
- 3) PLATE 22
- 4) PLATE 15 (IN MIDDLE)

CARS SHALL BE EXERCISED IN ANY FIELD WEARING OF GUMS
PLATES TO MAINTAIN PROPER SLIDING CHARACTERISTICS.
SEE SHEETS 2-5-6 FOR ANY FIELD WEARING DETAILS.

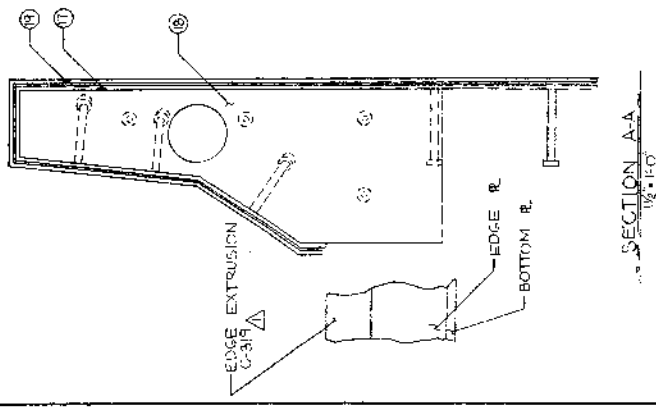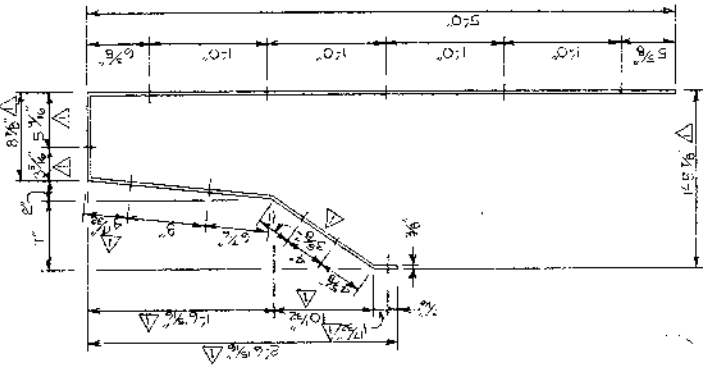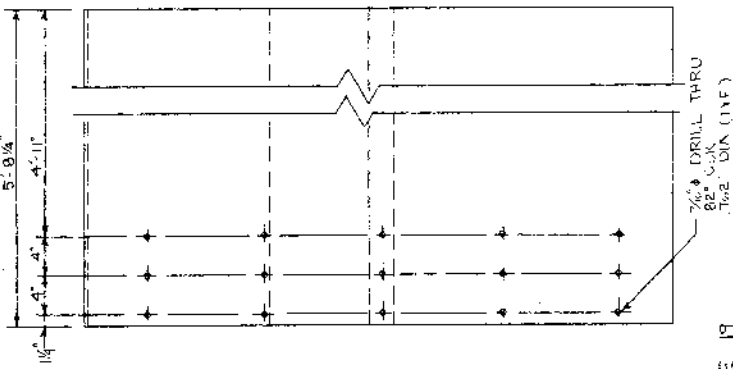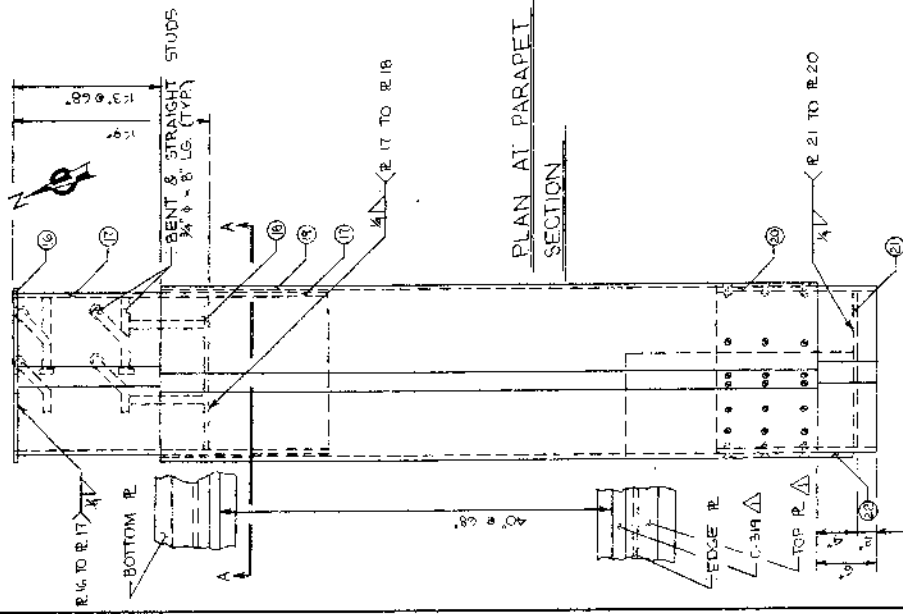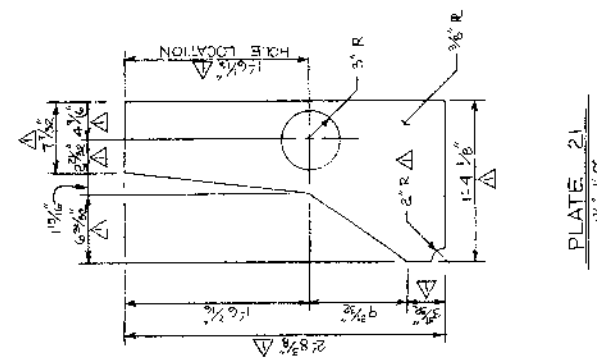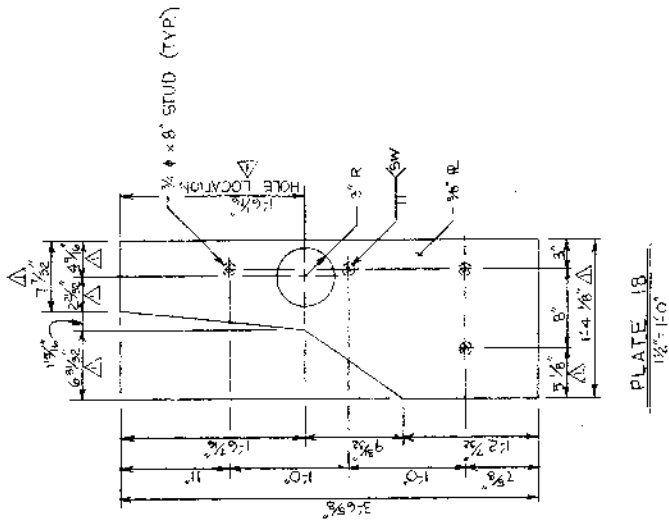
[illegible]

MATERIAL LIST			
ITEM	SIZE	QUANTITY	MATERIAL
TOP B	1/2" x 3/8" x 4'-0"	2	A-242
SUPPORT BEAM C-303	4'-0"	9	NEOPRENE
NEOPRENE SEAL C-220	2 1/2" x 2 1/2" x 2 1/2"	10	URETHANE
COMPRESSION SPRING C-306	2 1/2" x 2 1/2" x 1 1/2"	126	URETHANE
BEARING C-307	1 1/2" x 3/8" x 1 1/2"	70	URETHANE
CONTROL SPRING C-320	1 1/2" x 3/8" x 1 1/2"	14	PI 8931C
REMOVABLE MOLDING C-453	1 1/2" x 1 1/2" x 1 1/2"	2	A-242
EDGE ANGLE C-314	4'-0"	14	A-588
PLATE 3	1/2" x 4 1/2" x 24 1/2"	14	A-588
PLATE 4	3/8" x 4 1/2" x 20 1/2"	14	A-588
PLATE 5	3/8" x 4 1/2" x 9"	14	A-588
PLATE 6	1/2" x 4 1/2" x 2"	14	A-588
PLATE 7A	1/2" x 6 1/2" x 10 1/2"	14	A-588
PLATE 7B	1/2" x 8 1/2" x 16 1/2"	14	A-588
PLATE 7C	1/2" x 8 1/2" x 21 1/2"	14	A-588
PLATE 7D	1/2" x 8 1/2" x 26 1/2"	14	A-588
PLATE 7E	1/2" x 8 1/2" x 29 1/2"	28	A-588
PLATE 8A	1/2" x 6 1/2" x 5 1/2"	14	A-588
PLATE 8B	1/2" x 6 1/2" x 8 1/2"	42	A-588
PLATE 8C	1/2" x 6 1/2" x 10"	14	A-588
HOLDING PLATE 1	3/4" x 4" x 6 1/4"	14	A-588
HOLDING PLATE 2	3/4" x 2" x 4"	14	A-588
STIFFENER PLATE	5/8" x 1/2" x 15 3/4"	84	A-615
ANCHOR BAR	2 1/2" x 5 1/2" x 6 1/2"	14	A-588
SUPPORT BAR A	2 1/2" x 5 1/2" x 6 1/2"	14	A-588
SUPPORT BAR B	2 1/2" x 5 1/2" x 6 1/2"	14	A-588
SUPPORT BAR C	2 1/2" x 5 1/2" x 6 1/2"	14	A-588
SUPPORT BAR D	2 1/2" x 5 1/2" x 6 1/2"	14	A-588
SUPPORT BAR E	2 1/2" x 5 1/2" x 6 1/2"	14	A-588
STAINLESS STEEL	12 GAUGE - 2 1/2" WIDE	18 343.0'	TYPE 304-28 FIN
STOP R	1 1/2" x 1 1/2" x 1 1/2"	14	A-588
HOLDING R	3/4" x 1 1/2" x 3 1/4"	126	A-588
CURB PLATES			
PLATE 15 (IN MEDIAN)	3/8" x 10" x 11 1/2"	1	A-588
PLATE 16	1/2" x 1/2" x 6'-6 1/2"	1	A-588
PLATE 17	3/8" x 8'-4 1/2" x 2'-8"	1	A-588
PLATE 18	3/8" x 14'-1 1/2" x 3'-6 1/2"	1	A-588
PLATE 19	3/8" x 5'-4 1/2" x 8'-6 1/2"	1	A-588
PLATE 20	3/8" x 14'-1 1/2" x 8'-5 1/2"	1	A-588
PLATE 21	3/8" x 14'-7 1/2" x 2'-5 1/2"	1	A-588
PLATE 22	3/4" x 10" x 11 1/2"	1	A-588
BENT ANCHOR STUD	3/4" x 8" LG	6	A-108
STRAIGHT ANCHOR STUD	3/4" x 1 1/2" LG	50	A-108
SLOTTED FLATHEAD MACHINE SCREW	3/8" x 1 1/2" LG	33	A-325
HEXAGON MACHINE SCREW NUT	3/8"	33	A-325
EDGE PLATE 1	1/2" x 8 1/2" x 21 1/2"	2	A-588
EDGE PLATE 2	1/2" x 8 1/2" x 3 1/2"	2	A-588
EDGE PLATE 3	1/2" x 8 1/2" x 24 1/2"	6	A-588
EDGE PLATE 4	1/2" x 8 1/2" x 7 1/2"	2	A-588
EDGE PLATE 5	1/2" x 8 1/2" x 17 1/2"	2	A-588
EDGE PLATE 6	1/2" x 8 1/2" x 13 1/2"	2	A-588
BOTTOM PLATE 1	3/4" x 8" x 24"	2	A-588
BOTTOM PLATE 2	3/4" x 8" x 24"	6	A-588
BOTTOM PLATE 3	3/4" x 8" x 17 1/2"	2	A-588
BOTTOM PLATE 4	3/4" x 8" x 12 1/2"	2	A-588
BOTTOM PLATE 5	3/4" x 8" x 12 1/2"	2	A-588
BOTTOM PLATE 6	3/4" x 8" x 21 1/2"	2	A-588
BONULASTIC ADHESIVE	1 GALLON	2	NEOPRENE
NEOPRENE SHEET	1/8" x 4' x 3'	20	AS REQ'D
PAINT (ORGANIC ZINC PRIMER)	20 GRAM BOTTLE	1	AS PER SPEC.
ARON-ALPHA ADHESIVE	20 GRAM BOTTLE	1	AS PER SPEC.
SHIPPING CLAMP ASSEMBLY			
PLATE	1/2" x 1 1/2" x 3 1/2"	14	
AM STD HEX BOLT	3/4" x 2 1/2" LG	14	
AM STD HEX NUT	3/4"	14	
FLAT WASHER	3/4"	28	
PRESTRESSING ASSEMBLY			
PLATE A	3/8" x 5" x 7"	28	
PLATE B	3/8" x 5" x 11"	14	
PLATE C	1/2" x 3" x 4"	14	
HEX NUT	1"	42	
FLAT WASHER	1"	28	
THREADED ROD	1/2" x 25" LG	14	

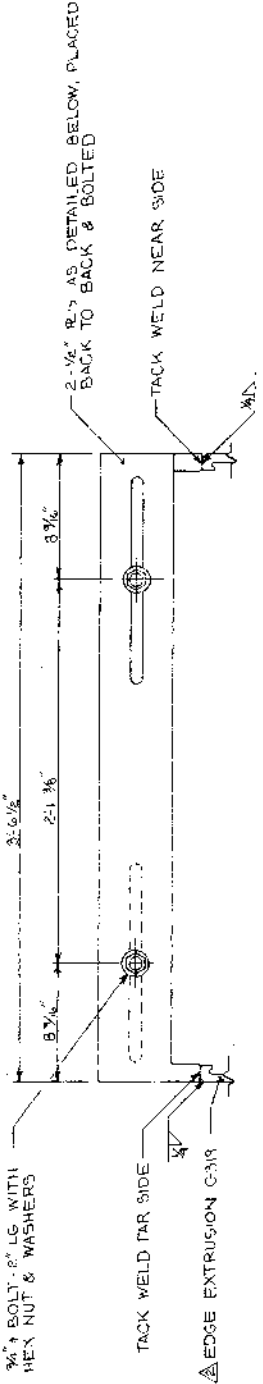


NOTE: EACH SHIPPING CLAMP ASSEMBLY INCLUDES:
1. 2 1/2" R's AS DETAILED BELOW, PLACED BACK TO BACK & BOLTED
2. 1/4" x 8" LG WITH HEX NUT & WASHERS
3. 1/4" x 8" LG WITH HEX NUT & WASHERS
4. 1/4" FLAT WASHERS

SHIPPING CLAMP

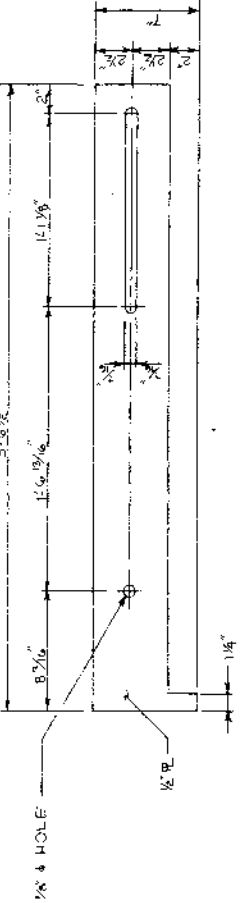

SHIPPING CLAMP DETAIL (LOCATIONS SHOWN ON SHEET 1)

2 REQ'D / ASSEMBLY

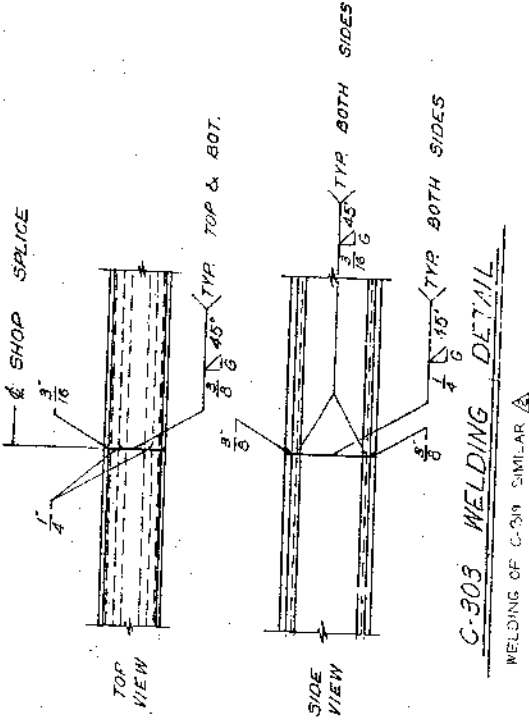


FOR INFORMATIONAL PURPOSES ONLY


C-303 WELDING DETAIL

WELDING OF C-319 SIMILAR



REVISIONS		SHEET 9 OF 10	
NO	DATE	DESCRIPTION	NAME
1			
2			
3			
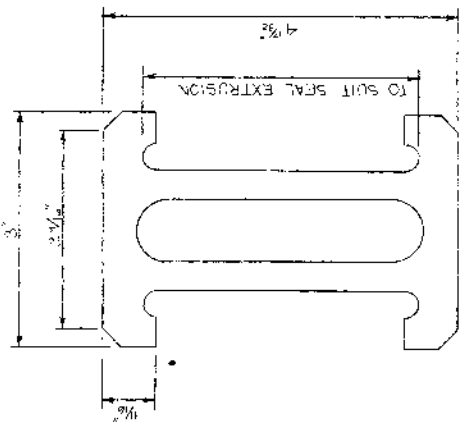


SUPPORT BEAM
C-303

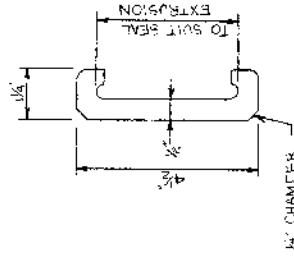


14. CHAPTER 14
EDGE EXTRUSION (C-319)

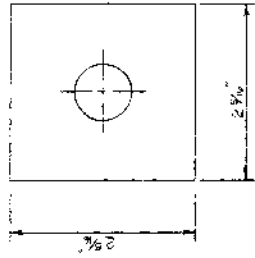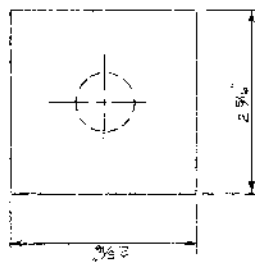


COMPLETION SPRING
0 30.0

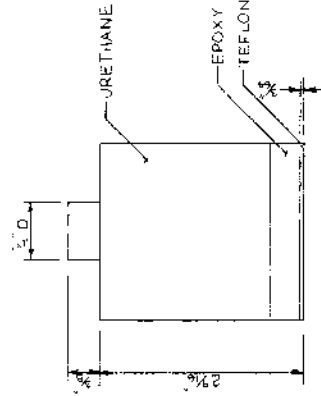


BEARING
C-307

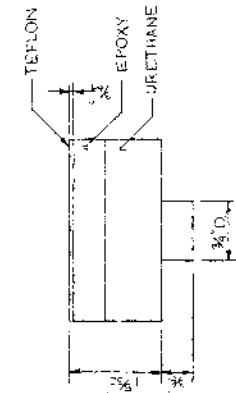


PLASTIC MOLDING

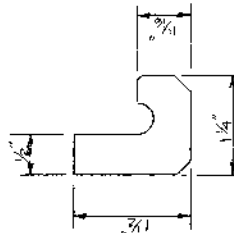

NEOPRENE LOCKING SEAL
C-220

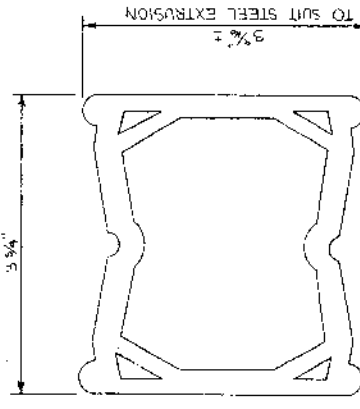

CONTROL SPRING

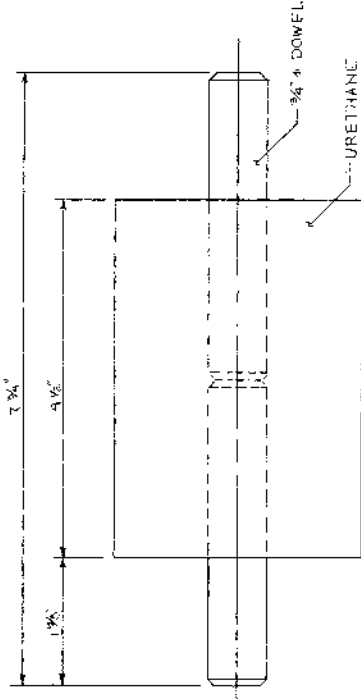

FOR INFORMATIONAL
PURPOSES ONLY

NO. DATE		REVISIONS		SHEET 10 OF 10		DRAWING NUMBER A-3489	
10-537		REVISED/STATE (ELIMINATE C-24)		PLK		WABO-MAURER COMPONENTS	
DESCRIPTION		NAME		DATE		NOTES	
1				12-30-78		676	
2							
3							
4							
5							
6							
				DRAWING NO. 10-537, DATED 12-30-78 DRAWN BY R.L.K. DATE 12-30-78 CHECKED BY R.L.P. DATE 3-7-79 SCALE 1"=1'-0"			

PLASTIC MOLDING INSTALLATION DETAIL